

HISTORIC AND DESIGN REVIEW COMMISSION

September 20, 2023

HDRC CASE NO: 2023-363
ADDRESS: 820 N ALAMO ST
LEGAL DESCRIPTION: NCB 452 BLK 30 LOT 6
ZONING: FBZ T4-2, HL
CITY COUNCIL DIST.: 1
APPLICANT: Kent Brittain/Above Ground Design, PLLC
OWNER: Nick Marquez/BAR HOUSE LLC
TYPE OF WORK: Amendment to previously-approved design for rear addition
APPLICATION RECEIVED: September 01, 2023
60-DAY REVIEW: October 31, 2023
CASE MANAGER: Jessica Anderson
REQUEST:

The applicant is requesting an amendment to a Certificate of Appropriateness to include removal of the rear, historic two-story mass with construction of the approved three-story addition. Retention of the two-story mass was previously consented to in error.

APPLICABLE CITATIONS:

Unified Development Code Chapter 35, Article VI, Section 35-608

- (g) Subsequent Applications. In the case of disapproval of an application, a new application for the same work shall not be resubmitted for consideration until one (1) year has elapsed from the date of disapproval. The commission, by a majority of its membership, may waive the aforementioned time limitation if the application presents substantial new evidence that was not considered in the previous action, or incorporates changes based on the previous recommendations of the commission. Until such waiver is granted, a new application shall not be considered complete and is not subject to the review periods outlined in subsection f. If a motion to approve such a waiver fails to receive the requisite number of votes, the application shall be considered disapproved; a revised application may be submitted in accordance with this section.

Historic Design Guidelines, Chapter 2, Guidelines for Exterior Maintenance and Alterations

1. Materials: Woodwork

A. MAINTENANCE (PRESERVATION)

- i. *Inspections*—Conduct semi-annual inspections of all exterior wood elements to verify condition and determine maintenance needs.
- ii. *Cleaning*—Clean exterior surfaces annually with mild household cleaners and water. Avoid using high pressure power washing and any abrasive cleaning or stripping methods that can damage the historic wood siding and detailing.
- iii. *Paint preparation*—Remove peeling, flaking, or failing paint surfaces from historic woodwork using the gentlest means possible to protect the integrity of the historic wood surface. Acceptable methods for paint removal include scraping and sanding, thermal removal, and when necessary, mild chemical strippers. Sand blasting and water blasting should never be used to remove paint from any surface. Sand only to the next sound level of paint, not all the way to the wood, and address any moisture and deterioration issues before repainting.
- iv. *Repainting*—Paint once the surface is clean and dry using a paint type that will adhere to the surface properly. See *General Paint Type Recommendations* in Preservation Brief #10 listed under Additional Resources for more information.
- v. *Repair*—Repair deteriorated areas or refasten loose elements with an exterior wood filler, epoxy, or glue.

B. ALTERATIONS (REHABILITATION, RESTORATION, AND RECONSTRUCTION)

- i. *Facade materials*—Avoid removing materials that are in good condition or that can be repaired in place. Consider exposing original wood siding if it is currently covered with vinyl or aluminum siding, stucco, or other materials that have not achieved historic significance.

- ii. *Materials*—Use in-kind materials when possible or materials similar in size, scale, and character when exterior woodwork is beyond repair. Ensure replacement siding is installed to match the original pattern, including exposures. Do not introduce modern materials that can accelerate and hide deterioration of historic materials. Hardboard and other cementitious materials are not recommended.
- iii. *Replacement elements*—Replace wood elements in-kind as a replacement for existing wood siding, matching in profile, dimensions, material, and finish, when beyond repair.

3. Materials: Roofs

A. MAINTENANCE (PRESERVATION)

- i. *Regular maintenance and cleaning*—Avoid the build-up of accumulated dirt and retained moisture. This can lead to the growth of moss and other vegetation, which can lead to roof damage. Check roof surface for breaks or holes and flashing for open seams and repair as needed.

B. ALTERATIONS (REHABILITATION, RESTORATION, AND RECONSTRUCTION)

- i. *Roof replacement*—Consider roof replacement when more than 25-30 percent of the roof area is damaged or 25-30 percent of the roof tiles (slate, clay tile, or cement) or shingles are missing or damaged.
- ii. *Roof form*—Preserve the original shape, line, pitch, and overhang of historic roofs when replacement is necessary.
- iii. *Roof features*—Preserve and repair distinctive roof features such as cornices, parapets, dormers, open eaves with exposed rafters and decorative or plain rafter tails, flared eaves or decorative purlins, and brackets with shaped ends.
- iv. *Materials: sloped roofs*—Replace roofing materials in-kind whenever possible when the roof must be replaced. Retain and re-use historic materials when large-scale replacement of roof materials other than asphalt shingles is required (e.g., slate or clay tiles). Salvaged materials should be re-used on roof forms that are most visible from the public right-of-way. Match new roofing materials to the original materials in terms of their scale, color, texture, profile, and style, or select materials consistent with the building style, when in-kind replacement is not possible.
- v. *Materials: flat roofs*—Allow use of contemporary roofing materials on flat or gently sloping roofs not visible from the public right-of-way.
- vi. *Materials: metal roofs*—Use metal roofs on structures that historically had a metal roof or where a metal roof is appropriate for the style or construction period. Refer to Checklist for Metal Roofs on page 10 for desired metal roof specifications when considering a new metal roof. New metal roofs that adhere to these guidelines can be approved administratively as long as documentation can be provided that shows that the home has historically had a metal roof.
- vii. *Roof vents*—Maintain existing historic roof vents. When deteriorated beyond repair, replace roof vents in-kind or with one similar in design and material to those historically used when in-kind replacement is not possible.

6. Architectural Features: Doors, Windows, and Screens

A. MAINTENANCE (PRESERVATION)

- i. *Openings*—Preserve existing window and door openings. Avoid enlarging or diminishing to fit stock sizes or air conditioning units. Avoid filling in historic door or window openings. Avoid creating new primary entrances or window openings on the primary façade or where visible from the public right-of-way.
- ii. *Doors*—Preserve historic doors including hardware, fanlights, sidelights, pilasters, and entablatures.
- iii. *Windows*—Preserve historic windows. When glass is broken, the color and clarity of replacement glass should match the original historic glass.
- iv. *Screens and shutters*—Preserve historic window screens and shutters.
- v. *Storm windows*—Install full-view storm windows on the interior of windows for improved energy efficiency. Storm window may be installed on the exterior so long as the visual impact is minimal and original architectural details are not obscured.

B. ALTERATIONS (REHABILITATION, RESTORATION, AND RECONSTRUCTION)

- i. *Doors*—Replace doors, hardware, fanlight, sidelights, pilasters, and entablatures in-kind when possible and when deteriorated beyond repair. When in-kind replacement is not feasible, ensure features match the size, material, and profile of the historic element.
- ii. *New entrances*—Ensure that new entrances, when necessary to comply with other regulations, are compatible in size, scale, shape, proportion, material, and massing with historic entrances.
- iii. *Glazed area*—Avoid installing interior floors or suspended ceilings that block the glazed area of historic windows.
- iv. *Window design*—Install new windows to match the historic or existing windows in terms of size, type, configuration, material, form, appearance, and detail when original windows are deteriorated beyond repair.

- v. *Muntins*—Use the exterior muntin pattern, profile, and size appropriate for the historic building when replacement windows are necessary. Do not use internal muntins sandwiched between layers of glass.
- vi. *Replacement glass*—Use clear glass when replacement glass is necessary. Do not use tinted glass, reflective glass, opaque glass, and other non-traditional glass types unless it was used historically. When established by the architectural style of the building, patterned, leaded, or colored glass can be used.
- vii. *Non-historic windows*—Replace non-historic incompatible windows with windows that are typical of the architectural style of the building.
- viii. *Security bars*—Install security bars only on the interior of windows and doors.
- ix. *Screens*—Utilize wood screen window frames matching in profile, size, and design of those historically found when the existing screens are deteriorated beyond repair. Ensure that the tint of replacement screens closely matches the original screens or those used historically.
- x. *Shutters*—Incorporate shutters only where they existed historically and where appropriate to the architectural style of the house. Shutters should match the height and width of the opening and be mounted to be operational or appear to be operational. Do not mount shutters directly onto any historic wall material.

7. Architectural Features: Porches, Balconies, and Porte-Cocheres

A. MAINTENANCE (PRESERVATION)

- i. *Existing porches, balconies, and porte-cocheres*—Preserve porches, balconies, and porte-cocheres. Do not add new porches, balconies, or porte-cocheres where not historically present.
- ii. *Balusters*—Preserve existing balusters. When replacement is necessary, replace in-kind when possible or with balusters that match the originals in terms of materials, spacing, profile, dimension, finish, and height of the railing.
- iii. *Floors*—Preserve original wood or concrete porch floors. Do not cover original porch floors of wood or concrete with carpet, tile, or other materials unless they were used historically.

B. ALTERATIONS (REHABILITATION, RESTORATION, AND RECONSTRUCTION)

- i. *Front porches*—Refrain from enclosing front porches. Approved screen panels should be simple in design as to not change the character of the structure or the historic fabric.
- ii. *Side and rear porches*—Refrain from enclosing side and rear porches, particularly when connected to the main porch or balcony. Original architectural details should not be obscured by any screening or enclosure materials. Alterations to side and rear porches should result in a space that functions, and is visually interpreted as, a porch.
- iii. *Replacement*—Replace in-kind porches, balconies, porte-cocheres, and related elements, such as ceilings, floors, and columns, when such features are deteriorated beyond repair. When in-kind replacement is not feasible, the design should be compatible in scale, massing, and detail while materials should match in color, texture, dimensions, and finish.
- iv. *Adding elements*—Design replacement elements, such as stairs, to be simple so as to not distract from the historic character of the building. Do not add new elements and details that create a false historic appearance.
- v. *Reconstruction*—Reconstruct porches, balconies, and porte-cocheres based on accurate evidence of the original, such as photographs. If no such evidence exists, the design should be based on the architectural style of the building and historic patterns.

Historic Design Guidelines, Chapter 3, Guidelines for Additions

1. Massing and Form of Residential Additions

A. GENERAL

- i. *Minimize visual impact*—Site residential additions at the side or rear of the building whenever possible to minimize views of the addition from the public right-of-way. An addition to the front of a building would be inappropriate.
- ii. *Historic context*—Design new residential additions to be in keeping with the existing, historic context of the block. For example, a large, two-story addition on a block comprised of single-story homes would not be appropriate.
- iii. *Similar roof form*—Utilize a similar roof pitch, form, overhang, and orientation as the historic structure for additions.
- iv. *Transitions between old and new*—Utilize a setback or recessed area and a small change in detailing at the seam of the historic structure and new addition to provide a clear visual distinction between old and new building forms.

B. SCALE, MASSING, AND FORM

- i. *Subordinate to principal facade*—Design residential additions, including porches and balconies, to be

subordinate to the principal façade of the original structure in terms of their scale and mass.

- ii. *Rooftop additions*—Limit rooftop additions to rear facades to preserve the historic scale and form of the building from the street level and minimize visibility from the public right-of-way. Full-floor second story additions that obscure the form of the original structure are not appropriate.
- iii. *Dormers*—Ensure dormers are compatible in size, scale, proportion, placement, and detail with the style of the house. Locate dormers only on non-primary facades (those not facing the public right-of-way) if not historically found within the district.
- iv. *Footprint*—The building footprint should respond to the size of the lot. An appropriate yard to building ratio should be maintained for consistency within historic districts. Residential additions should not be so large as to double the existing building footprint, regardless of lot size.
- v. *Height*—Generally, the height of new additions should be consistent with the height of the existing structure. The maximum height of new additions should be determined by examining the line-of-sight or visibility from the street. Addition height should never be so contrasting as to overwhelm or distract from the existing structure.

3. Materials and Textures

A. COMPLEMENTARY MATERIALS

- i. *Complementary materials*—Use materials that match in type, color, and texture and include an offset or reveal to distinguish the addition from the historic structure whenever possible. Any new materials introduced to the site as a result of an addition must be compatible with the architectural style and materials of the original structure.
- ii. *Metal roofs*—Construct new metal roofs in a similar fashion as historic metal roofs. Refer to the Guidelines for Alterations and Maintenance section for additional specifications regarding metal roofs.
- iii. *Other roofing materials*—Match original roofs in terms of form and materials. For example, when adding on to a building with a clay tile roof, the addition should have a roof that is clay tile, synthetic clay tile, or a material that appears similar in color and dimension to the existing clay tile.

B. INAPPROPRIATE MATERIALS

- i. *Imitation or synthetic materials*—Do not use imitation or synthetic materials, such as vinyl siding, brick or simulated stone veneer, plastic, or other materials not compatible with the architectural style and materials of the original structure.

C. REUSE OF HISTORIC MATERIALS

- ii. *Salvage*—Salvage and reuse historic materials, where possible, that will be covered or removed as a result of an addition.

4. Architectural Details

A. GENERAL

- i. *Historic context*—Design additions to reflect their time while respecting the historic context. Consider character-defining features and details of the original structure in the design of additions. These architectural details include roof form, porches, porticos, cornices, lintels, arches, quoins, chimneys, projecting bays, and the shapes of window and door openings.
- ii. *Architectural details*—Incorporate architectural details that are in keeping with the architectural style of the original structure. Details should be simple in design and compliment the character of the original structure. Architectural details that are more ornate or elaborate than those found on the original structure should not be used to avoid drawing undue attention to the addition.
- iii. *Contemporary interpretations*—Consider integrating contemporary interpretations of traditional designs and details for additions. Use of contemporary window moldings and door surroundings, for example, can provide visual interest while helping to convey the fact that the addition is new.

Standard Specifications for Windows in Additions and New Construction

- **GENERAL:** New windows on additions should relate to the windows of the primary historic structure in terms of materiality and overall appearance. Windows used in new construction should be similar in appearance to those commonly found within the district in terms of size, profile, and configuration. While no material is expressly prohibited by the Historic Design Guidelines, a high-quality wood or aluminum-clad wood window product often meets the Guidelines with the stipulations listed below. Whole window systems should match the size of historic windows on property unless otherwise approved.
- **SIZE:** Windows should feature traditional dimensions and proportions as found within the district.
- **SASH:** Meeting rails must be no taller than 1.25". Stiles must be no wider than 2.25". Top and bottom sashes must be equal in size unless otherwise approved.

- DEPTH: There should be a minimum of 2” in depth between the front face of the window trim and the front face of the top window sash.
 - This must be accomplished by recessing the window sufficiently within the opening or with the installation of additional window trim to add thickness.
- TRIM: Window trim must feature traditional dimensions and architecturally appropriate casing and sloped sill detail. Window track components such as jamb liners must be painted to match the window trim or concealed by a wood window screen set within the opening.
- GLAZING: Windows should feature clear glass. Low-e or reflective coatings are not recommended for replacements. The glazing should not feature faux divided lights with an interior grille. If approved to match a historic window configuration, the window should feature real exterior muntins.
- COLOR: Wood windows should feature a painted finished. If a clad product is approved, white or metallic manufacturer’s color is not allowed, and color selection must be presented to staff.
- INSTALLATION: Wood windows should be supplied in a block frame and exclude nailing fins. Window opening sizes should not be altered to accommodate stock sizes prior to approval.
- FINAL APPROVAL: If the proposed window does not meet the aforementioned stipulations, then the applicant must submit updated window specifications to staff for review, prior to purchase and installation. For more assistance, the applicant may request the window supplier to coordinate with staff directly for verification.

FINDINGS:

- a. The property at 820 N Alamo is a two-story Colonial Revival-style residence built in 1910 as La Casa Boarding House. The property first appears on Sanborn Fire Insurance maps in 1912 in the same footprint as it appears today. It faces northwest on a block bound to the northwest by N Alamo St, the southwest by 8th St, the southeast by Union St, and the northeast by 9th St. It has a two-story central porch supported by double-height columns and flanked by one-story covered porches with smaller columns with less ornate capitals. Prior to their removal, windows were one-over-one; the house is clad in wood waterfall siding. The flat roof has corniced eaves with dentils below the second-story form. The main entrance has double doors flanked by side lites and topped with a three-lite transom. The property is an individual landmark.
- b. PREVIOUS APPROVAL: This request was approved on the consent agenda by the Historic and Design Review Commission on August 2, 2023. The recommendation stipulated at the rear two-story mass be retained and incorporated into the design for the rear addition. The applicant consented to the stipulation in error and now wishes to clarify their intent through this request.
- c. DESIGN REVIEW COMMITTEE: On June 21, 2023, the Historic and Design Review Commission referred the request for a three-story addition to the Design Review Committee. On July 12, 2023, the applicant met with staff and members of the Design Review Committee. Notes are included in this case file. On August 30, 2023, the applicant met on site with staff and members of the Design Review Committee to see the context and condition of the rear two-story mass. Commissioners and the applicant discussed options for incorporating the rear two-story mass into the addition. Commissioners suggested the applicant provide a site plan showing the existing house with rear two-story mass superimposed on the proposed site plan for the addition to illustrate how retention would impact the project.
- d. PARTIAL DEMOLITION: The applicant requests to demolish the rear, southeast two-story mass. The two-story mass appears on the 1912 Sanborn Fire Insurance map and appears to be original to the structure. The parapet wall extends along both sides of the house, extending back from the front cornice. Staff recommends retaining this two-story rear mass and incorporating it into the proposed addition.
- e. REAR ADDITION: The applicant requests conceptual approval of an approximately 1,944-square-foot, three-story rear addition. Renderings show full-height columns clad in wood or Hardie siding extending from the ground to the roof deck, with the bulk of the footprint featuring open-air spaces enclosed on some elevations by wood or Hardie screens, metal wall panels, and wood or Hardie siding. Enclosed spaces are for service and storage use. While staff finds a rear addition generally appropriate, the footprint and massing exceed what conforms to guidelines, as outlined in the next findings.
- f. FOOTPRINT: The applicant proposes an addition with a footprint of approximately 1,944 square feet. The existing house footprint is 1,649 square feet, plus a front porch that exceeds 200 square feet, and the proposed addition would bring total square footage to 3,793. Historic Design Guidelines for Additions 1.B.iv states that residential additions should not be so large as to double the existing building footprint. The proposed addition doubles the existing footprint. Though the addition doubles the size of the structure, staff finds that the additions is clearly distinguishable as an open air addition and generally conforms to the Guidelines.

- g. **MASSING:** The applicant proposes a two-story addition with roof deck. Historic Design Guidelines for Additions 1.B.i says residential additions should be designed to be subordinate to the principal façade of the original structure in terms of their scale and mass. The height of the proposed addition is subordinate to that of the existing house, but does not include setbacks where the addition meets the existing structure. There is, however, a material change between the existing house and the proposed addition. Staff finds the massing of the transition between the existing house and the proposed addition generally appropriate.
- h. **MATERIALS:** The proposed addition includes full-height columns clad in wood or Hardie siding extending from the ground to the roof deck, with the bulk of the footprint featuring open-air spaces enclosed on some elevations by wood or Hardie screens, metal wall panels, or wood or Hardie siding. The proposed rear staircase is metal and concrete, and railings are metal. Historic Design Guidelines for Additions 3.A.i says to use materials that match in type, color, and texture and include an offset or reveal to distinguish the addition from the historic structure whenever possible. Any new materials introduced to the site as a result of an addition must be compatible with the architectural style and materials of the original structure. Staff finds the wood or Hardie cladding and metal railings generally appropriate, but that the applicant should explore cladding options other than the proposed metal siding.
- i. **FENCING:** The applicant requests to construct a fence made of steel pipe posts and corrugated metal panels to enclose the rear yard. Per UDC Sec 35-514(a)(6), fences may not be constructed of sheet, roll, or corrugated metal. Staff finds the applicant must propose a fence that conforms to UDC standards.

RECOMMENDATION:

Staff does not recommend approval of the request to remove the rear two-story mass. Staff recommends that the rear two-story mass be retained per the previous HDRC approval.



- NOTICE -
AN APPLICATION TO SELL
AND CONSUME ALCOHOLIC
BEVERAGES IS PROPOSED
FOR THIS LOCATION.
TYPE OF LICENSE/PERMIT:
MIXED BEVERAGE PERMIT
NAME OF APPLICANT:
NAME OF APPLICANT:
\$2,000
THIS INFORMATION CANNOT
CONTACT YOUR LOCAL TAP
OR HAVE THIS TAP
APPLICANT







BAR HO_r SE, LLC

NEW BAR HO_r SE

AUGUST 3, 2023

NEW BAR HO_r SE

820 NORTH ALAMO STREET
SAN ANTONIO, TEXAS 78215
ISSUE FOR PERMIT



MARCH 21, 2023

OWNER

BAR HOUSE, LLC
PO BOX 284
CIBOLO, TEXAS 78108
210-417-7217 P
NMARQUEZ55@GMAIL.COM

ARCHITECT

ABOVE GROUND DESIGN PLLC
200 GROOMS ROAD
CIBOLO, TEXAS 78108
210-379-6034 P

STR_r CT_r RAL

HOFFER STRUCTURAL SOLUTIONS
845 PROTON ROAD
SAN ANTONIO, TEXAS 78258
210-646-1665 P


MEPT

HM3 ENGINEERING CONSULTANTS
2902 NORTH FLORES
SAN ANTONIO, TEXAS 78212
210-393-1840 P


G0.00

CHECKED BY: **Chicker**
DRAWN BY: **KERITIAN**
8/3/2023 9:43:00 PM

DRAWING CONVENTIONS

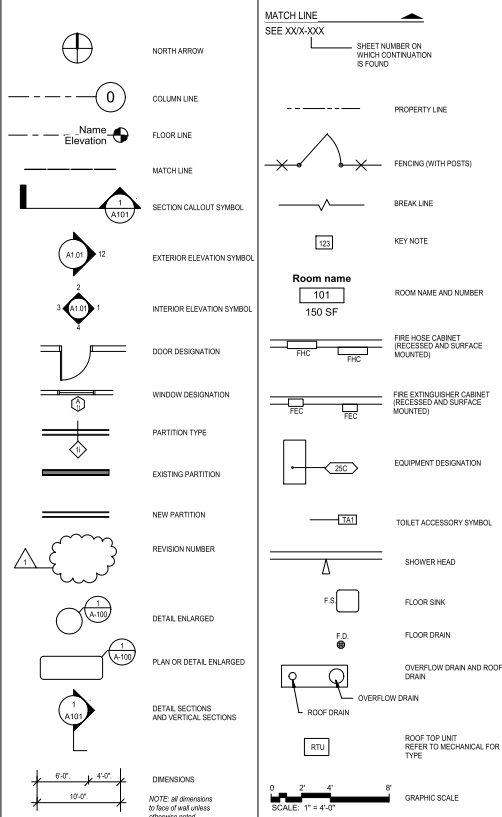

MATERIALS CONVENTIONS

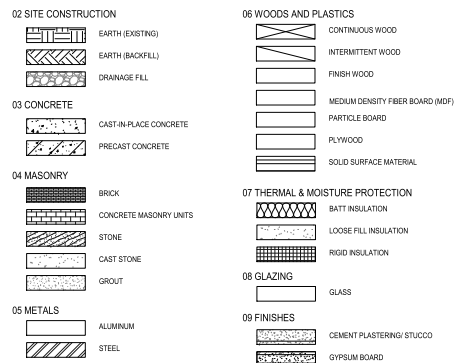

ABBREVIATIONS

A.D.	AREA DRAIN	MECH.	MECHANICAL
A.D.A.	AMERICANS WITH DISABILITIES ACT	MEM	MEMBRANE
A.D.A.G.	2010 ADA STANDARDS FOR ACCESSIBLE DESIGN	MEM WP	MEMBRANE WATERPROOFING
A.F.F.	ABOVE FINISH FLOOR	MEP	MECHANICAL, ELECTRICAL, PLUMBING
A.F.G.	ABOVE FINISH GRADE	MEZZ	MEZZANINE
A.H.J.	AUTHORITY HAVING JURISDICTION	M.F.	MANUFACTURE (R)
A/C	AIR CONDITIONING	MH	MANHOLE
A.C.P.	ACROUSTICAL PANEL	MIN.	MINIMUM
A.C.T.	ACROUSTICAL TIE	MISC.	MISCELLANEOUS
AGC	ADJUSTABLE	MOD	MODULAR
ALT.	ALTERNATE	MTL	METAL
ALUM.	ALUMINUM	MTF	METAL TOILET PARTITION
ASPH.	ASPHALT	N.D.	NAPION DISPOSAL
APH	ANGLE	N.C.	NOT IN CONTRACT
B.O.D.	BOTTOM OF DECK	N.T.S.	NOT TO SCALE
B.U.R.	BUILT-UP ROOF	N.V.	NAPION VENDOR
BO.	BOARD	NO.	NUMBER
B.L.D.	BUILDING	NOM.	NOMINAL
BLK.	BLOCK	O.C.	ON CENTER (S)
BM.	BEAM	O.C.E.W.	ON CENTER EACH WAY
C	CHANNEL	O.D.	OUTSIDE DIAMETER
C.J.	CONCRETE JOINT	O.F.C.I.	OWNER FURNISHED, CONTRACTOR INSTALLED
C.M.U.	CONCRETE MASONRY UNIT	O.H.	OPPOSITE HAND
C.W.	COLD WATER	OPNG.	OPENING
CAB.	CABINET	OPP.	OPPOSITE
CMP.	COLD-FORMED METAL FRAMING	P.LAM / PLAM	PLASTIC LAMINATE
CFSF	COLD-FORMED STEEL FRAMING	P.C.	PRECAST
CL.	CENTERLINE	P.H.	PAPER HOLDER
C.L.G.	CELING	P.L.	PROPERTY LINE
COL.	COLUMN	P.P.	POWER POLE
COMP.	COMPRESSIBLE	P.P.B.	PREFINISHED WALL BOARD
CONC.	CONCRETE	PL	PLATE
COND.	CONDITION	PLUMB.	PLUMBING
CONT.	CONTINUOUS	PLYWD.	PLYWOOD
CORR.	CORROSION	POL.	POLISHED
CPT.	CARPET (ED)	PR.	PAIR
CT	CERAMIC TILE	PRE-F.	PRE-FINISHED
CTSK	COUNTER SINK	PREFN.	PRESSURE-TREATED
D	DAISY	PT.	POINT
D.F.	DRINKING FOUNTAIN	PTD.	PAINTED
D.P.	DAMP ROOFING	Q.T.	QUARRY TILE
D.S.	DRAIN	R / RAD	RADIUS
DM.	DIMETER	RCP	REFLECTED CEILING PLAN
DM.	DIMENSION	RD	ROAD
DTL.	DETAIL	RE	REFER TO REFERENCE / SEE
DWG.	DRAWING	REC.	RECEIPT
E.J.	EXPANSION JOINT	RENF.	REINFORCE (S) (ING)
E.Q.	EQUAL	REQD.	REQUIRED
EA.	EACH	RES.	RESILIENT
EDF.	ELECTRIC DRINKING FOUNTAIN	REV.	REVISION (S), REVISED
EL.	ELEVATION (HEIGHT)	RF	RECREATIONAL RESILIENT FLOORING
ELEC.	ELECTRICAL	RPG.	RELOCATABLE PAINTED GYPSUM BOARD
ELECT.	ELECTRICAL (DRAWING)	RSS.	ROD STOCK AND SEALANT
ELEV.	ELEVATION (DRAWING)	S.C.	SEALANT CONCRETE
EQUIP.	EQUIPMENT	S.D.	SEWER DISPENSER
EXIST.	EXISTING	S.N.D.	SANITARY NAPION DISPOSAL
EXP.	EXPANSION	SCHED.	SCHEDULE
EXT.	EXTERIOR	SOPR.	SOLID CORE PLASTIC LAMINATE
F.E.	FIRE EXTINGUISHER	SECT	SECTION
F.E.C.	FIRE EXTINGUISHER CABINET	SHT	SHEET
F.A.C.	FIRE HOSE CABINET	SM	SIMILAR
FB.	FACE BRICK	SPC.	SPECIAL COATING SYSTEM
FD.	FLOOR DRAIN	SPEC	SPECIFICATION (S)
FIN.	FINISH (ED)	SQ.	SQUARE
FKT.	FIXTURE	SS / SS STL.	STAINLESS STEEL
FLR.	FLOOR (ING)	STL.	STEEL
FLSHG.	FLASHING	STRUCT / STRUCT	STRUCTURAL
FLUOR.	FLUORESCENT	SUSP.	SUSPENDED
FRP	FIBER REINFORCED PLASTIC	SUVF.	SHEET VINYL DANCE FLOORING
G.B.	GRAB BAR	SVP.	SHEET VINYL FLOORING
G.I.	GALVANIZED IRON	T.A.S.	TEXAS ACCESSIBILITY STANDARDS (2012)
GA.	GALVNE	T.B.	TACK BOARD
GALV.	GALVANIZED	T.D.R.	TOWEL DISPENSER AND RECEPT.
GDMU	GLAZED CONCRETE MASONRY UNIT	T.O.	TOP OF
GEN.	GENERAL	T.O.B.	TOP OF BLOCK
GEN.	GENERAL	T.O.M.	TOP OF MASONRY
GL.	GLASS / GLAZING	T.O.P.	TOP OF PARAPET
GL.	GLASS	T.O.S.	TOP OF STEEL
GR.	GRADE	T.T.D.	TOILET TISSUE DISPENSER
GTP.	GYPSUM DRYWALL	TEL	TELEPHONE
GYP.	GYPSUM (DRY)WALL	TERAZO	TERAZO
H.W.	HOT WATER	THK (NESS)	THICK (NESS)
HC	HANDICAPPED ACCESSIBLE	TYP	TYPICAL
HM	HOLLOW METAL FRAME	U.N.O.	UNLESS NOTED OTHERWISE
HRZ.	HORIZONTAL	URNAL	URNAL
HT.	HEIGHT	V	VENT
I.D.	INSIDE DIAMETER	V.C.T.	VENT COMPOSITION TILE
I.P.S.	IRON PIPE SIZE	V.F.	VENTILATING, VENTILATED
INSUL.	INSULATE (ED), (ION)	VENT.	VENT
INT.	INTERIOR	VER.	VERIFY
JT.	JOINT	VERT.	VERTICAL
L.P.	LIGHT POLE	VGB	(PREFINISHED) VINYL CLAD GYPSUM BOARD
LAM.	LAMINATE (D)	VWC	VINYL WALL COVERING
LAV.	LAVATORY	W	WASHING MACHINE
LT.	LIGHTWEIGHT	W.P.	WATER PROOFING
LT.WT.	LIGHTWEIGHT	W.S.	WEATHERSTRIP
M.O.	MASONRY OPENING	W.W.	WATER WELL
MAS.	MASONRY	W.W.F.	WELDED WIRE FABRIC
MATL.	MATERIAL (S)	W.W.M.	WOMEN WIRE MESH
MAX.	MAXIMUM	WI	WITH
MB.	MARKER BOARD	WC	WATER CLOSET
		WD	WOOD
		WDW	WINDOW
		WT	WEIGHT


DRAWING INDEX

GENERAL		MECHANICAL	
G0.00	COVER SHEET	M000	MECHANICAL SYMBOLS & ABBREVIATIONS
G0.01	INDEX, DRAWING CONVENTIONS, AND LOCATION MAP	M001	MECHANICAL DETAILS
G0.11	FIRST FLOOR LIFE SAFETY PLAN	M100	FIRST FLOOR MECHANICAL PLAN
G0.12	SECOND FLOOR LIFE SAFETY PLAN	M200	SECOND FLOOR MECHANICAL PLAN
G0.20	ACCESSIBILITY GUIDELINES & FRAME DETAILS	M300	THIRD FLOOR MECHANICAL PLAN
G0.30	SITE FIRE PROTECTION PLAN	M400	MECHANICAL SCHEDULES
DEMOLITION		ELECTRICAL	
D2.01A	DEMOLITION - FIRST FLOOR PLAN AREA A	E000	ELECTRICAL SYMBOLS & ABBREVIATIONS
D2.02A	DEMOLITION - SECOND FLOOR PLAN AREA A	E001	ELECTRICAL GENERAL NOTES
STRUCTURAL		E002	ELECTRICAL DETAILS
S1.00	GENERAL NOTES	E003	ELECTRICAL DETAILS
S2.00	FOUNDATION PLAN	E100	FIRST FLOOR LIGHTING PLAN
S2.01	SECOND FLOOR FRAMING PLAN	E101	SECOND FLOOR LIGHTING PLAN
S2.02	THIRD FLOOR FRAMING PLAN	E102	ROOF LIGHTING PLAN
S2.03	ROOF FRAMING PLAN	E200	FIRST FLOOR POWER PLAN
S3.00	SLAB ON GRADE NOTES & DETAILS	E201	SECOND FLOOR POWER PLAN
S3.01	SLAB ON GRADE DETAILS	E202	ROOF POWER PLAN
S4.00	WOOD FRAMING NOTES & SECTIONS	E300	ELECTRICAL ONE-LINE DIAGRAM
S4.01	WOOD FRAMING DETAILS	PLUMBING	
S5.01	STEEL NOTES AND DETAILS	P000	PLUMBING SYMBOLS & ABBREVIATIONS
S5.01	STEEL NOTES AND DETAILS	P001	PLUMBING DETAILS
ARCHITECTURAL		P100	FIRST FLOOR DOMESTIC WATER PLAN
A0.01	ARCHITECTURAL SITE PLAN	P101	SECOND FLOOR DOMESTIC WATER PLAN
A0.02	LANDSCAPE PLAN	P200	FIRST FLOOR WASTE AND VENT PLAN
A2.01	COMPOSITE FIRST FLOOR PLAN	P201	SECOND FLOOR WASTE AND VENT PLAN
A2.01A	FIRST FLOOR PLAN - AREA A	P300	PLUMBING RISERS & SCHEDULES
A2.01B	FIRST FLOOR PLAN - AREA B		
A2.02	COMPOSITE SECOND FLOOR PLAN		
A2.02A	SECOND FLOOR PLAN - AREA A		
A2.02B	SECOND FLOOR PLAN - AREA B		
A3.01	ROOF PLAN & DETAILS		
A4.01	ENLARGED PLANS		
A6.01	EXTERIOR ELEVATIONS		
A6.02	EXTERIOR ELEVATIONS		
A6.20	INTERIOR ELEVATIONS		
A7.00	PARTITION, STAIR & RAILING DETAILS		
A7.10	WALL SECTION DETAILS		
A9.01	DOOR, WINDOW AND FRAME ELEVATIONS		
A10.01A	REFLECTED CEILING PLAN - FIRST FLOOR AREA A		
A10.01B	REFLECTED CEILING PLAN - FIRST FLOOR AREA B		
A10.02A	REFLECTED CEILING PLAN - SECOND FLOOR AREA A		
A10.02B	REFLECTED CEILING PLAN - SECOND FLOOR AREA B		

SHEET NUMBERING

SHEET NUMBER	A2.01A	BUILDING AREA	SEQUENCE (01 - 99, etc.)
DISCIPLINE	GENERAL	DISCIPLINE TYPE	GENERAL
0	GENERAL	1	SITE
1	GENERAL	2	FLOOR PLANS (Note: Floor Plans are Schedules)
2	GENERAL	3	ROOF
3	GENERAL	4	ENLARGED PLANS
4	GENERAL	5	PLAN DETAILS
5	GENERAL	6	ELEVATIONS (Exterior and Interior)
6	GENERAL	7	PARTITION TYPES, WALL SECTIONS
7	GENERAL	8	CASEWORK
8	GENERAL	9	DOORS, WINDOWS, FRAMES
9	GENERAL	10	CEILINGS

SITE LOCATION MAP

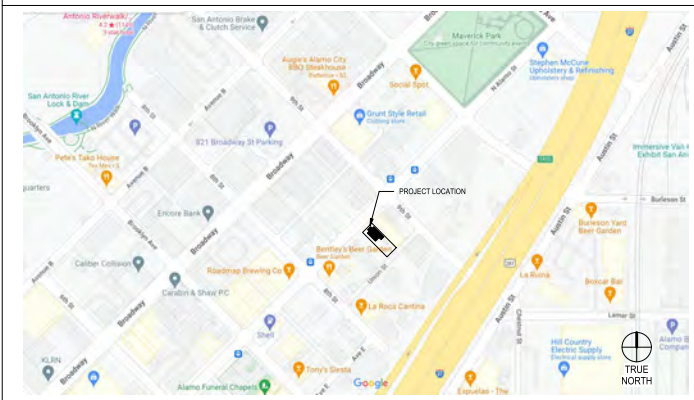

ARCHITECT	Above Ground Design, PLLC
MEET	HMS Engineering
2902 N Flores Street	
San Antonio, Texas 78212	
STRUCTURAL	Hoffer Structural Solutions
COPYRIGHT 2023	

BAR HOUSE, LLC	NEW BAR HOUSE
ISSUE FOR PERMIT	


KEY PLAN	PLAN NORTH	TRUE NORTH
----------	------------	------------

REGISTERED ARCHITECT	STATE OF TEXAS
AUGUST 3, 2023	

CLIENT BAR HOUSE, LLC		
PROJECT NUMBER 21003		
DATE	AUGUST 3, 2023	
REVISIONS		
No.	Description	Date
1	COSA REVISION	08/03/2023

ISSUE FOR PERMIT	
INDEX, DRAWING CONVENTIONS, AND LOCATION MAP	

G0.01

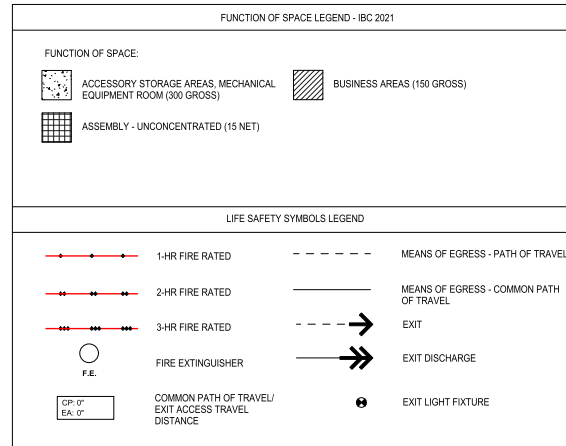


PROJECT GENERAL INFORMATION	
NAME OF PROJECT	THE HIDDEN GROVE
BUILDING/FACILITY NAME	TAVERN
LOCATION (Address)	820 N ALAMO STREET, SAN ANTONIO
COUNTY, STATE	BEXAR TEXAS, 78215
DESCRIPTION OF PROJECT	NEW HARDBOARD-WRAPPED STEEL OPEN AIR FACILITY FOR TAVERN USE, RENOVATE EXISTING
APPLICABLE BUILDING CODE	2021 IBC & IBC WITH LOCAL AMENDMENTS
APPLICABLE ENERGY CODE	2021 EEC WITH LOCAL AMENDMENTS
ACCESSIBILITY	2012 TEXAS ACCESSIBILITY STANDARDS
CONSTRUCTION TYPE	VB
CONSTRUCTION TYPE MIX	BUSINESS WITH A-2 LOUNGE
OCCUPANCY CLASSIFICATION(S)	ASSEMBLY TYPE 2 - TAVERN
OVERALL USE OF BUILDING	TAVERN
HIGH-RISE BUILDING	N/A
AUTOMATIC FIRE SPRINKLER SYSTEM	N/A
STANDPIPE SYSTEM	N/A
MAXIMUM COMMON PATH (Without Sprinkler)	75 FEET (NS)
MAXIMUM EXIT ACCESS TRAVEL DISTANCE (Without Sprinkler)	120 FEET
CORRIDOR FIRE RESISTANCE RATING	0
MINIMUM CORRIDOR WIDTH	8'
# OF PARKING SPACES (BY ZONING Required / Provided)	81 / PARKING IS ON STREET AND PARKING LOT ACROSS STREET
# OF ACCESSIBLE SPACES REQUIRED	

		Exits		Egress Door Width (in.)		Egress Stair Width (in.)	
Query (Occupants)	Number of Occupants	Required	Provided	Required	Provided	Required	Provided
First Floor	275	2	3	36	104	3'-6"	n/a
ASSEMBLY (A-2)							

		Water Closets + Urinals		Lavatories		Drinking Fountains		Service Sinks	
Query (Plumbing Fixture Counts)	Occupants	Required	Provided	Required	Provided	Required	Provided	Required	Provided
A-2 TAVERN ASSEMBLY	148	1	1	1	1	1	1	1	1
Total Occupants	275	7	8	4	6	TAVERN	-	-	1
Total Female	138	-	3	-	2	-	-	-	-
Total Male	137	-	3	-	2	-	-	-	-
Unisex Assisted Use	-	-	2	-	2	-	-	-	-

LEGAL DESCRIPTION: PROPERTY ID: 104440 NCB- 432 BLK 30 LOT 6

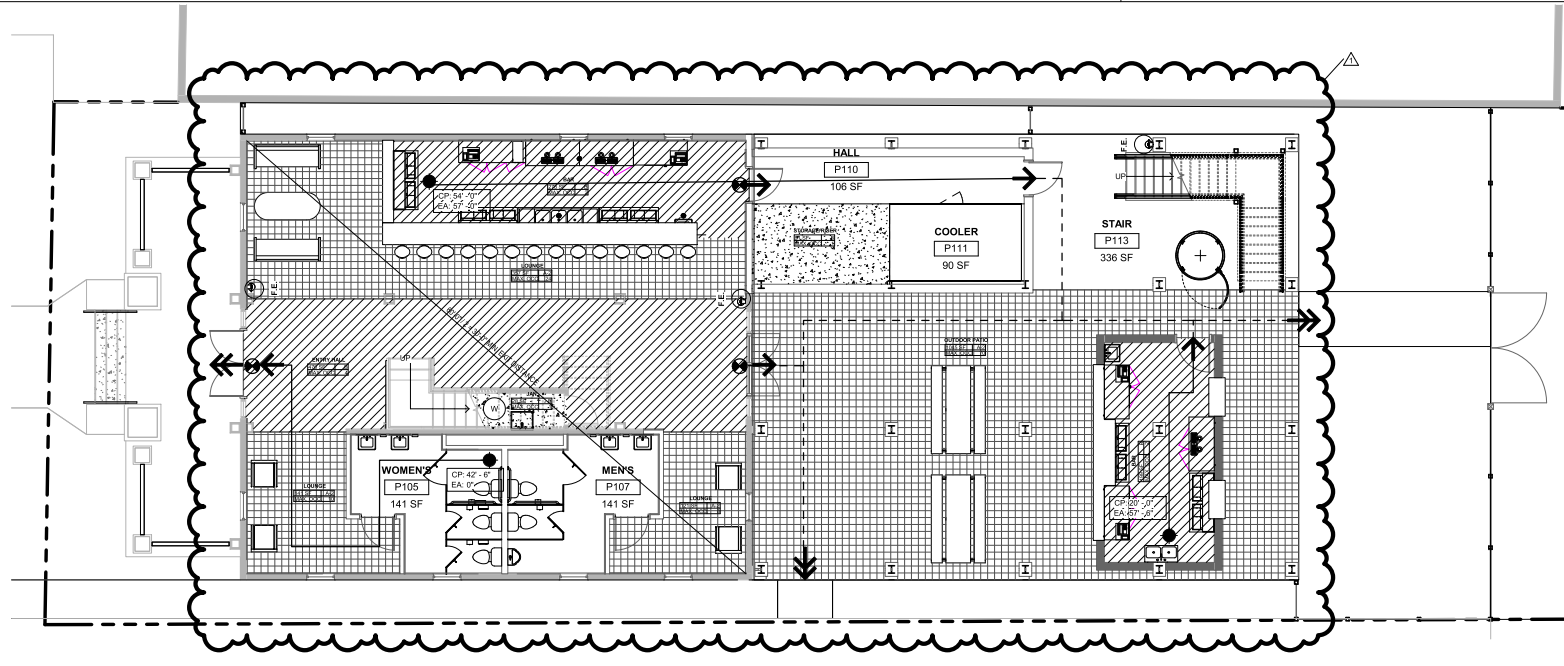SITE AREA: 0.334 NET ACRES
ZONING OF SITE: FB2 T4-2
PROPOSED USE: COMMERCIAL TAVERNDEVELOPMENT IS SUBJECT TO THE FOLLOWING CODES:
2012 TEXAS ACCESSIBILITY STANDARDS
2015 UNIFIED DEVELOPMENT CODE WITH 2022 AMENDMENTS
2021 INTERNATIONAL BUILDING CODE WITH LOCAL AMENDMENTS
2021 INTERNATIONAL EXISTING BUILDING CODE WITH LOCAL AMENDMENTS
2021 INTERNATIONAL FIRE CODE WITH LOCAL AMENDMENTS
2021 INTERNATIONAL MECHANICAL CODE WITH LOCAL AMENDMENTS
2021 NATIONAL ELECTRIC CODE WITH LOCAL AMENDMENTS
2021 INTERNATIONAL ENERGY CONSERVATION CODE WITH LOCAL AMENDMENTS
2021 INTERNATIONAL PLUMBING CODE WITH LOCAL AMENDMENTSOCCUPANT COUNT:
FIRST FLOOR: 122
SECOND FLOOR: 153
TOTAL: 2755 FIRST FLOOR LIFE SAFETY PLAN
3/16" = 1'-0"

ARCHITECT Above Ground Design, PLLC
2001 Grooms Road
Cibola, Texas 78108


MEET HNS Engineering
2902 N Flores Street
San Antonio, Texas 78212

STRUCTURAL Hoffer Structural Solutions
940 Prosper Road
San Antonio, Texas 78258

COPYRIGHT 2023

BAR HOUSE, LLC
NEW BAR HOUSE

820 NORTH ALAMO STREET
SAN ANTONIO TEXAS 78215
ISSUE FOR PERMIT

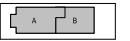

KEY PLAN

PLAN NORTH
TRUE NORTH



CLIENT BAR HOUSE, LLC
PROJECT NUMBER #1003
DATE AUGUST 3, 2023

REVISIONS

No.	Description	Date
1	ISSUE FOR PERMIT	08/03/2023

ISSUE FOR PERMIT
FIRST FLOOR LIFE SAFETY PLAN

G0.11


CHECKED BY: Checker

DRAWN BY: Author

8/3/2023 9:43:07 PM

5

SECOND FLOOR LIFE SAFETY PLAN
3/16" = 1'-0"

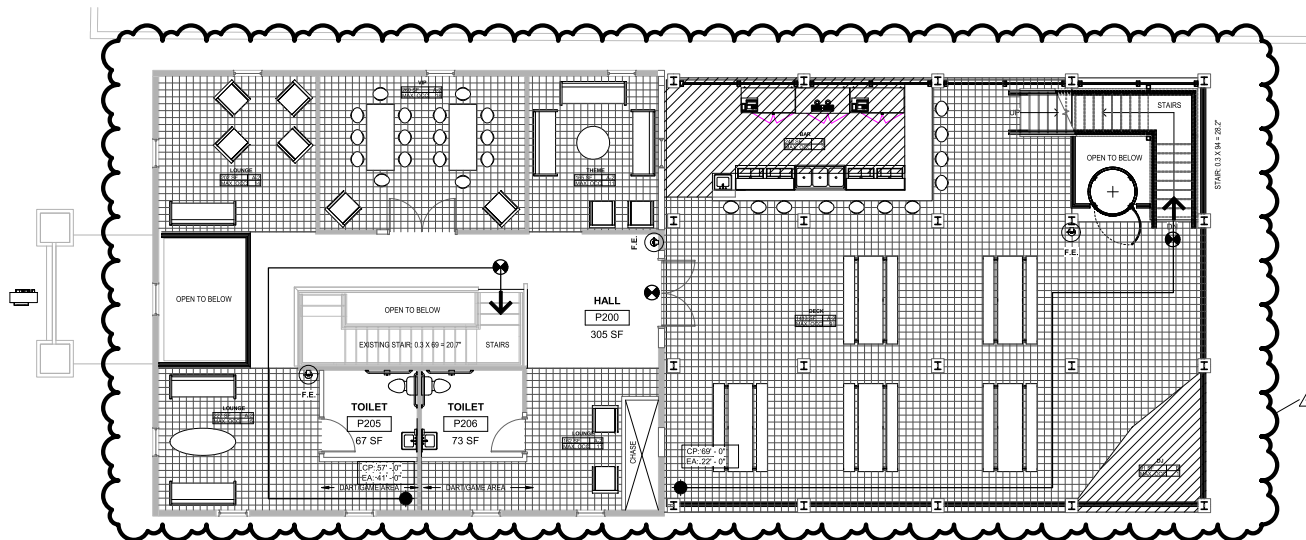

FUNCTION OF SPACE LEGEND - IBC 2021	
FUNCTION OF SPACE:	
	ACCESSORY STORAGE AREAS, MECHANICAL EQUIPMENT ROOM (300 GROSS)
	ASSEMBLY - UNCONCENTRATED (15 NET)
LIFE SAFETY SYMBOLS LEGEND	
	1-HR FIRE RATED
	2-HR FIRE RATED
	3-HR FIRE RATED
	FIRE EXTINGUISHER
	COMMON PATH OF TRAVEL/ EXIT ACCESS TRAVEL DISTANCE
	MEANS OF EGRESS - PATH OF TRAVEL
	MEANS OF EGRESS - COMMON PATH OF TRAVEL
	EXIT
	EXIT DISCHARGE
	EXIT LIGHT FIXTURE

PROJECT GENERAL INFORMATION	
NAME OF PROJECT	THE HIDDEN GROVE
BUILDING / FACILITY NAME	TAVERN
COUNTY, STATE	BEXAR TEXAS, 78215
DESCRIPTION OF PROJECT	NEW HARDWARE-WAPPED STEEL OPEN AIR FACILITY FOR TAVERN USE, RENOVATE EXISTING
APPLICABLE BUILDING CODE	2021 IBC & IBC WITH LOCAL AMENDMENTS
APPLICABLE ENERGY CODE	2021 IECC WITH LOCAL AMENDMENTS
ACCESSIBILITY	2012 TEXAS ACCESSIBILITY STANDARDS
CONSTRUCTION TYPE	VB
CONSTRUCTION TYPE MIX	BUSINESS WITH A-2 LOUNGE
OCCUPANCY CLASSIFICATION(S)	ASSEMBLY TYPE 2 - TAVERN
OVERALL USE OF BUILDING	TAVERN
HIGH RISE BUILDING	N/A
AUTOMATIC FIRE SPRINKLER SYSTEM	N/A
STANDPIPE SYSTEM	NO
MAXIMUM COMMON PATH (Without Sprinkler)	75 FEET (NS)
MAXIMUM EXIT ACCESS TRAVEL DISTANCE (Without Sprinkler)	200 FEET
CORRIDOR FIRE RESISTANCE RATING	0
MINIMUM CORRIDOR WIDTH	8'
# OF PARKING SPACES BY ZONING (Required / Provided)	1
# OF ACCESSIBLE SPACES REQUIRED	1

ARCHITECT Above Ground Design, PLLC
2001 Grooms Road
Cibola, Texas 78108

MEET HNS Engineering
2902 N Flores Street
San Antonio, Texas 78212

STRUCTURAL Hoffer Structural Solutions
940 Prosper Road
San Antonio, Texas 78258

COPYRIGHT 2023

BAR HOUSE, LLC
NEW BAR HOUSE
SAN ANTONIO TEXAS 78215
ISSUE FOR PERMIT

KEY PLAN
PLAN NORTH
TRUE NORTH



CLIENT
BAR HOUSE, LLC
PROJECT NUMBER
#1003
DATE
AUGUST 3, 2023
REVISIONS

No.	Description	Date
1	ISSUE REVISION	08/03/2023

ISSUE FOR PERMIT
SECOND FLOOR
LIFE SAFETY PLAN

G0.12

ACCE
1/4" = 1'-0"

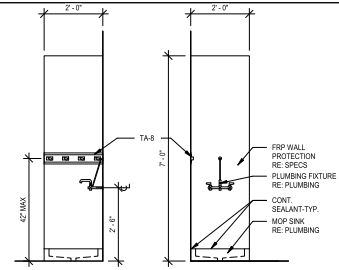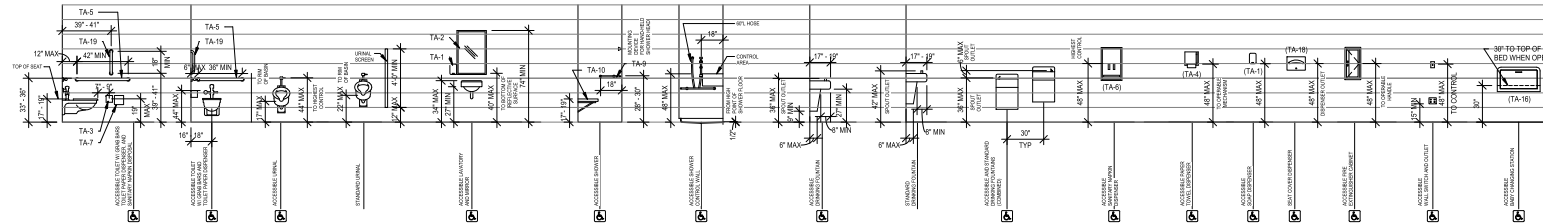



	T
--	---

TOILET ACCESSORIES		
LABEL	DESCRIPTION	REMARKS
TA-1W	SOAP DISPENSER (WALL MOUNTED)	
TA-2	MIRROR	
TA-3	TOILET PAPER DISPENSER	
TA-4	PAPER TOWEL DISPENSER	
TA-5	GRAB BARS (AT DIFFERENT ACCESSIBLE TOILET STALL)	
TA-6	SANITARY NAPKIN DISPENSER	
TA-7	SANITARY NAPKIN DISPOSAL	
TA-8	MOP AND BROOM HOLDER	
TA-9	GRABS AT ACCESSIBLE SHOWER)	NOT USED
TA-10	FOLDING SHOWER BENCH	NOT USED
TA-11	CLOTHES HOOK	NOTE 5
TA-12	SHOWERS CURTAIN, ROD AND HOOKS	NOT USED
TA-13	ELECTRIC HAND DRYER	NOT USED
TA-14	PAPER TOWEL DISPENSER AND TRASH RECEPTACLE	NOT USED
TA-15	GRAB BARS (AT AMBULATORY ACCESSIBLE TOILET STALL)	NOT USED

NOTE: ALL TOILET ACCESSORIES SHALL BE CONTRACTOR FURNISHED AND CONTRACTOR INSTALLED UNLESS NOTED OTHERWISE

1. COORDINATE FINAL LOCATIONS WITH ARCHITECT PRIOR TO INSTALLATION
2. CONTRACTOR IS TO VERIFY ALL HEIGHTS OF ACCESSORIES TO COMPLY WITH ALL APPLICABLE ACCESSIBILITY REQUIREMENTS
3. REFER TO OWNER FOR ALL FINISHES
4. ALIGN MIRROR ON CENTER OF LAVATORY
5. ONE (1) HOOK INSIDE DOOR AT SINGLE TOILET ROOMS

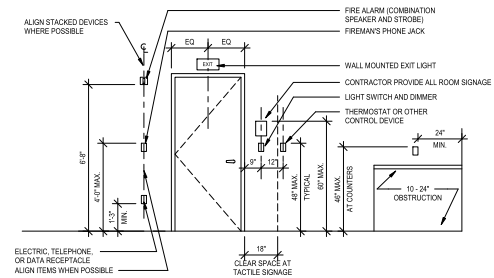

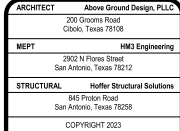

820 NORTH ALAMO STREET
SAN ANTONIO TEXAS 78215

ISSUE FOR PERMIT

[illegible]

ISSUE FOR PERMIT


**ACCESSIBILITY
GUIDELINES &
FRAME DETAILS**

G0.20

CHECKED BY: Checker


DRAWN BY: Author

8/3/2023 9:43:09 PM

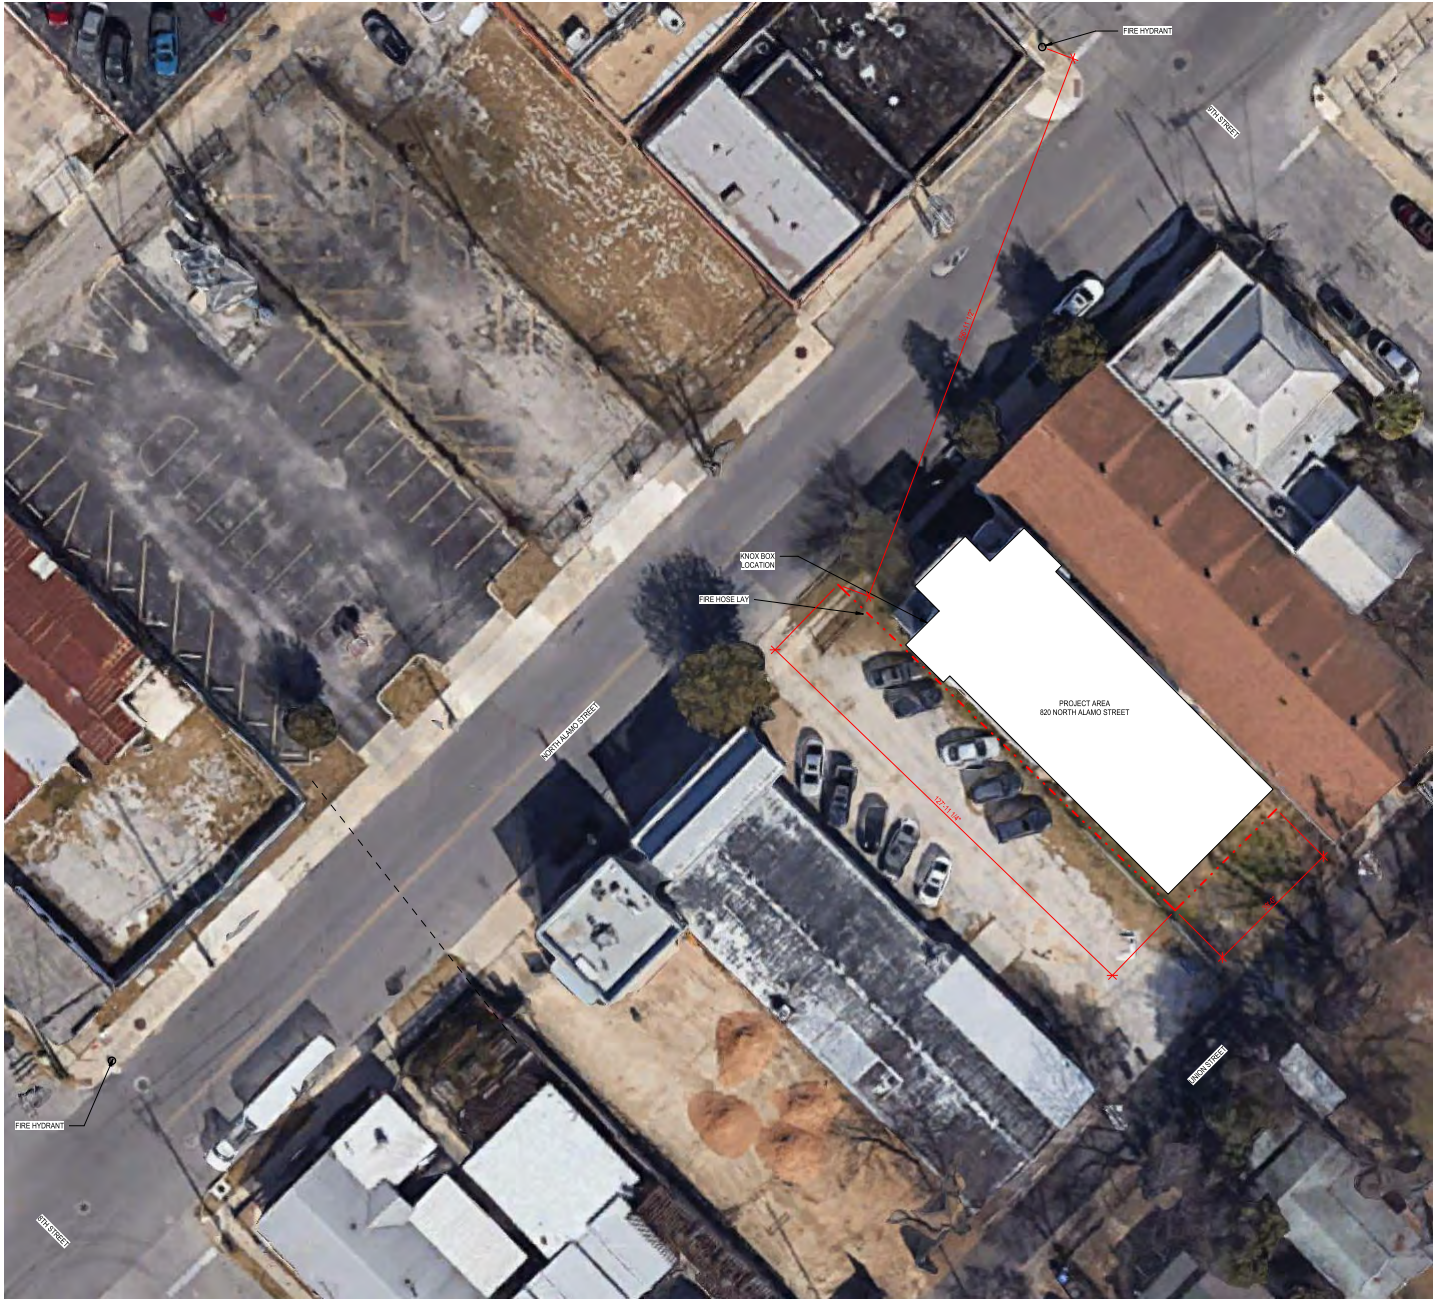

GENERAL FIRE PLAN NOTES

1. DURING CONSTRUCTION BUILDING ADDRESS SHALL BE POSTED. ADDRESS NUMERALS SHALL BE A COLOR CONTRASTING TO THE BACKGROUND. ADDRESS SHALL BE LOCATED SO THEY ARE CLEARLY VISIBLE AND LEGIBLE FROM THE STREET OR ROAD FRONTING THE PROPERTY.
2. ALL MANUAL AND ELECTRONIC GATES OR REQUIRED FIRE DEPARTMENT ACCESS ROADS OR GATES OBSTRUCTING FIRE DEPARTMENT ACCESS SHALL BE PROVIDED WITH THE KNOX RAPID ENTRY SYSTEM FOR EMERGENCY ACCESS BY FIREFIGHTING PERSONNEL. BUILDING ACCESS AND/OR GATE ACCESS IS REQUIRED. PROVIDE DETAILS AND LOCATION OF ALL KNOX BOX(S) AND/OR KNOX PAD LOCK(S).
3. THE CONTRACTOR SHALL DESIGNATE A PERSON TO BE THE FIRE PREVENTION PROGRAM SUPERINTENDENT WHO SHALL BE RESPONSIBLE FOR THE FIRE PREVENTION PROGRAM AND ENSURE THAT IT IS CARRIED OUT THROUGH COMPLETION OF THE PROJECT. THE FIRE PREVENTION PROGRAM SUPERINTENDENT SHALL HAVE THE AUTHORITY TO ENFORCE THE PROVISIONS OF THE FIRE CODE AND OTHER PROVISIONS AS NECESSARY TO SECURE THE INTENT OF THE FIRE CODE. WHERE GUARD SERVICE IS PROVIDED, THE SUPERINTENDENT SHALL BE RESPONSIBLE FOR THE GUARD SERVICE.
4. DURING THE ENTIRE CONSTRUCTION PERIOD THE CONTRACTOR SHALL BE FULLY RESPONSIBLE FOR PROVIDING AND MAINTAINING UNOBSTRUCTED EMERGENCY VEHICLE ACCESS TO THE PROJECT SITE, BUILDINGS, AND BUILDINGS UNDER CONSTRUCTION 24 HOURS A DAY.
5. GRADE TRANSITIONS SHALL NOT EXCEED THE CITY OF SAN ANTONIO'S FIRE DEPARTMENT AND MUTUAL AID DEPARTMENTS APPARATUS MAXIMUM APPROACH AND DEPARTURE ANGLES MAXIMUM 8 PERCENT (FOR AERIAL APPARATUS 8 PERCENT) OR AS DETERMINED BY THE FIRE CHIEF.
6. ALL-WEATHER ACCESS ROADS AND HYDRANT LOCATIONS SHALL BE APPROVED BY THE FIRE MARSHAL AND SHALL BE IN PLACE AND OPERATIONAL BEFORE ANY COMBUSTIBLE MATERIALS ARE PLACED ON SITE. ACCESS ROADS AND HYDRANTS SHALL BE MAINTAINED CLEAR OF OBSTRUCTIONS AT ALL TIMES.
7. NO LANDSCAPING OR OTHER OBSTRUCTIONS ARE TO BE WITHIN A THREE FOOT RADIUS OF A HYDRANT OR FIRE DEPARTMENT CONNECTION.



BAR HOUSE, LLC
NEW BAR HOUSE

2001 Grooms Road
Cibola, Texas 78108


360 Prosper Road
San Antonio, Texas 78258

COPYRIGHT 2023

ARCHITECT Above Ground Design, PLLC

MEPT HNS Engineering


STRUCTURAL Hoffer Structural Solutions

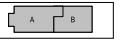

KEY PLAN

PLAN NORTH

TRUE NORTH



AUGUST 3, 2023

CLIENT
BAR HOUSE, LLC

PROJECT NUMBER
21003

DATE
AUGUST 3, 2023

REVISIONS

No.	Description	Date


ISSUE FOR PERMIT

SITE FIRE PROTECTION PLAN

G0.30

BC 1016.8 - EXEMPTIONS		REQUIRED STRUCTURAL SPECIAL INSPECTIONS		
EXEMPTIONS		SPECIAL INSPECTION	FREQUENCY	REFERENCE STANDARDS
1. WHERE BC SECTION 1903 DOES NOT REQUIRE REPORTING OF MATERIALS AND PROCEDURES FOR FILL PLACEMENT, THE SPECIAL INSPECTOR SHALL VERIFY THAT THE RAISED DRY DENSITY OF THE COMPACTED FILL IS NOT LESS THAN 95 PERCENT OF THE MAXIMUM DRY DENSITY AT OPTIMUM MOISTURE CONTENT AS DETERMINED IN ACCORDANCE WITH ASTM D 1557.		BC 1016.2 - STEEL CONSTRUCTION		
VERIFICATION THAT PROPER MATERIALS AND PROCEDURES ARE USED DURING FILL PLACEMENT IN ACCORDANCE WITH THE PROVISIONS OF THE APPROVED-SECTION/CORRECTION REPORT	PERIODIC	STRUCTURAL STEEL IN ACCORDANCE WITH QUALITY ASSURANCE INSPECTION REQUIREMENTS OF AISC 360		ASC 360
1. VERIFY MATERIALS BELOW SHALL ON FOUNDATIONS ARE ADEQUATE TO ACHIEVE THE DESIGN BEARING CAPACITY	PERIODIC	BC 1016.2.1 - STEEL CONSTRUCTION OTHER THAN STRUCTURAL STEEL		
2. VERIFY LOCATIONS ARE EXTENDED TO PROPER DEPTH AND HAVE REACHED PROPER MATERIAL	PERIODIC	SPECIAL INSPECTIONS AND QUALIFICATION OF WELDING SPECIAL INSPECTORS FOR COLD-FORMED STEEL FLOOR AND ROOF DECK		
3. PERFORM CLASSIFICATION AND TESTING OF COMPACTED FILL MATERIALS	PERIODIC	1. MATERIAL VERIFICATION OF COLD-FORMED STEEL DECK		
4. VERIFY USE OF PROPER MATERIALS, IDENTITIES AND QUALITIES DURING FILL PLACEMENT AND COMPACTION OF COMPACTED FILL	CONTINUOUS	8. IDENTIFICATION MARKINGS TO CONFORM TO ASTM STANDARDS SPECIFIED IN THE APPROVED CONSTRUCTION DOCUMENTS	PERIODIC	APPLICABLE ASTM STD'S
5. PRIOR TO PLACEMENT OF COMPACTED FILL, OBSERVE SUBGRADE AND VERIFY THAT THE SITE HAS BEEN PREPARED PROPERLY.	PERIODIC	9. MANUFACTURER'S CERTIFIED TEST REPORTS	PERIODIC	
BC 1016.8 - CAST-IN-PLACE DEEP FOUNDATIONS		2. INSPECTION OF WELDING		
1. IN SPACE DURING OPERATIONS AND MAINTAIN COMPLETE AND ACCURATE RECORDS FOR EACH ELEMENT	CONTINUOUS	a. COLD-FORMED STEEL DECK FLOOR AND ROOF DECK WELDS	PERIODIC	AWS D1.3S
2. VERIFY PLACEMENT, LOCATION AND BULBNESS, CONFORM ELEMENT DIAMETERS, BELL DIAWATER IF APPLICABLE, LENGTHS, EMBEDMENT INTO SOIL (IF APPLICABLE) AND ADEQUATE END BEARING STRATA CAPACITY. RECORD CONCRETE OR GROUT VOLUMES.	CONTINUOUS	b. REINFORCING STEEL		NOT PERMITTED
3. FOR CONCRETE ELEMENTS, PERFORM ADDITIONAL INSPECTIONS IN ACCORDANCE WITH BC SECTION 1016.3		BC 1016.3 - CONCRETE CONSTRUCTION		
		1. INSPECT REINFORCING STEEL, INCLUDING PIRE STRESSING, TIEBARS, AND PLACEMENT	PERIODIC	ACI 308.1S 7.1.7-7.7 BC 1016.4
		2. INSPECTION OF REINFORCING STEEL WELDING IN ACCORDANCE WITH ABOVE REQUIREMENTS SET FORTH IN BC 1016.2 - STEEL CONSTRUCTION OTHER THAN STRUCTURAL STEEL	PERIODIC	AWS D1.3 ACI 308.3.3S
		3. INSPECTION OF ANCHORS CAST IN CONCRETE WHERE ALLOWABLE LOADS HAVE BEEN INCREASED OR WHERE STRENGTH DESIGN IS USED	PERIODIC	ACI 308.3.1S 21.2.28 BC 1016.4, 1009.1
		4. INSPECTION OF ANCHORS POST-INSTALLED IN HARDENED CONCRETE MEMBERS	PERIODIC	ACI 308.3.3S 6.1, 21.2.1 BC 1016.1
		5. VERIFYING USE OF REQUIRED DESIGN MIX	PERIODIC	ACI 308.3.5.4 BC 1016.2, 1016.2, 1016.3
		6. AT THE TIME THE FRESH CONCRETE IS SAMPLED TO FURNISH SPECIMENS FOR STRENGTH TEST, RECORD SLUMP AND AIR CONTENT TESTS, AND DETERMINE THE TEMPERATURE OF THE CONCRETE	CONTINUOUS	ASTM C 172 ASTM C 31 ACI 308.3.5.3 BC 1016.10
		7. INSPECTION OF CONCRETE AND PHOTOGRAPH PLACEMENT FOR PROPER APPLICATION TECHNIQUES	CONTINUOUS	ACI 308.3.5.5.1 BC 1016.6, 1016.7, 1016.8
		8. INSPECTION FOR MAINTENANCE OF SPECIFIED CURING TEMPERATURE AND TECHNIQUE	PERIODIC	ACI 308.3.11.1/3 BC 1016.9
		9. VERIFICATION OF IN-SITU CONCRETE STRENGTH PRIOR TO ERECTION OF TENDONS IN PRECAST/PRESTRESSED CONCRETE AND PRIOR TO REMOVAL OF SHORES AND FORMS FROM BEAMS AND STRUCTURAL SLABS	PERIODIC	ACI 308.6.2
		10. INSPECT FORMWORK FOR SHAPE, LOCATION AND OVERSIGHT OF THE CONCRETE MEMBER BEING FORMED	PERIODIC	ACI 308.6.1.1
		BC 1016.4 - MASONRY CONSTRUCTION		TMS 402-11A/CES-11A/ENCS-11 TMS-402-11A/CES-11A/ENCS-11
		EXEMPTIONS		
		1. EMPIRICALLY DESIGNED MASONRY: GLASS UNIT MASONRY, MASONRY VENEER DESIGNED BY BC SECTION 208, 2110 OR CHAPTER 18 RESPECTIVELY, WHERE THE ARE PART OF STRUCTURES CLASSIFIED AS RISK CATEGORY I	PERIODIC	BC 208.10
		2. MASONRY FOUNDATIONS SHALL CONSTRUCTED IN ACCORDANCE WITH BC TABLE 1907.1.9(1), 1907.1.9(2), 1907.1.9(3) AND 1907.1.9(4)		
		3. MASONRY FIREPLACES, MASONRY HEATERS OR MASONRY CHIMNEYS INSTALLED OR CONSTRUCTED IN ACCORDANCE WITH BC SECTION 2111, 2112 OR 2113, RESPECTIVELY		
		LEVEL 4, QUALITY ASSURANCE IN NONRESIDENTIAL FACILITIES WITH EMPIRICALLY DESIGNED MASONRY: GLASS UNIT MASONRY, MASONRY VENEER		
		VERIFY COMPLIANCE WITH THE APPROVED SUBMITTALS	PERIODIC	
		LEVEL 4, QUALITY ASSURANCE: ENGINEERED MASONRY IN NONRESIDENTIAL FACILITIES, ESSENTIAL FACILITIES WITH EMPIRICALLY DESIGNED MASONRY: GLASS UNIT MASONRY, MASONRY VENEER	PERIODIC	
		VERIFICATION OF SLUMP FILL AND VISUAL STABILITY INDEX AS DELIVERED TO PROJECT SITE	PERIODIC	ART 1.5.8(1.3)
		VERIFICATION OF Pn AND FAAC PRIOR TO CONSTRUCTION, EXCEPT WHERE SPECIFICALLY EXCEPTED	PERIODIC	ART 1.4.8
		1. VERIFY COMPLIANCE WITH THE APPROVED SUBMITTALS	PERIODIC	ART 1.5
		2. AS MASONRY CONSTRUCTION BEGINS, VERIFY THAT THE FOLLOWING ARE IN COMPLIANCE:		
		a. PROPORTIONS OF SITE PREPARED MORTAR	PERIODIC	ART 2.1.2.6.A
		3. CONSTRUCTION OF MORTAR JOINTS	PERIODIC	ART 3.3.8
		4. LOCATION OF REINFORCEMENT, CONNECTORS AND PRESTRESSING TENDONS AND ANCHORAGES	PERIODIC	ART 3.1.3.6.A
		5. PRIOR TO GROUTING, VERIFY THAT THE FOLLOWING ARE IN COMPLIANCE:		
		a. GROUT SPACE	PERIODIC	ART 3.2.2.3.2.F
		6. GRADE, TYPE, AND SIZE OF REINFORCEMENT AND ANCHOR BOLTS, AND PRESTRESSING TENDONS AND ANCHORAGES	PERIODIC	SEC 1.16 ART 3.2.4.1.4
		7. PLACEMENT OF REINFORCEMENT, CONNECTORS AND PRESTRESSING TENDONS AND ANCHORAGES	PERIODIC	SEC 1.16 ART 3.2.4.1.4, 3.2.6.A
		8. PROPORTIONS OF SITE PREPARED GROUT AND PRESTRESSING GROUT FOR BONDED TENDONS	PERIODIC	ART 2.8.2.4.1.6
		9. CONSTRUCTION OF MORTAR JOINTS	PERIODIC	ART 3.3.8
		4. VERIFY DURING CONSTRUCTION		
		a. SIZE AND LOCATION OF STRUCTURAL ELEMENTS	PERIODIC	ART 2.27
		7. TYPE, SIZE, AND LOCATION OF ANCHORS INCLUDING OTHER DETAILS OF ANCHORAGE OF TENDONS TO STRUCTURAL MEMBERS, FRAMES, OR OTHER CONSTRUCTION	PERIODIC	SEC 1.16.4.3, 1.07.1 SEC 2.16.7.3.2.3.5, 3.3.3.8(b)
		8. WELDING OF REINFORCEMENT	CONTINUOUS	SEC 2.16.7.3.2.3.5, 3.3.3.8(b)
		9. PREPARATION, CONSTRUCTION, AND PROTECTION OF MASONRY EXPOSED JOINT HEADERS, RELIEF AIR, OR JOINT HEADERS ABOVE RFT	PERIODIC	ART 1.6.3, 1.6.8
		10. OBSERVE PREPARATION OF ANCHORS, MORTAR SPECIMENS, MASONRY PRIMS	PERIODIC	ART 1.6.2.2.3, 1.6.2.2.3.3, 1.6.2.2.3.4, 1.6.2.2.

[illegible][illegible]

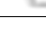	HOOPER STRUCTURAL SOLUTIONS 72 FIRM DRIVE, SUITE 2700 (216)486-1665 WWW.HOOPERSS.COM	
GENERAL NOTES:		
QNA: THE STRUCTURE IS DESIGNED IN ACCORDANCE WITH THE INTERNATIONAL BUILDING CODE (AS AMENDED) AND ADOPTED BY THE CITY OF SAN ANTONIO AND APPLICABLE UTILITY STANDARDS (AISC, AIA, ETC.)		
QNA: DESIGN CREDIBILITY		
DEAD LOADS = THE WEIGHT OF THE MATERIALS FORMING THE PERMANENT PART OF THE BUILDING. A PERMANENTLY APPLIED DEAD LOAD OF 5 PSF MUST BE APPLIED FOR MECHANICAL, ELECTRICAL, CONDUIT, CEILING, ETC.		
LIVE LOADS - IN ACCORDANCE WITH ASCE 7 REQUIRED		
DINING ROOMS AND RESTAURANTS 100 PSF STAIRS AND EXITS (UNLESS NOTED OTHERWISE) 100 PSF OR 3.0 LBS ROOFS 20 PSF MECHANICAL EQUIPMENT AS NOTED ON PLANS LIVE LOAD REDUCTIONS - NOT REQUIRED		
WIND LOADS - PER PER SECTION 1601		
DESIGN WIND SPEED 110 MPH ALLOWABLE STRESS DESIGN WIND SPEED, V ASD 85 MPH EXPOSURE CATEGORY B RISK CATEGORY I		
SNOW LOADS - PER PER SECTION 1608		
EARTHQUAKE LOADS - PER PER SECTION 1613		
IMPORTANCE FACTOR 1 OCCUPANCY CATEGORY II 2.5 SEC SPECTRAL RESPONSE ACCELERATION (Sa) 0.051 1 SEC SPECTRAL RESPONSE ACCELERATION (S1) 0.023 SITE CLASS D 2.5 SEC SPECTRAL RESPONSE COEFFICIENT (SD) 0.054 1 SEC SPECTRAL RESPONSE COEFFICIENT (S1) 0.028 SEISMIC DESIGN CATEGORY A ANALYSIS PROCEDURE ASCE 7-17 RADIALLY PROBABLE MAXIMUM MODIFICATION FACTOR N/A BASE SHEAR N/A		
GEOTECHNICAL REF. RE: GEOTECHNICAL REPORT		
SUB SECTIONS DISCUSS		
QNA: THE STRUCTURE HAS BEEN DESIGNED TO RESIST DEAD LOADS ONLY AS A COMPLETELY STRUCTURE. CONTRACTOR SHALL CONSIDER ALL LOADS APPLIED TO THE PARTIALLY COMPLETED STRUCTURE. THE STRUCTURE WILL BE CONSIDERED PARTIALLY COMPLETED UNTIL PERMANENT CONNECTIONS ARE MADE. ANY PROPOSED APPLICABLE OF CONSTRUCTION LOADS (WHICH EXCEED THE DESIGN LOADS) WILL REQUIRE REVISIONS TO THE FOUNDATION BEYOND THE SCOPE OF HOOPER.		
QNA: THE FOUNDATION DESIGN IS BASED ON THE GEOTECHNICAL, ANALYSIS STUDY PREPARED BY ROCK ENGINEERING & TESTING LABORATORY, LLC PROJECT NO. 022116, DATED MARCH 21, 2023. THE GEOTECHNICAL ENGINEERING STUDY REPORT INCLUDES OTHER RECOMMENDATIONS THAT EFFECT THE FOUNDATION DESIGN.		

<div> <div>BAR HOUSE, LLC</div> <div>NEW BAR HOUSE</div> </div>	<div>ARCHITECT</div> <div>Above Ground Design, PLLC</div> <div>200 Grooms Road</div> <div>Cluda, Texas 79108</div>
	<div>MEPT</div> <div>2902 N Flores Street</div> <div>San Antonio, Texas 78212</div> <div>HMD Engineering</div>
	<div>STRUCTURAL</div> <div>Hoffer Structural Solutions</div> <div>845 Proctor Road</div> <div>San Antonio, Texas 78258</div>
	<div>COPYRIGHT 2023</div>
	<div> <div> <div>808 NORTH ALAMO STREET</div> <div>SAN ANTONIO, TEXAS 78215</div> </div> <div> <div>ISSUE FOR PERMIT</div> </div> </div>

DEFERRED SUBMITTAL SCHEDULE	
<p>FOR THE PURPOSE OF THIS SECTION, DEFERRED SUBMITTALS ARE DEFINED AS AN ARCHITECT AND 70% OF THE BIC SUBMITTAL DOCUMENTS FOR DEFERRED SUBMITTAL ITEMS SHALL BE SUBMITTED TO THE ENGINEER, ARCHITECT AND BUILDING OFFICE FOR THEIR REVIEW FOR GENERAL CONFORMANCE WITH THE DESIGN OF THE BUILDING.</p>	
BUILDING COMPONENT	SUBMITTAL REQUIREMENT
LIGHT GAUGE METAL STUDS	DESIGNED, SHORED AND SEALED BY AN ENGINEER LICENSED IN THE STATE OF TEXAS
<h2 style="margin: 0;">SITE OBSERVATIONS BY STRUCTURAL ENGINEER</h2>	
<p>SITE OBSERVATIONS WILL BE CONDUCTED IN COMPLIANCE WITH SECTION 110 BY THE ENGINEER OF RECORD OR APPROVED AGENT AT THE STAGES OF CONSTRUCTION LISTED BELOW. THE CONTRACTOR SHALL NOTIFY THE ENGINEER WHEN CONSTRUCTION HAS REACHED THE STAGE LISTED BELOW AND THE WORKING DRAWINGS SHALL BE MADE AVAILABLE FOR OBSERVATION. APPROVAL AS A RESULT OF THE OBSERVATION SHALL NOT BE CONSTRUED TO BE AN APPROVAL, OR A VALIDATOR OR DISCREPANCY WITH THE DESIGN DOCUMENTS, OR THE CONCLUSION OF THE PROJECT. THE ENGINEER OF RECORD WILL SUBMIT TO THE BUILDING OFFICE A WRITTEN STATEMENT IN COMPLIANCE WITH SECTION 111.2 IF ALL VIOLATIONS HAVE BEEN REMEDIED. THAT THE PORTION (S) OF THE STRUCTURE OBSERVED ARE IN GENERAL CONFORMANCE WITH THE REQUIREMENTS OF THE STRUCTURAL PLANS AND SPECIFICATIONS. THESE OBSERVATIONS DO NOT CONSTITUTE THE SPECIAL INSPECTION REQUIREMENTS OF THE BIC SECTION 104.</p>	
OBSERVATION	STAGE OF CONSTRUCTION
FOUNDATION/FOOTING	AFTER EXCAVATIONS FOR FOOTINGS ARE COMPLETE AND ANY REQUIRED REINFORCING STEEL IS IN PLACE FOR CONCRETE FOUNDATIONS. ANY REQUIRED FORMS SHALL BE IN PLACE. MATERIAL FOR THE FOUNDATION SHALL BE ONSITE EXCEPT WHERE CONCRETE IS READY MAID. DEEP FOUNDED FOOTINGS (PIERS) SHALL HAVE THE FIRST POLE COMPLETE AND TESTING LAB OR GEOTECHNICAL REPRESENTATIVE ONSITE.
WOOD FRAME	ALL WOOD FRAMING IN PLACE, WALL, ROOF AND FLOOR SHEATHING IN PLACE, HOLDDOVING, CLIPS AND HANGERS INSTALLED. PRIOR TO ROOFING, HOUSEWRAP AND INSULATION INSTALLATION.
STEEL FRAME	ALL STEEL FRAMING ERECTED & DECK INSTALLED, PRIOR TO CONCRETE FLOOR, ROOFING INSTALLATION, OR METAL STUD INSTALLATION.

OBSERVATION	STAGE OF CONSTRUCTION
FOUNDATION/FOOTING	AFTER EXCAVATIONS FOR FOOTINGS ARE COMPLETE AND ANY REQUIRED REINFORCING STEEL IS IN PLACE, FOR CONCRETE FOUNDATIONS, ANY REQUIRED FORMS SHALL BE IN PLACE. MATERIALS FOR THE FOUNDATION SHALL BE ON-SITE EXCEPT WHERE CONCRETE IS READY MIXED. PAVED FOOTINGS (PIERS) SHOULD HAVE THE FIRST RAZE COMPLETE AND TESTING LAB OR GEOTECHNICAL REPRESENTATIVE ON-SITE.
WOOD FRAME	ALL WOOD FRAMING IN PLACE, WALL, ROOF AND FLOOR OR CEILING IN PLACE. HOLDINGS, CLIPS AND HANGING INSTALLED. PRIOR TO ROOFING, LEAKS WRAP AND INSULATION INSTALLATION.
STEEL FRAME	ALL STEEL FRAMING ERECTED & DECK INSTALLED, PRIOR TO CONCRETE POUR, ROOFING INSTALLATION, OR METAL STUD INSTALLATION.



KEY PLAN

 PLAN NORTH

 TRUE NORTH



4/20/23


[illegible]

ISSUE FOR PERMIT
GENERAL NOTES

\$1.00

8/3/2023 8:43:25 PM

1.  PROVIDE (N) 10'0" CONCRETE PIERS AS NEEDED TO MAINTAIN 6'-0" MAX SPACING ON BEAMS CRAWL.
2. PROVIDE ADDITIONAL 2X8 FRAMING TO MAINTAIN
 - 16" SPACING MAX. @ 8'-0" MAX SPAN
 - 12" SPACING MAX. @ 9'-0" MAX SPAN.

 TEXAS ONE CALL SYSTEM CALL BEFORE YOU DIG
DIG UNDERGROUND UTILITIES 1-800-245-4545

CALL 48 HOURS BEFORE YOU DIG, DRILL, OR BLAST.




BAR HOUSE, LLC
NEW BAR HOUSE



ISSUE FOR PERMIT

FOUNDATION PLAN

\$2.00

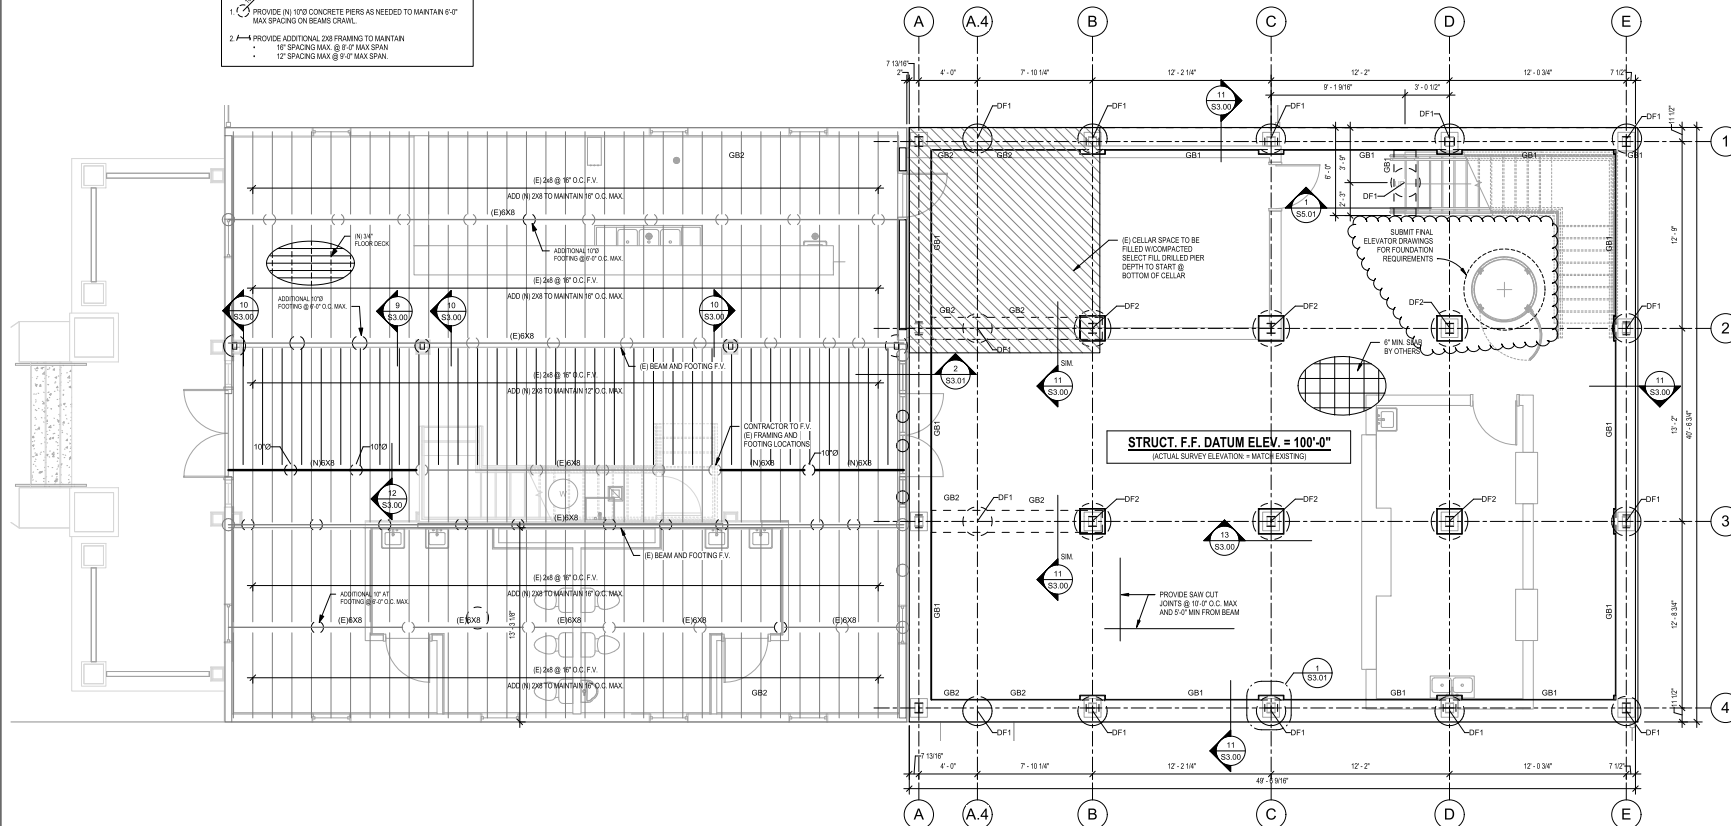

② OVERALL FOUNDATION PLAN
1/4" = 1'-0"

CHECKED BY: Checker

DRAWN BY: Author

8/3/2023 8:43:25 PM


- PLAN NOTES:**
1. SC1 - REF. STEEL COLUMN SCHEDULE ON SHEET S5.00
 2. T.O.S. - DENOTES TOP OF STEEL ELEVATION RELATIVE TO STRUCTURAL DATUM
 3. T.O.P. - DENOTES TOP OF PARAPET RELATIVE TO STRUCTURAL DATUM
 4. T.O.J. - DENOTES TOP OF STEEL JOIST RELATIVE TO STRUCTURAL DATUM
 5. T.O.C. - DENOTES TOP OF CONCRETE ELEVATION RELATIVE TO STRUCTURAL DATUM
 6. ▶ DENOTES MOMENT CONNECTION REF. S55.00

HOFFER STRUCTURAL SOLUTIONS
TX FIRM REG NO. F21736
C210646-865
WWW.HOFFERSS.COM



ARCHITECT	Above Ground Design, PLLC 2001 Grooms Road Cibola, Texas 78108
MEPT	HMS Engineering 2902 N Flores Street San Antonio, Texas 78212
STRUCTURAL	Hoffer Structural Solutions 945 Preston Road San Antonio, Texas 78209
COPYRIGHT 2023	

BAR HOUSE, LLC
NEW BAR HOUSE

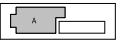

KEY PLAN


PLAN NORTH
TRUE NORTH



CLIENT BAR HOUSE, LLC		
PROJECT NUMBER 21003		
DATE ABRIL 20, 2023		
REVISIONS		
No.	Description	Date
1	COSA ADD 1	8-3-23


ISSUE FOR PERMIT
SECOND FLOOR FRAMING PLAN

S2.01

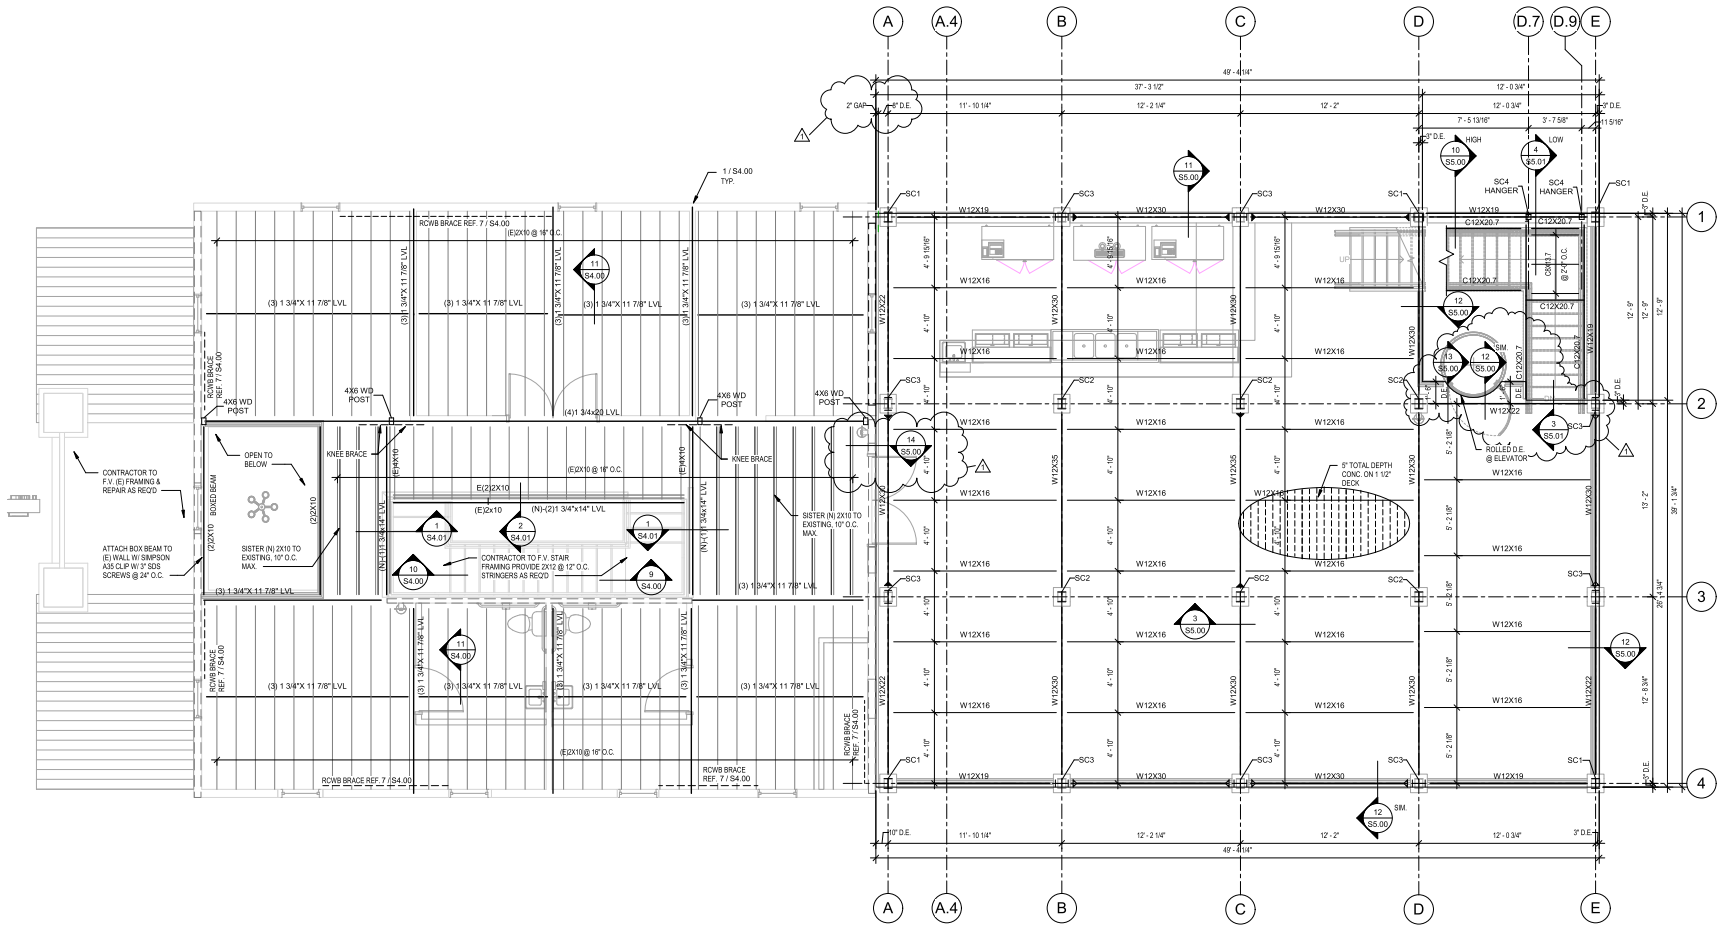

① SECOND FLOOR FRAMING PLAN
1/4" = 1'-0"

① THIRD FLOOR FRAMING PLAN
1/4" = 1'-0"

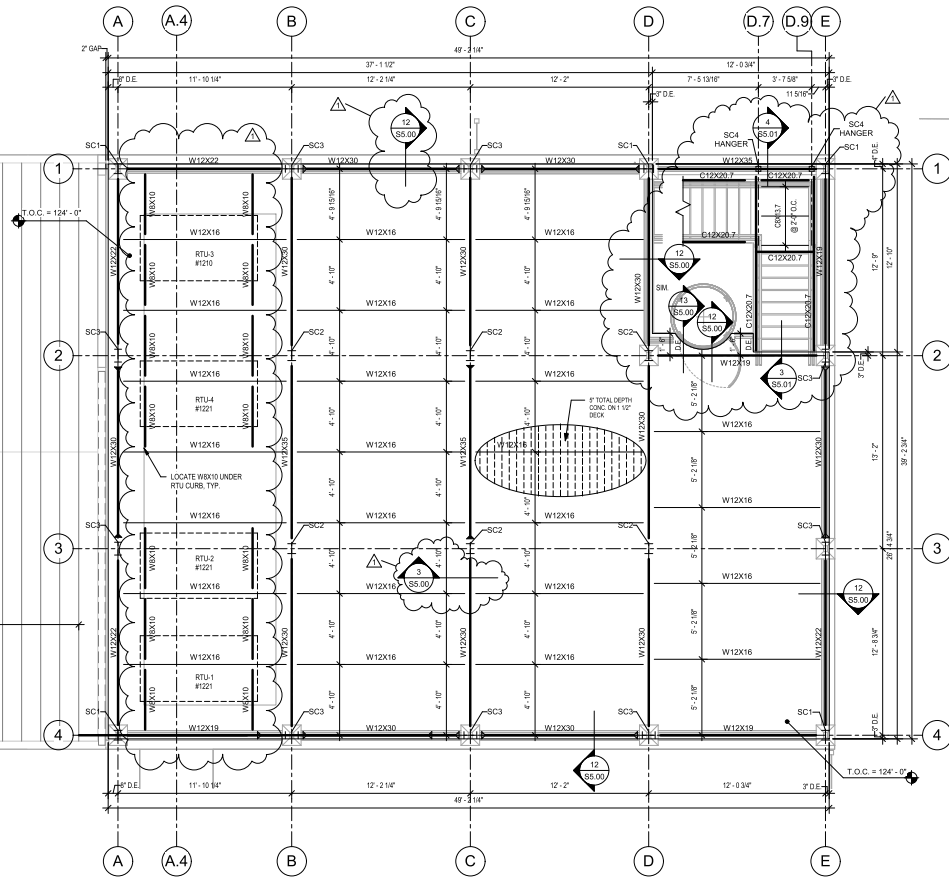


- PLAN NOTES:**
1. SC1 - REF. STEEL COLUMN SCHEDULE ON SHEET SS.00
 2. T.O.S. - DENOTES TOP OF STEEL ELEVATION RELATIVE TO STRUCTURAL DATUM
 3. T.O.PARAPET - DENOTES TOP OF PARAPET RELATIVE TO STRUCTURAL DATUM
 4. T.O.J. - DENOTES TOP OF STEEL JOIST RELATIVE TO STRUCTURAL DATUM
 5. T.O.C. - DENOTES TOP OF CONCRETE ELEVATION RELATIVE TO STRUCTURAL DATUM
 6. M - DENOTES MOMENT CONNECTION REF. S55.00

HOFFER STRUCTURAL SOLUTIONS
TX FIRM REG NO. F21736
270546-865
WWW.HOFFERSS.COM



ARCHITECT	Above Ground Design, PLLC 2001 Grooms Road Cibola, Texas 78108
MEPT	HMS Engineering 2902 N Flores Street San Antonio, Texas 78212
STRUCTURAL	Hoffer Structural Solutions 360 Prosper Road San Antonio, Texas 78258
COPYRIGHT 2023	

BAR HOUSE, LLC
NEW BAR HOUSE

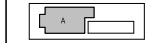


KEY PLAN




CLIENT BAR HOUSE, LLC		
PROJECT NUMBER 21003		
DATE ABRIL 20, 2023		
REVISIONS		
No.	Description	Date
1	COSA ADD 1	8-3-23

ISSUE FOR PERMIT
**THIRD FLOOR
FRAMING PLAN**


S2.02

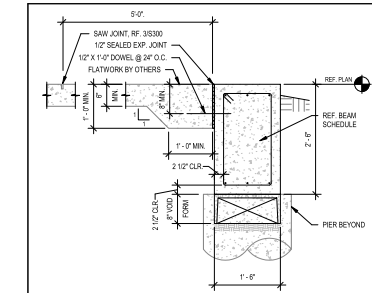



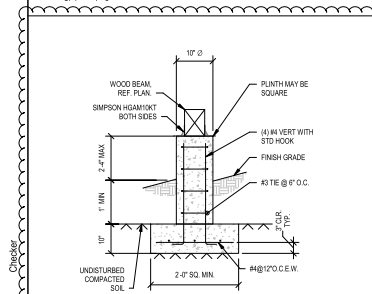



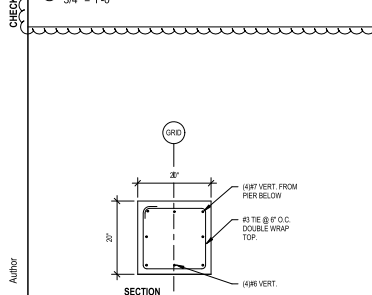



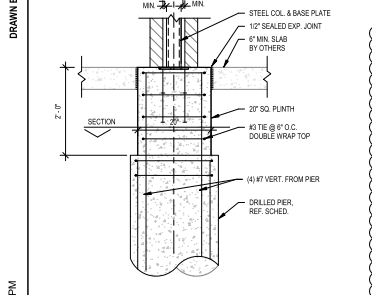



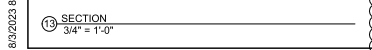



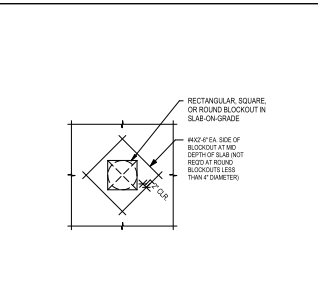



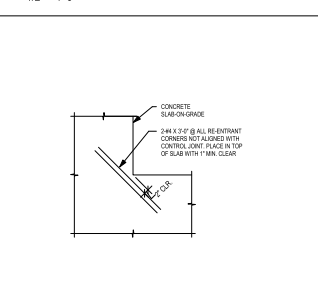



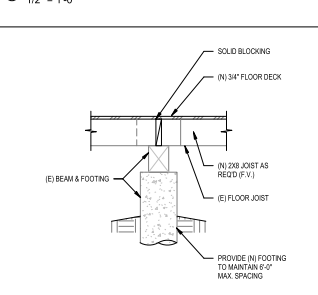



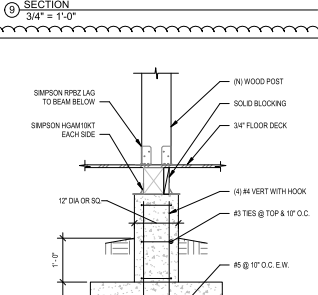



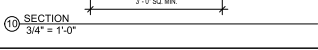



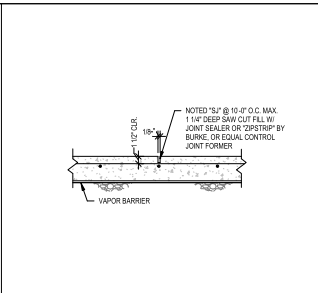



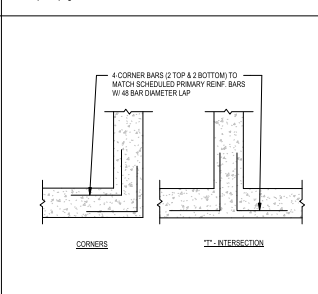



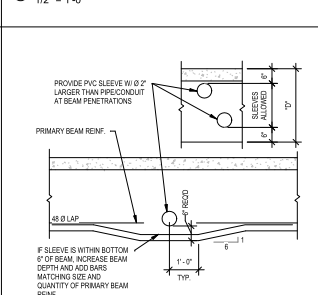



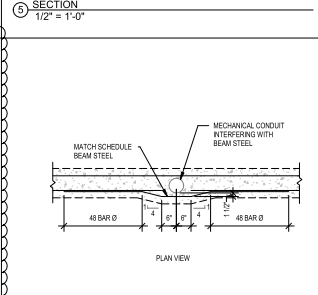



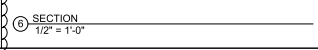



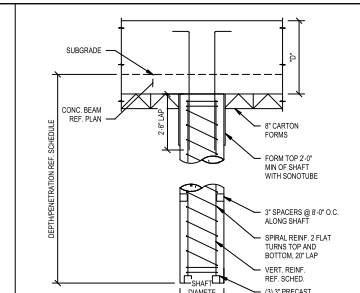



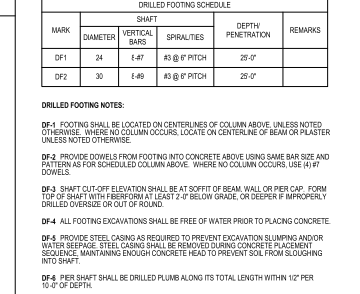



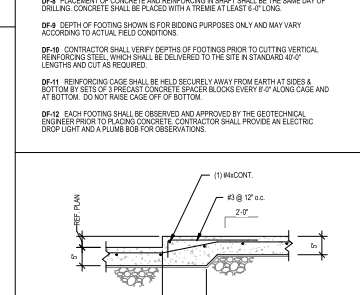



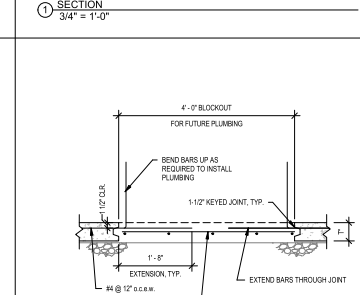


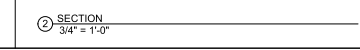




HOFFER STRUCTURAL SOLUTIONS
TX FIRM REG NO. 21776
270546-865
WWW.HOFFERS.COM

CONCRETE NOTES:

CN-1 ALL CONCRETE WORK SHALL BE IN ACCORDANCE WITH THE LATEST EDITION OF ACI 301 SPECIFICATION FOR STRUCTURAL CONCRETE BUILDINGS AND ACI 318 BUILDING CODE REQUIREMENTS FOR REINFORCED CONCRETE.

CN-2 CONSTRUCTION TOLERANCES SHALL CONFORM TO ACI 117 STANDARD TOLERANCES FOR CONCRETE CONSTRUCTION AND MATERIALS.

CN-3 CONTRACTOR SHALL SUBMIT THE FOLLOWING SHOP DRAWINGS:

REINFORCING STEEL - DETAILING FABRICATION AND ERECTION OF ALL REINFORCING BARS INCLUDING ACCESSORIES IN ACCORDANCE WITH THE LATEST EDITION OF ACI 315 MANUAL OF STANDARD PRACTICES FOR DETAILING REINFORCED CONCRETE.

CONCRETE MIX DESIGN - FOR EACH TYPE OF CONCRETE TO BE USED BASED ON AGGREGATE SIZE AND CEMENT PROPORTION. MIX DESIGN SHALL INCLUDE CERTIFICATION OF COMPLIANCE WITH SPECIFIED MATERIALS BASED ON FIELD SAMPLES AND COMPRESSION TEST DATA FOR LABORATORY PREPARED TRIAL MIX OR FIELD TEST DATA FOR SPECIFIED MIX. FIELD TEST DATA SHALL BE FROM AN IDEAL MIX DESIGN SUPPLIED FROM PROPOSED BATCH PLANT AND SHALL HAVE BEEN PREPARED WITHIN THE PRECEDING 90 MONTHS.

CN-4 CONTRACTOR SHALL DESIGN, CONSTRUCT, ERECT, SHORE, BRACE AND MAINTAIN FORM WORK ACCORDING TO ACI 301. WOOD FORM WORK SHALL BE #2 COMMON OR BETTER PLYWOOD. EXPOSED SURFACES SHALL BE NEW OR LIKE NEW MOISTURE RESISTANT FIBER FORM PLYWOOD. LIGHTLY COAT FORMS WITH NON-STAINING FORM OIL. REMOVE SURPLUS OIL.

CN-5 REINFORCING STEEL SHALL BE DOMESTIC NEW BULLET STEEL CONFORMING TO ASTM A615 GRADE 60, EXCEPT TIES AND STRUTS MAY BE GRADE 40 BARS DESIGNATED AS CONTINUOUS SHALL BE LAPPED #4 BAR DIAMETERS, WELDED WIRE FABRIC SHALL CONFORM TO ASTM A182 AND SHALL BE LAPPED #4 MINIMUM AT SPICE POINTS OR 1/2 MESHES, WHICHEVER IS GREATER.

CN-6 PORTLAND CEMENT SHALL COMPLY WITH ASTM C-150, TYPE 1. FLY ASH SHALL CONFORM TO ASTM C-955. NORMAL WEIGHT AGGREGATE SHALL COMPLY WITH ASTM C-33. WATER SHALL BE POTABLE AND COMPLY WITH ASTM C-1602. ADMIXTURES SHALL COMPLY WITH THE FOLLOWING PROVISIONS: WATER REDUCTION AND SETTING TIME MODIFICATION: ASTM C-494. PRODUCING FLOWING CONCRETE: ASTM C-1017. AIR ENTRAINMENT: ASTM C-260. INHIBITING CHLORIDE-INDUCED CORROSION: ASTM C-1892.

CN-7 CONCRETE SHALL BE NORMAL WEIGHT, LABORATORY DESIGNED TO DEVELOP MINIMUM SPECIFIED 28 DAY COMPRESSIVE STRENGTH AND PROPORTIONED AS FOLLOWS:

CONCRETE MIXTURE REQUIREMENTS				
APPLICATION	DESIGN STRENGTH (PSI)	MIX WATER RATIO	MAX AGG. SIZE	EXPOSURE CLASS
FOOTINGS & BEAMS	4000	0.55	1 1/2	F1-WC-SG-C3
ELEVATED SLAB	3000	N/A	3/4	F1-WC-SG-C3
DRILLED FOOTING	3000	N/A	1 1/2	F5-WC-SG-C3

WATER RATIOS NOT SPECIFIED SHALL BE AS REQUIRED TO ACHIEVE DESIGN STRENGTH IF AN EXPOSURE CLASS IS SPECIFIED. PROVIDE MIX DESIGNS PER ACI 301.

CN-8 ALL REINFORCING STEEL SHALL BE FREE OF RUST, SCALE, AND DRIED CONCRETE. SHALL BE ACCURATELY BENT AND SECURELY TIED INTO POSITION TO PREVENT MOVEMENT DURING CONCRETE PLACEMENT. RASING REINFORCEMENT DURING POUR WILL NOT BE PERMITTED.

CN-9 CONCRETE COVER SHALL BE AS FOLLOWS, UNLESS NOTED OTHERWISE:

- CONCRETE CAST AGAINST EARTH - 2"
- CONCRETE EXPOSED TO EARTH OR WEATHER: BARS 3/4" AND LARGER IN DIAMETER - 1 INCHES; BARS SMALLER THAN 3/4" DIAMETER - 1 1/2"
- CONCRETE NOT EXPOSED TO WEATHER OR GROUND: SLAB ON GRADE - 1 1/2" FROM TOP OF SLAB; JOINTS, BEAMS AND COLUMNS - 1 1/2"

CN-10 SET AND BUILD ANCHORAGE AND OTHER EMBEDDED ITEMS INTO FORM WORK AS REQUIRED FOR OTHER WORK THAT IS ATTACHED TO OR SUPPORTED BY CONCRETE. COORDINATE WITH OTHER DISCIPLINES.

CN-11 CONCRETE SHALL BE MIXED AND DELIVERED IN ACCORDANCE WITH ASTM C-94 STANDARD SPECIFICATION FOR READY-MIXED CONCRETE.

CN-12 CONCRETE WHEN DEPOSITED SHALL HAVE A TEMPERATURE NOT BELOW 50°F OR ABOVE 90°F. APPROPRIATE MEASURES SHALL BE TAKEN TO MAINTAIN TEMPERATURE RANGE AND PREVENT WATER EVAPORATION FOR 3 DAYS AFTER PLACEMENT. SALT OR OTHER CHEMICALS SHALL NOT BE ADDED TO PREVENT FREEZING.

CN-13 CONCRETE SHALL BE CONVEYED TO AND DEPOSITED IN FORM WORK NEAR ITS FINAL POSITION. WITH A FREE VERTICAL DROP NOT EXCEEDING 3 FEET. PLACE CONCRETE IN 12 INCH MAXIMUM LAYERS AND COMPACT EACH LAYER BY MECHANICAL VIBRATING.

CN-14 CONSTRUCTION JOINTS IN MONOLITHIC FRAMING SHALL HAVE PRIOR APPROVAL OF THE ARCHITECT/ENGINEER, U.N.D.

CN-15 SCREENING, RES-STRAIGHTENING, AND FINISHING OPERATIONS SHALL COMPLY WITH ACI 302.1R. COORDINATE ALL FINISHES WITH ARCHITECTURAL DRAWINGS AND FLOOR FINISH REQUIREMENTS. CAREFULLY TOOL ALL EXPOSED EDGES.

CN-16 CURE CONCRETE FOR AT LEAST SEVEN DAYS BY MOISTURE CURING, SEALED MOISTURE RETAINING COVER CURING, OR A CLEAR WATERBORNE CURING COMPOUND CONFORMING TO ASTM C-492.


CN-17 SIDE FORMS MAY BE REMOVED AFTER CUMULATIVE CURING AT NOT LESS THAN 90°F FOR 24 HOURS AFTER PLACING CONCRETE. SOFFITS OF SUSPENDED CONCRETE MAY BE REMOVED AFTER CURING FOR AT LEAST SEVEN DAYS AND COMPRESSION TEST RESULTS INDICATE AT LEAST 75% OF SPECIFIED DESIGN STRENGTH. RESHORE AS REQUIRED FOR CONSTRUCTION LOADS.

CN-18 PATCH HONEYCOMB, TIE HOLES, AND MINOR DEFECTS WITH ONE PART CEMENT AND TWO PARTS SAND IMMEDIATELY AFTER REMOVING FORMS.

CN-19 EXPOSED CONCRETE SHALL BE RUBBED WITH CARBORUNDUM BRICKS AND WATER AFTER 48 HOURS BUT BEFORE ONE WEEK. PLASTERING SURFACES WILL NOT BE PERMITTED.

CN-20 NOTIFY ENGINEER WHEN FORM WORK AND REINFORCING IS IN PLACE SO ENGINEER CAN OBSERVE REINFORCING STEEL PRIOR TO ALL CONCRETE POURS.

CN-21 INDEPENDENT TESTING LABORATORY SHALL TAKE SAMPLES AND PERFORM SLUMP AND COMPRESSION TESTS PER ASTM C-39 ON CONCRETE PLACED EACH DAY AT THE RATE OF ONE SET OF FOUR CYLINDERS FOR EACH BS CYL. OR FRACTION THEREOF WITH A MINIMUM INTERVAL OF 30 CYL. VOLS. BETWEEN SAMPLES.



BAR HOUSE, LLC
NEW BAR HOUSE

ARCHITECT Above Ground Design, PLLC
2001 Grooms Road
Cibola, Texas 75108

MEPT HNS Engineering
2902 N Flores Street
San Antonio, Texas 78212

STRUCTURAL Hoffer Structural Solutions
945 Pryor Road
San Antonio, Texas 78258
COPYRIGHT 2023

KEY PLAN
PLAN NORTH
TRUE NORTH

127512
8-3-23

CLIENT BAR HOUSE, LLC
PROJECT NUMBER 21003
DATE APRIL 20, 2023

REVISIONS

No.	Description	Date
1	COISA AND 1	8-3-23

ISSUE FOR PERMIT


SLAB ON GRADE NOTES AND DETAILS

S3.00


CHECKED BY: Checker

DRAWN BY: Author

4/20/2023 5:41:13 PM

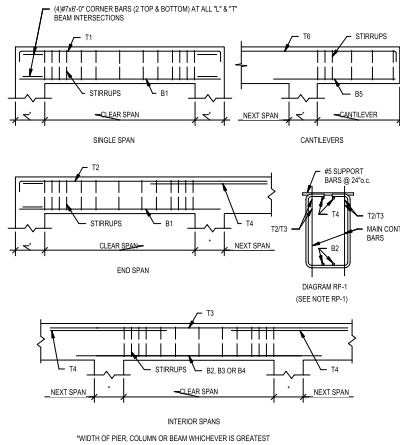


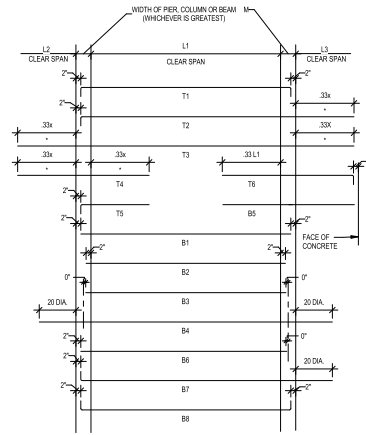

④ DETAIL
3/4" = 1'-0"




③ DETAIL
1/2" = 1'-0"

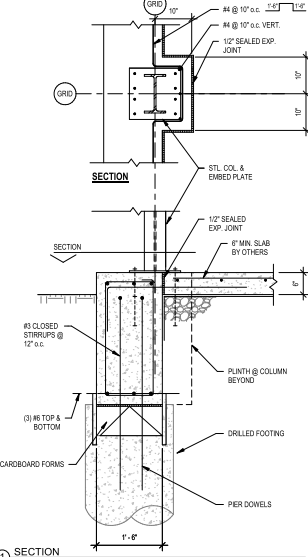HOFFER STRUCTURAL SOLUTIONS
TX FIRM REG NO. F21726
270566-985
WWW.HOFFERS.COM



CONCRETE BEAM SCHEDULE														
MARK	SIZE			MAIN REINFORCING						STIRRUPS		REMARKS		
	W	D	SECT	TOP BARS		BOTTOM BARS		TOP BARS AT SUPPORT		SIZE	TYPE		SPACING AT EACH END OF BEAM	
				REINF.	TYPE	REINF.	TYPE	REINF.	TYPE					SUPP.
GB1	18"	30"		(1)B6	T3	(3)B6	B4	-	-	-	#3	2	1@2.4@6 B4@10	PROVIDE T2 & B7 BARS @ END SPANS
GB2	18"	30"		(1)B6	T3	(3)B6	B4	-	-	-	#3	2	1@2.4@6 B4@10	

② SECTION
3/4" = 1'-0"

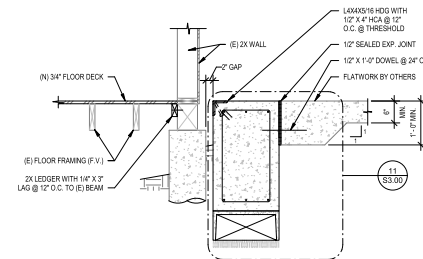

REINFORCING PLACEMENT NOTES

- #B1 WHERE BAR TYPES T2 AND T3 LAP OVER SUPPORTS, BUNDLE VERTICALLY TO PREVENT CONGESTION. IF BAR TYPE T4 ARE ALSO SCHEDULED, USE #5 SUPPORT BARS TO HOLD THEM NEAR MIDDLE OF STIRRUP WIDTH AS SHOWN IN DIAGRAM RP-1.
- #B2 FABRICATE OFFSET BENDS IN MAIN REINFORCING BARS FOR FLOOR DROPS, OFFSET BEAM FACES, BRICK LUGS, VARIATIONS, ETC. SHOW BEND BARS ON 1/8" SCALE AND VERIFY STIRRUP SHAPE ACCORDINGLY.
- #B3 UNLESS NOTED OTHERWISE, REBARS SHALL HAVE CONCRETE COVER AS FOLLOWS: STIRRUPS AND TIES = 1/2" AND SLABS = 3/4".
- #B4 WHERE BEAM DEPTH EXCEEDS 30", PROVIDE ADDITIONAL CONTINUOUS AN HORIZONTAL BARS IN EACH FACE SPACED NOT MORE THAN 10".
- #B5 BARS NOTED IN SCHEDULE AS "CONT" SHALL BE FULLY CONTINUOUS USING STOCK LENGTH STEEL AND RANDOM PLACES OF 40 BAR DIAMETERS.
- #B6 DISTANCE "X" SHALL BE THE LARGEST DISTANCE BETWEEN SUPPORTS OF THE SPAN L1, L2 OR L3 AND SHALL BE MADE THE SAME AMOUNT AT THE LEFT AND RIGHT ENDS SO THAT BARS ARE PLACED SYMMETRICALLY IN THE SPAN.
- #B7 SIZES/THROUGHBARS SHALL HAVE INDIVIDUAL APPROVAL OF THE ENGINEER AND MAY REQUIRE AN INCREASE IN BEAM SIZE.

ARCHITECT Above Ground Design, PLLC
2001 Grooms Road
Cibola, Texas 79108

MEPT HNS Engineering
2902 N Flores Street
San Antonio, Texas 78212

STRUCTURAL Hoffer Structural Solutions
945 Phyllis Road
San Antonio, Texas 78258

COPYRIGHT 2023

BAR HOUSE, LLC
NEW BAR HOUSE

101 NORTH A AND STREET
SAN ANTONIO TEXAS 78215

ISSUE FOR PERMIT

CLIENT
BAR HOUSE, LLC

PROJECT NUMBER
21003

DATE
APRIL 20, 2023

REVISIONS

No.	Description	Date

ISSUE FOR PERMIT

SLAB ON GRADE
DETAILS


S3.01

CHECKED BY: Checker


DRAWN BY: Author

4/20/2023 5:41:16 PM

HOFFER STRUCTURAL SOLUTIONS
TX FIRM REG NO. F21726
270546-1865
WWW.HOFFERSS.COM

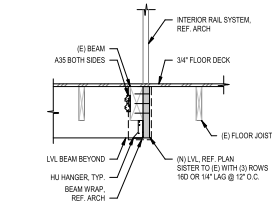

① SECTION
3/4" = 1'-0"

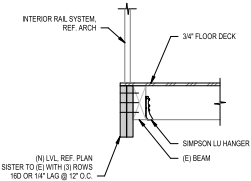

② SECTION
3/4" = 1'-0"



ARCHITECT Above Ground Design, PLLC
2001 Grooms Road
Cibola, Texas 78108
MEPT HNS Engineering
2902 N Flores Street
San Antonio, Texas 78212
STRUCTURAL Hoffer Structural Solutions
940 Prosper Road
San Antonio, Texas 78258
COPYRIGHT 2023

BAR HOUSE, LLC
NEW BAR HOUSE

300 NORTH LAND STREET
SAN ANTONIO TEXAS 78205
ISSUE FOR PERMIT



KEY PLAN

PLAN NORTH
TRUE NORTH



CLIENT BAR HOUSE, LLC		
PROJECT NUMBER 21003		
DATE	APRIL 20, 2023	
REVISIONS		
No.	Description	Date

ISSUE FOR PERMIT
**WOOD FRAMING
DETAILS**





S4.01

CHECKED BY: Checker

DRAWN BY: Author

4/20/2023 5:41:17 PM

HOFFER STRUCTURAL SOLUTIONS
TX FIRM REG NO. F21726
C701646-1665
WWW.HOFFERSS.COM

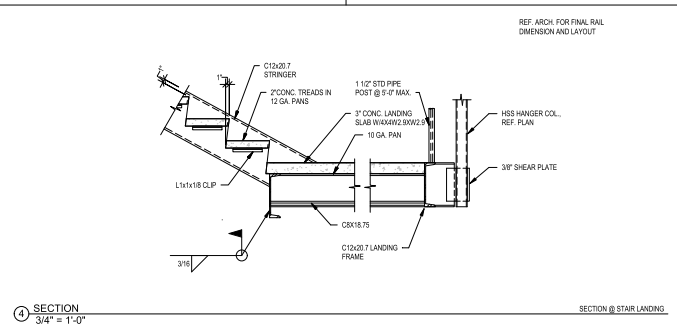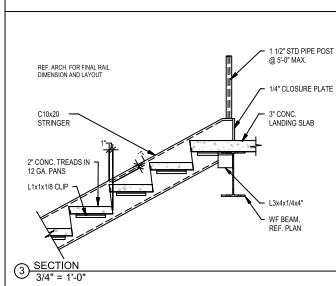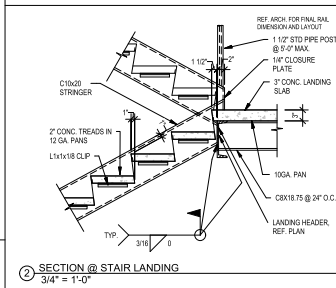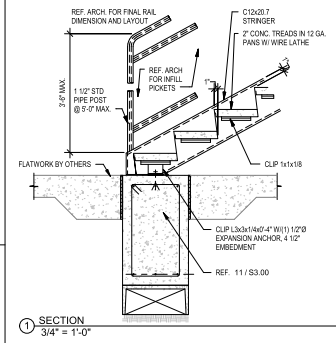

ARCHITECT Above Ground Design, PLLC
2001 Grooms Road
Cibola, Texas 78108
MEPT HNS Engineering
2902 N Flores Street
San Antonio, Texas 78212
STRUCTURAL Hoffer Structural Solutions
360 Prosper Road
San Antonio, Texas 78258
COPYRIGHT 2023

BAR HOUSE, LLC
NEW BAR HOUSE

360 NORTH A AND STREET
SAN ANTONIO TEXAS 78215
ISSUE FOR PERMIT



KEY PLAN

PLAN NORTH
TRUE NORTH



CLIENT BAR HOUSE, LLC		
PROJECT NUMBER 21003		
DATE	APRIL 20, 2023	
REVISIONS		
No.	Description	Date


ISSUE FOR PERMIT
STEEL NOTES AND
DETAILS

S5.01

8/3/2023 9:42:26 PM

DRAWN BY: Author

CHECKED BY: Checker

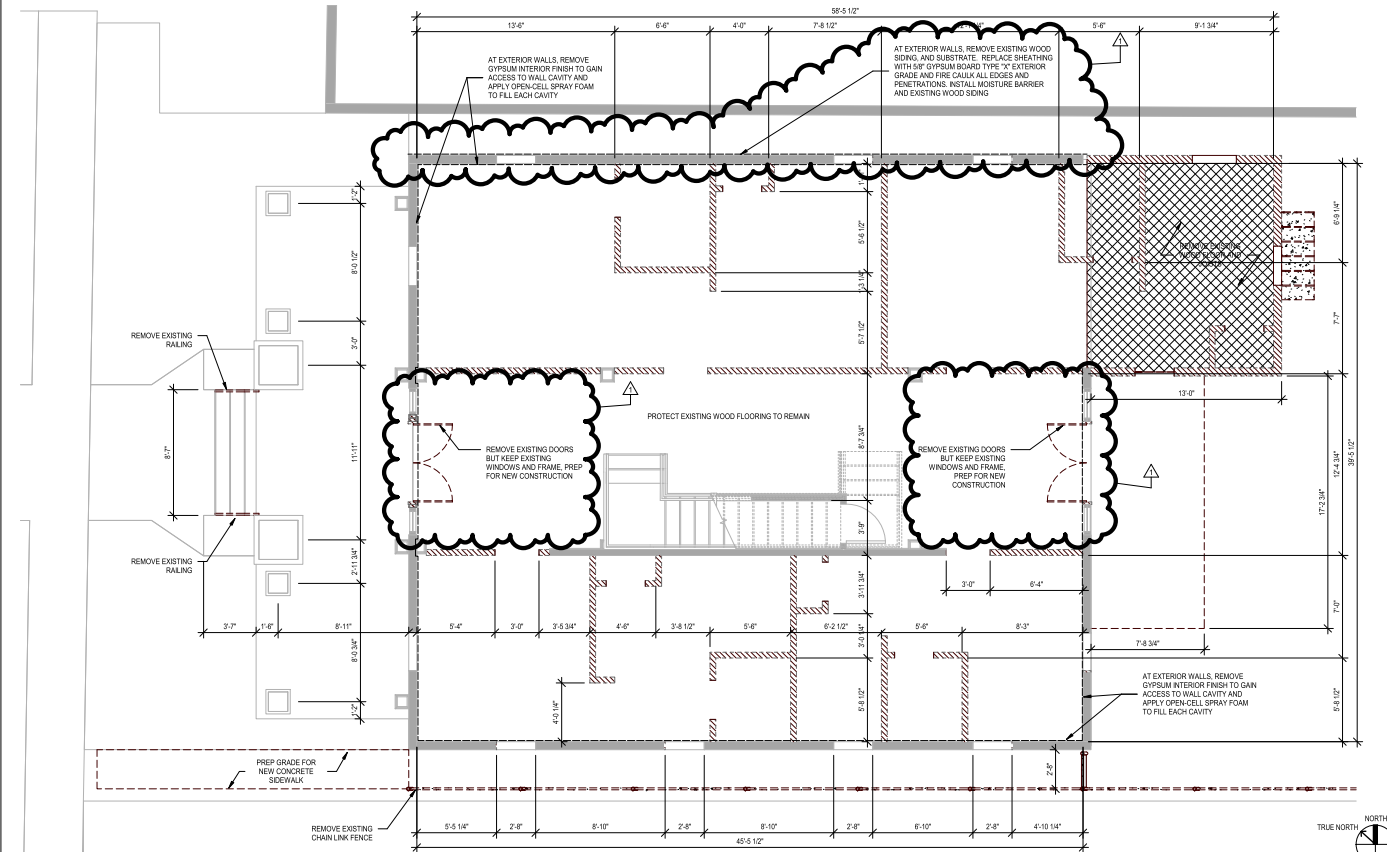

5 DEMOLITION AREA A FIRST FLOOR PLAN
1/4\" = 1'-0"

GENERAL DEMOLITION NOTES


- DEMOLITION PLANS INDICATE SOME OF THE SCOPE OF WORK INVOLVED FOR THE DEMOLITION PHASE OF THIS PROJECT. CONTRACTOR SHALL REVIEW ALL SHEETS FOR ADDITIONAL DEMOLITION SCOPE.
- CONTRACTOR SHALL VERIFY EXISTING SITE AND BUILDING CONDITIONS AND DIMENSIONS IN THE FIELD PRIOR TO DEMOLITION ACTIVITIES AND WORK.
- CONTRACTOR SHALL NOTIFY ARCHITECT OF ANY DISCREPANCIES IN WRITING.
- CONTRACTOR SHALL NOTIFY ARCHITECT AND OWNER OF ANY POSSIBLE ASBESTOS OR LEAD-CONTAINING MATERIALS DISCOVERED BEFORE PROCEEDING WITH WORK. PROTECT INTERIOR CONSTRUCTION TO REMAIN DURING DEMOLITION AND CONSTRUCTION.
- CONTRACTOR SHALL OBTAIN ALL NECESSARY PERMITS BEFORE COMMENCING WORK.
- AFTER AWARD OF THE CONTRACT, CHANGE ORDER REQUESTS FOR ADDITIONAL MONEY WILL NOT BE APPROVED IF THE WORK COULD HAVE BEEN ANTICIPATED DURING A SITE VISIT BY THE CONTRACTOR.
- CONTRACTOR SHALL NOT SCALE DRAWINGS.
- CONTRACTOR SHALL PROVIDE ALL NECESSARY TEMPORARY SHORING, TEMPORARY BRACING, AND OR TEMPORARY SUPPORTS AS REQUIRED TO MAINTAIN STRUCTURAL INTEGRITY OF EXISTING STRUCTURE TO REMAIN AND OR EXISTING BUILDING ELEMENTS TO REMAIN.
- CONTRACTOR IS TO VERIFY THE EXACT LOCATION OF ALL EXISTING UTILITIES PRIOR TO DEMOLITION ACTIVITIES AND WORK.
- CONTRACTOR SHALL REMOVE TRASH AND DEBRIS REGULARLY AS NECESSARY TO ELIMINATE INTERFERENCE WITH ROADS, STREET, WALKS, AND ALL OTHER ADJACENT FACILITIES.
- CONTRACTOR SHALL REMOVE TRASH AND DEBRIS FROM THE SITE ON A DAILY BASIS.
- CONTRACTOR SHALL REPAIR, REPLACE, OR PATCH EXISTING BUILDINGS, DRIVEWAYS, SIDEWALKS, CANPES, AND OR PARKING AREAS DAMAGED, MODIFIED, AND OR DISTURBED BY DEMOLITION WORK AT NO COST TO THE OWNER.
- ALL EXISTING EQUIPMENT THAT REMAINS SHALL BE PROTECTED DURING DEMOLITION AND OR CONSTRUCTION TO PREVENT DAMAGE. ANY DAMAGE TO REMAINING EXISTING EQUIPMENT SUSTAINED DURING DEMOLITION AND OR CONSTRUCTION SHALL BE EQUIVALENTLY REPLACED OR EQUIVALENTLY REPAIRED AT NO COST TO THE OWNER.
- CONTRACTOR SHALL PROVIDE TRAFFIC HANDLING MEASURES TO PROTECT THE GENERAL PUBLIC AT ALL TIMES, AS NECESSARY AND AS REQUIRED BY AUTHORITIES HAVING JURISDICTION.
- DO NOT INTERRUPT EXISTING UTILITIES, EXCEPT WHEN AUTHORIZED IN WRITING BY AUTHORITIES HAVING JURISDICTION. PROVIDE TEMPORARY SERVICES DURING INTERRUPTIONS TO EXISTING UTILITIES, AS ACCEPTABLE TO AUTHORITIES HAVING JURISDICTION.
- WHEN UTILITY SERVICES ARE REQUIRED TO BE REMOVED, RELOCATED, OR ABANDONED, PROVIDE BYPASS CONNECTIONS TO MAINTAIN CONTINUITY OF SERVICE BEFORE PROCEEDING WITH DEMOLITION.
- CONTRACTOR SHALL CONTACT ALL UTILITY COMPANIES INCLUDING BUT NOT LIMITED TO THE FOLLOWING: ELECTRIC, GAS, WATER, TELEPHONE, STORM SEWER, AND SANITARY SEWER FOR FIELD LOCATION OF ALL UNDERGROUND AND OVERHEAD UTILITY LINES. PRIOR TO COMMENCEMENT OF ANY DEMOLITION WORK, CONTRACTOR SHALL IDENTIFY ALL ELECTRICAL CIRCUITS SERVING THE AREA INVOLVED WITH THIS DEMOLITION. THOSE CIRCUITS SHALL THEN BE LOCKED OUT AND TAGGED OUT IF THEY DO NOT SERVICE ANY OF THE REMAINING BUILDING. THOSE CIRCUITS WHICH ARE DEDICATED TO SERVICE BOTH THE AREA TO BE DEMOLISHED AND THE REMAINING BUILDING SHALL BE SPLIT SO AS TO KILL ALL ELECTRICAL POWER TO THE AREA TO BE DEMOLISHED WHILE MAINTAINING POWER TO THE REMAINDER OF THE BUILDING.
- CONTRACTOR SHALL RELOCATE UTILITIES AND EQUIPMENT AS REQUIRED TO ACCOMMODATE NEW HVAC, ELECTRICAL, PLUMBING, AND TECHNOLOGY REQUIREMENTS FOR NEW WORK.
- PROTECT EXISTING SITE ELEMENTS AND EXISTING LANDSCAPING TO REMAIN. PROTECTION SHALL INCLUDE BUT NOT BE LIMITED TO EXISTING TREES AND OTHER EXISTING VEGETATION INDICATED TO REMAIN IN PLACE AGAINST UNNECESSARY CUTTING, BREAKING, OR BURNING OF ROOTS, SKINNING OR BRUISING OF BARK, SMOTHERING OF TREES BY STOCKPILING CONSTRUCTION MATERIAL, OR EXCAVATED MATERIAL, WITHIN DRIP LINES.
- CONTRACTOR SHALL REGRADE AND HYDROMULCH AREAS AFFECTED BY DEMOLITION.
- OWNER HAS RIGHT OF FIRST REFUSAL OF ALL ITEMS REMOVED AS PART OF THE SCOPE OF WORK, WHETHER IDENTIFIED AS SALVAGE OR NOT.
- NOTIFY THE BUILDING OWNER OF ANY MATERIALS, FIXTURES, ETC. TO BE REMOVED THAT ARE DEEMED SALVAGEABLE. TURN OVER ANY REQUESTED ITEMS TO THE BUILDING OWNER IN GOOD CONDITION.
- REMOVE EXISTING CONSTRUCTION TO THE EXTENT INDICATED ON THE DRAWINGS. SHOULD ANY DAMAGE OCCUR TO ANY EXISTING CONSTRUCTION TO REMAIN, THE CONTRACTOR SHALL REPAIR THE DAMAGE TO MATCH EXISTING AND OR ADJACENT CONSTRUCTION AT NO COST TO THE OWNER.
- WHEN UNANTICIPATED MECHANICAL, ELECTRICAL, OR STRUCTURAL ELEMENTS THAT CONFLICT WITH THE INTENDED FUNCTION OR DESIGN ARE ENCOUNTERED, DETERMINE THE NATURE AND EXTENT OF THE CONFLICT AND NOTIFY THE ARCHITECT IMMEDIATELY FOR RESOLUTION.
- REMOVE PATCH AND REPAIR ALL ABANDONED ROOF PENETRATIONS RESULTING FROM WORK.
- EXISTING WALLS (OR PORTIONS OF WALLS) TO BE REMOVED SHALL BE CUT FLUSH WHERE INTERSECTING WITH WALLS TO REMAIN. REMAINING WALLS TO BE PATCHED AND FINISHED SMOOTH.
- NEW OPENING TO BE CUT IN EXISTING WALLS SHALL BE SAW-CUT AT LOCATIONS INDICATED TO THE HEIGHT AND WIDTH INDICATED. NEW WOOD BEAMS SHALL BE INSTALLED TO SUPPORT EXISTING WALL CONSTRUCTION ABOVE AS INDICATED ON THE DRAWINGS, OR IF NOT INDICATED, AS REQUIRED FOR NEW WALL CONSTRUCTION PER STRUCTURAL DRAWINGS. COORDINATE LOCATIONS OF ALL NEW OPENINGS IN EXISTING WALLS AND PARTITIONS WITH ARCHITECTURAL PLANS.
- WHERE EXISTING WALL OPENINGS ARE TO BE NEWLY CLOSED-OFF, REMOVE ANY EXISTING OPENING FRAME AND PATCH AND REPAIR EXISTING WALL TO MATCH EXISTING ADJACENT MATERIALS AND FINISHES, U.N.O.
- WHERE EXISTING INTERIOR WALLS ARE REPLACED OR REMOVED, REMOVE MEPT SYSTEMS BACK TO PANEL, OR MECHANICAL ROOM, OR PARTIALLY POSSIBLE POINT WITHOUT DISTURBING EXISTING CONSTRUCTION. REMOVE EXISTING MECHANICAL EQUIPMENT, RELOCATE POWER PER MEPT DRAWINGS.
- PATCH FLOORS, WALLS/CEILINGS WHICH REMAIN AT LOCATIONS WHERE PIPES, CONDUITS, ETC. ARE REMOVED AS REQUIRED TO MATCH EXISTING CONDITIONS OR TO RECEIVE NEW FINISHES.
- WHERE EXISTING FINISH FLOOR IS REMOVED, PREPARE FLOOR SURFACE TO RECEIVE NEW FLOORING.
- ALL DASHED LINES ARE DEMOLITION LINES UNLESS NOTED OTHERWISE.
- REFERENCE ENGINEERING DRAWINGS FOR ADDITIONAL SCOPE.
- EXISTING WALL OPENINGS ARE EXISTING TO THE PROPERTY. ALL WINDOWS MISSING FROM VACANT BUILDING.



ARCHITECT	Above Ground Design, PLLC
	2001 Grooms Road
	Cleburn, Texas 76110
MEPT	HMS Engineering
	2902 N Flores Street
	San Antonio, Texas 78212
STRUCTURAL	Hoffler Structural Solutions
	945 Pryor Road
	San Antonio, Texas 78258
	COPYRIGHT © 2023

BAR HOUSE, LLC
NEW BAR HOUSE

200 NORTH A AND STREET
SAN ANTONIO TEXAS 78215
ISSUE FOR PERMIT

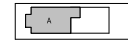

KEY PLAN

PLAN
NORTH
TRUE
NORTH



CLIENT
BAR HOUSE, LLC
PROJECT NUMBER
21003

DATE
AUGUST 3, 2023

REVISIONS

No.	Description	Date
1	ISSUE REVISION	08/03/2023


8/3/2023 9:42:27 PM

DRAWN BY: Author

CHECKED BY: Checker

5 DEMOLITION AREA A SECOND FLOOR PLAN

1/4" = 1'-0"

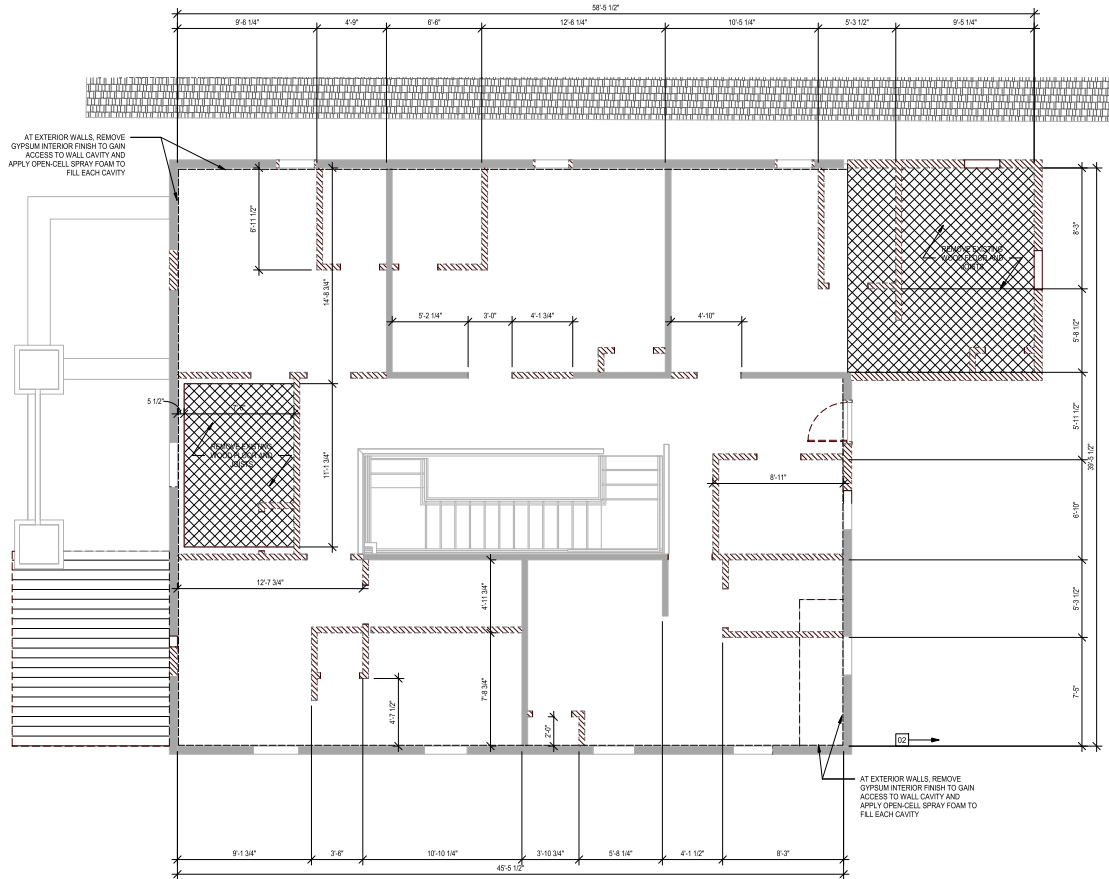

GENERAL DEMOLITION NOTES


- DEMOLITION PLANS INDICATE SOME OF THE SCOPE OF WORK INVOLVED FOR THE DEMOLITION PHASE OF THIS PROJECT. CONTRACTOR SHALL REVIEW ALL SHEETS FOR ADDITIONAL DEMOLITION SCOPE.
- CONTRACTOR SHALL VERIFY EXISTING SITE AND BUILDING CONDITIONS AND DIMENSIONS IN THE FIELD PRIOR TO DEMOLITION ACTIVITIES AND WORK.
- CONTRACTOR SHALL NOTIFY ARCHITECT OF ANY DISCREPANCIES IN WRITING.
- CONTRACTOR SHALL NOTIFY ARCHITECT AND OWNER OF ANY POSSIBLE ASBESTOS OR LEAD-CONTAINING MATERIALS DISCOVERED BEFORE PROCEEDING WITH WORK. PROTECT INTERIOR CONSTRUCTION TO REMAIN DURING DEMOLITION AND CONSTRUCTION.
- CONTRACTOR SHALL OBTAIN ALL NECESSARY PERMITS BEFORE COMMENCING WORK.
- AFTER AWARD OF THE CONTRACT, CHANGE ORDER REQUESTS FOR ADDITIONAL MONEY WILL NOT BE APPROVED IF THE WORK COULD HAVE BEEN ANTICIPATED DURING A SITE VISIT BY THE CONTRACTOR.
- CONTRACTOR SHALL NOT SCALE DRAWINGS.
- CONTRACTOR SHALL PROVIDE ALL NECESSARY TEMPORARY SHORING, TEMPORARY BRACING, AND/OR TEMPORARY SUPPORTS AS REQUIRED TO MAINTAIN STRUCTURAL INTEGRITY OF EXISTING STRUCTURE TO REMAIN AND/OR EXISTING BUILDING ELEMENTS TO REMAIN.
- CONTRACTOR IS TO VERIFY THE EXACT LOCATION OF ALL EXISTING UTILITIES PRIOR TO DEMOLITION ACTIVITIES AND WORK.
- CONTRACTOR SHALL REMOVE TRASH AND DEBRIS REGULARLY AS NECESSARY TO ELIMINATED INTERFERENCE WITH ROADS, STREET, WALKS, AND ALL OTHER ADJACENT FACILITIES.
- CONTRACTOR SHALL REMOVE TRASH AND DEBRIS FROM THE SITE ON A DAILY BASIS.
- CONTRACTOR SHALL REPAIR, REPLACE, OR PATCH EXISTING BUILDINGS, DRIVEWAYS, SIDEWALKS, CANCIPES, AND/OR PARKING AREAS DAMAGED, MODIFIED, AND/OR DISTURBED BY DEMOLITION WORK AT NO COST TO THE OWNER.
- ALL EXISTING EQUIPMENT THAT REMAINS SHALL BE PROTECTED DURING DEMOLITION AND OR CONSTRUCTION TO PREVENT DAMAGE. ANY DAMAGE TO REMAINING EXISTING EQUIPMENT SUSTAINED DURING DEMOLITION AND OR CONSTRUCTION SHALL BE EQUIVALENTLY REPLACED OR EQUIVALENTLY REPAIRED AT NO COST TO THE OWNER.
- CONTRACTOR SHALL PROVIDE TRAFFIC HANDLING MEASURES TO PROTECT THE GENERAL PUBLIC AT ALL TIMES, AS NECESSARY AND AS REQUIRED BY AUTHORITIES HAVING JURISDICTION.
- DO NOT INTERRUPT EXISTING UTILITIES, EXCEPT WHEN AUTHORIZED IN WRITING BY AUTHORITIES HAVING JURISDICTION. PROVIDE TEMPORARY SERVICES DURING INTERRUPTIONS TO EXISTING UTILITIES, AS ACCEPTABLE TO AUTHORITIES HAVING JURISDICTION.
- WHEN UTILITY SERVICES ARE REQUIRED TO BE REMOVED, RELOCATED, OR ABANDONED, PROVIDE BYPASS CONNECTIONS TO MAINTAIN CONTINUITY OF SERVICE BEFORE PROCEEDING WITH DEMOLITION.
- CONTRACTOR SHALL CONTACT ALL UTILITY COMPANIES INCLUDING BUT NOT LIMITED TO THE FOLLOWING: ELECTRIC, GAS, WATER, TELEPHONE, STORM SEWER, AND SANITARY SEWER FOR FIELD LOCATION OF ALL UNDERGROUND AND OVERHEAD UTILITY LINES. PRIOR TO COMMENCEMENT OF ANY DEMOLITION WORK, CONTRACTOR SHALL IDENTIFY ALL ELECTRICAL CIRCUITS SERVING THE AREA INVOLVED WITH THIS DEMOLITION. THOSE CIRCUITS SHALL THEN BE LOOKED OUT AND TAGGED OUT IF THEY DO NOT SERVICE ANY OF THE REMAINING BUILDING. THOSE CIRCUITS WHICH ARE IDENTIFIED TO SERVICE BOTH THE AREA TO BE DEMOLISHED AND THE REMAINING BUILDING SHALL BE SPLIT SO AS TO KILL ALL ELECTRICAL POWER TO THE AREA TO BE DEMOLISHED WHILE MAINTAINING POWER TO THE REMAINDER OF THE BUILDING.
- CONTRACTOR SHALL RELOCATE UTILITIES AND EQUIPMENT AS REQUIRED TO ACCOMMODATE NEW HVAC, ELECTRICAL, PLUMBING, AND TECHNOLOGY REQUIREMENTS FOR NEW WORK.
- PROTECT EXISTING SITE ELEMENTS AND EXISTING LANDSCAPING TO REMAIN. PROTECTION SHALL INCLUDE BUT NOT BE LIMITED TO EXISTING TREES AND OTHER EXISTING VEGETATION INDICATED TO REMAIN IN PLACE AGAINST UNNECESSARY CUTTING, BREAKING, OR SKINNING OF ROOTS, SKINNING OR BRUISING OF BARK, SMOTHERING OF TREES BY STOOPLING CONSTRUCTION MATERIAL OR EXCAVATED MATERIAL WITHIN DRIP LINES.
- CONTRACTOR SHALL REGRADE AND HYDROLOGICAL AREAS AFFECTED BY DEMOLITION.
- OWNER HAS RIGHT OF FIRST REFUSAL OF ALL ITEMS REMOVED AS PART OF THE SCOPE OF WORK, WHETHER IDENTIFIED AS SALVAGE OR NOT.
- NOTIFY THE BUILDING OWNER OF ANY MATERIALS, FIXTURES, ETC. TO BE REMOVED THAT ARE DEEMED SALVAGEABLE. TURN OVER ANY REQUESTED ITEMS TO THE BUILDING OWNER IN GOOD CONDITION.
- REMOVE EXISTING CONSTRUCTION TO THE EXTENT INDICATED ON THE DRAWINGS. SHOULD ANY DAMAGE OCCUR TO ANY EXISTING CONSTRUCTION TO REMAIN, THE CONTRACTOR SHALL REPAIR THE DAMAGE TO MATCH EXISTING ITEMS TO THE BUILDING OWNER IN GOOD CONDITION.
- WHEN UNANTICIPATED MECHANICAL, ELECTRICAL, OR STRUCTURAL ELEMENTS THAT CONFLICT WITH THE INTENDED FUNCTION OR DESIGN ARE ENCOUNTERED, DETERMINE THE NATURE AND EXTENT OF THE CONFLICT AND NOTIFY THE ARCHITECT IMMEDIATELY FOR RESOLUTION.
- REMOVE, PATCH, AND REPAIR ALL ABANDONED ROOF PENETRATIONS RESULTING FROM WORK.
- EXISTING WALLS OR PORTIONS OF WALLS TO BE REMOVED SHALL BE CUT FLUSH WHERE INTERSECTING WITH WALLS TO REMAIN. REMAINING WALLS TO BE PATCHED AND FINISHED SMOOTH.
- NEW OPENING TO BE CUT IN EXISTING WALLS SHALL BE SAW-CUT AT LOCATIONS INDICATED TO THE HEIGHT AND WIDTH INDICATED. NEW WOOD BEAMS SHALL BE INSTALLED TO SUPPORT EXISTING WALL CONSTRUCTION ABOVE AS INDICATED ON THE DRAWINGS, OR IF NOT INDICATED AS REQUIRED FOR NEW WALL CONSTRUCTION PER STRUCTURAL DRAWINGS. COORDINATE LOCATIONS OF ALL NEW OPENINGS IN EXISTING WALLS AND PARTITIONS WITH ARCHITECTURAL PLANS.
- WHERE EXISTING WALL OPENINGS ARE TO BE NEWLY CLOSED-OFF, REMOVE ANY EXISTING OPENING FRAME AND PATCH AND REPAIR EXISTING WALL TO MATCH EXISTING ADJACENT MATERIALS AND FINISHES, U.N.D.
- WHERE EXISTING INTERIOR WALLS ARE REPLACED OR REMOVED, REMOVE MEPT SYSTEMS BACK TO PANEL, OR MECHANICAL ROOM, OR FARTHEST POSSIBLE POINT WITHOUT DISTURBING EXISTING CONSTRUCTION. REMOVE EXISTING MECHANICAL, EQUIPMENT, RELOCATE POWER PER MEPT DRAWINGS.
- PATCH FLOORS, WALLS, CEILINGS WHICH REMAIN AT LOCATIONS WHERE PIPES, CONDUITS, ETC. ARE REMOVED AS REQUIRED TO MATCH EXISTING CONDITIONS OR TO RECEIVE NEW FINISHES.
- WHERE EXISTING FINISH FLOOR IS REMOVED, PREPARE FLOOR SURFACE TO RECEIVE NEW FLOORING.
- ALL DIMENSION LINES ARE DEMOLITION LINES UNLESS NOTED OTHERWISE.
- REFERENCE ENGINEERING DRAWINGS FOR ADDITIONAL SCOPE.
- EXISTING WALL OPENINGS ARE EXISTING TO THE PROPERTY. ALL WINDOWS MISSING FROM VACANT BUILDING.



ARCHITECT	Above Ground Design, PLLC 200 Grooms Road Cibola, Texas 78108
MEPT	HMS Engineering 2902 N Flores Street San Antonio, Texas 78212
STRUCTURAL	Hoffer Structural Solutions 945 Pryor Road San Antonio, Texas 78258
COPYRIGHT 2023	

BAR HOUSE, LLC
NEW BAR HOUSE

RE NORTH AND STREET
SAN ANTONIO TEXAS 78215
ISSUE FOR PERMIT

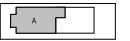

KEY PLAN

PLAN
NORTH
TRUE
NORTH



CLIENT		
BAR HOUSE, LLC		
PROJECT NUMBER		
21003		
DATE	AUGUST 3, 2023	
REVISIONS		
No.	Description	Date


ISSUE FOR PERMIT
**DEMOLITION -
SECOND FLOOR
PLAN AREA A**

D2.02A


CHECKED BY: Checker

DRAWN BY: Author


8/3/2023 9:41:35 PM

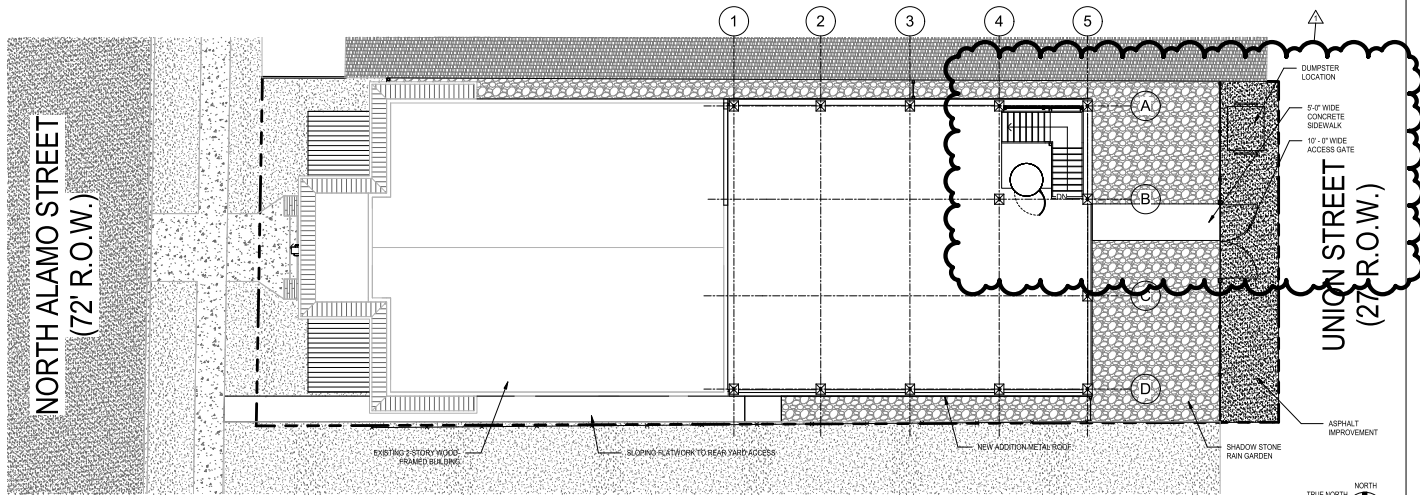

5 SITE PLAN
1/8" = 1'-0"

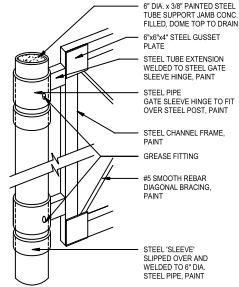

19 GATE HINGE DETAIL
1 1/2" = 1'-0"

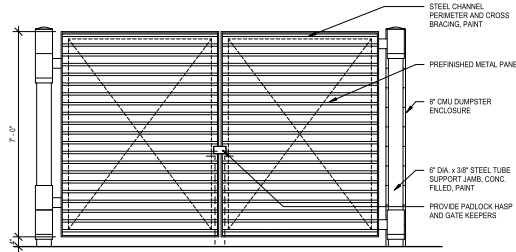

18 GATE ELEVATION
1/2" = 1'-0"

GENERAL ARCH SITE PLAN NOTES


1. CONTRACTOR TO NOTIFY THE ARCHITECT AND OWNER IMMEDIATELY FOR ANY DISCREPANCIES FOUND IN THE FIELD.
 2. PROVIDE AND INSTALL POSITIVE DRAINAGE AWAY FROM ALL BUILDINGS OF 1% MINIMUM, 2% MAXIMUM AT ALL EXTERIOR PAVED PEDESTRIAN AREAS, INCLUDING BUT NOT LIMITED TO SIDEWALKS, PATIOS, STAIRS, PAVING, ETC.
 3. PROVIDE AND INSTALL POSITIVE DRAINAGE AWAY FROM ALL BUILDINGS OF 5% FOR A HORIZ. DISTANCE OF 10 FEET AT ALL EXTERIOR NON-PAVED AREAS UNLESS OTHERWISE NOTED.
 4. ALL SITE SIGNAGE LOCATIONS TO BE VERIFIED WITH ARCHITECT PRIOR TO INSTALLATION OF SITE SIGNAGE.
 5. TENANT STREETSIDE SIGNAGE LOCATED FOR REFERENCE AND NOT PART OF THE SCOPE OF WORK OR PERMITTING IN THIS SET. REQUIRED POWER TO FUTURE SIGNAGE IS WITHIN THE SCOPE OF WORK.
- ALL SIDEWALKS, CURBS, RAMPS AND DRIVE APPROACHES IN THE RIGHT OF WAY SHALL BE IN COMPLIANCE WITH CURRENT TEXAS ACCESSIBILITY STANDARDS AND CITY OF SAN ANTONIO DESIGN STANDARDS PRIOR TO FINAL INSPECTION APPROVAL.



ARCHITECT	Above Ground Design, PLLC 2001 Grooms Road Cibola, Texas 78108
MEET	HMS Engineering 2902 N Flores Street San Antonio, Texas 78212
STRUCTURAL	Hoffer Structural Solutions 940 Prosper Road San Antonio, Texas 78258
COPYRIGHT 2023	

BAR HOUSE, LLC
NEW BAR HOUSE

NEW NORTH ALAMO STREET
SAN ANTONIO TEXAS 78205
ISSUE FOR PERMIT

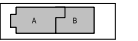

KEY PLAN

PLAN NORTH
TRUE NORTH



CLIENT BAR HOUSE, LLC		
PROJECT NUMBER #1003		
DATE AUGUST 3, 2023		
REVISIONS		
No.	Description	Date
1	ISSUE REVISION	08/03/2023


ISSUE FOR PERMIT
ARCHITECTURAL
SITE PLAN

A0.01


CHECKED BY: Checker

DRAWN BY: Author

8/3/2023 9:41:37 PM

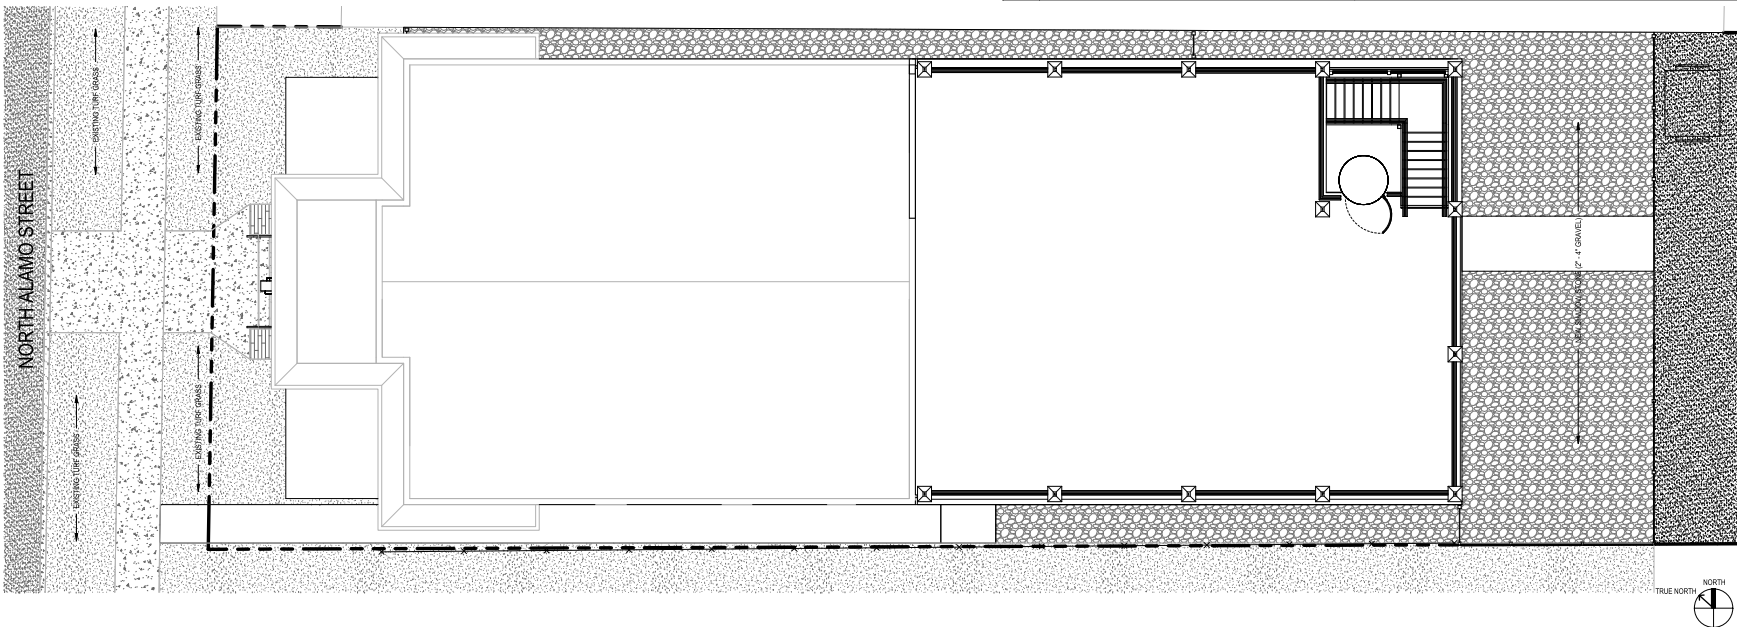

5 SITE LANDSCAPE PLAN
1/8" = 1'-0"

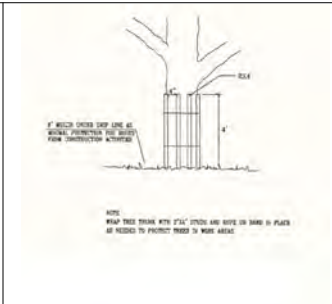

17 TREE PROTECTION DETAIL
NOT TO SCALE



9 TREE ROOT PROTECTION DETAIL
NOT TO SCALE

GENERAL LANDSCAPE PLAN NOTES

1. TREE PROTECTION FENCING TO REMAIN IN PLACE UNTIL CONSTRUCTION IS COMPLETE.
2. USE HAND TOOLS AND CARE DURING CONSTRUCTION IN THE DRP LINE OF EXISTING TREES.
3. CONTRACTOR TO NOTIFY THE ARCHITECT AND OWNER IMMEDIATELY FOR ANY DISCREPANCIES FOUND IN THE FIELD.
4. ALL WEEDS WITHIN THE PROJECT AREA ARE TO BE REMOVED AND TAKEN OFF SITE BY THE CONTRACTOR. ROOT SYSTEMS SHOULD BE ERADICATED.
5. SITE WORK REQUIRING DIGGING WITHIN THE PROMINENT ROOT ZONES OF EXISTING TREES SHALL BE DONE BY HAND OR AIR SPADE. NO ROOTS OVER 1" IN DIA. SHALL BE CUT.
6. ALL EXISTING VEGETATION TO REMAIN ARE ESTABLISHED AND REGIONAL SPECIES NOT REQUIRING IRRIGATION SYSTEMS. ANY NEW VEGETATION TO BE OF REGIONAL SPECIES AND APPLY A TEMPORARY DRIP IRRIGATION THROUGHOUT ROOT ESTABLISHMENT.
7. ALL LANDSCAPED AREAS TO BE MAINTAINED BY AN UNDERGROUND SYSTEM.



ARCHITECT	Above Ground Design, PLLC
MEPT	2001 Grooms Road Cibola, Texas 78108
STRUCTURAL	2902 N Flores Street San Antonio, Texas 78212
	340 Prosper Road San Antonio, Texas 78258
	Copyright 2023

BAR HOUSE, LLC
NEW BAR HOUSE

101 NORTH ALAMO STREET
SAN ANTONIO, TEXAS 78205
ISSUE FOR PERMIT



KEY PLAN

PLAN
NORTH



CLIENT		
BAR HOUSE, LLC		
PROJECT NUMBER		
21003		
DATE	AUGUST 3, 2023	
REVISIONS		
No.	Description	Date


ISSUE FOR PERMIT
LANDSCAPE PLAN

A0.02

FINISH LEGEND						
Key Name	FINISH DESCRIPTION	MANUFACTURER	SERIES	COLOR	SIZE	REMARK
FRP-1	FIBERGLASS REINFORCED PANEL	SELECTED BY OWNER		WHITE		
P-1	PAINT - FIELD, TYPE 1	SELECTED BY OWNER		TBD		LIGHT COLOR
P-2	PAINT - CEILING	SELECTED BY OWNER		WHITE		ALL HARD GYPSUM BOARD CEILINGS
P-3	PAINT - ACCENT, TYPE 1	SELECTED BY OWNER		TBD		AS REQUIRED BY OWNER
P-4	PAINT - ACCENT, TYPE 2	SELECTED BY OWNER		TBD		AS REQUIRED BY OWNER
PT-1	PORCELAIN TILE, TYPE 1	SELECTED BY OWNER		VARES		RESTROOM FLOORS, WET WALLS AND BAR PONY WALLS
SC-1	SEALED CONCRETE	SELECTED BY OWNER		CLEAR		AT ALL UNFINISHED CONCRETE FLOORS
SB-1	SOLID SURFACE, TYPE 1	SELECTED BY OWNER		TBD		AT ALL COUNTER TOPS
TB-1	TILE BASE	SELECTED BY OWNER		VARES		AT ALL WALLS ADJACENT TO FLOOR TILE
WB-1	WOOD WALL BASE	NA		STAINED		TO MATCH EXISTING PROFILE
WB-2	6" RUBBER BASE	ROPP	PINNACLE	TBD		ROLLS
WS-1	WOOD STAIN	SELECTED BY OWNER		WALNUT COLOR		AT ALL NEW EXPOSED WOOD ELEMENTS
WS-2	WOOD STAIN	SELECTED BY OWNER		CLEAN COAT		AT ALL EXISTING EXPOSED WOOD ELEMENTS

GENERAL FINISH LEGEND NOTES

1. ALL FINISH MATERIALS SHALL MEET THE FLAME SPREAD RATINGS PER THE BUILDING CODE.
2. REFER TO INTERIOR ELEVATIONS FOR SPECIFIC MATERIAL LOCATIONS.
3. PAINT ALL EXTERIOR EXPOSED STRUCT. MEMBERS, STRUCT. DECK, DUCTWORK, DIFFUSERS, PIPING, CONDUIT, EQUIP. HOUSINGS, LIGHT FIXTURE HOUSINGS, CABLE SUPPORTS, CABLE TRAYS, EQUIP. SUPPORTS, HANGERS, ETC. AT THE DISCRETION OF THE OWNER.
4. PAINT ALL NON-FABRIC FINISHED EXPOSED METAL.
5. PROVIDE ALL FLOOR TRANSITIONS AS REQUIRED FOR EGRESS AND MATERIAL TRANSITIONS.
6. FLOORING TRANSITIONS AT DOORS SHOULD BE LOCATED UNDER THE DOOR IN THE CLOSED POSITION UNLESS NOTED OTHERWISE.
7. PROTECT ALL FINISHED FLOORING SURFACES FROM DAMAGE DURING ALL CONSTRUCTION PHASES.
8. PROVIDE AND INSTALL BALUNOSE TRIM AT ALL TRANSITIONS AT CMU WALL OPENINGS TO OTHER MATERIAL U.N.O.
9. REFER TO REFLECTED CEILING PLANS FOR CEILING HEIGHTS.
10. ALL ELECTRICAL DEVICE COVERS ARE TO BE STAINLESS STEEL U.N.O.
11. PAINT ALL DOOR FRAMES ADJACENT WALL COLOR U.N.O.

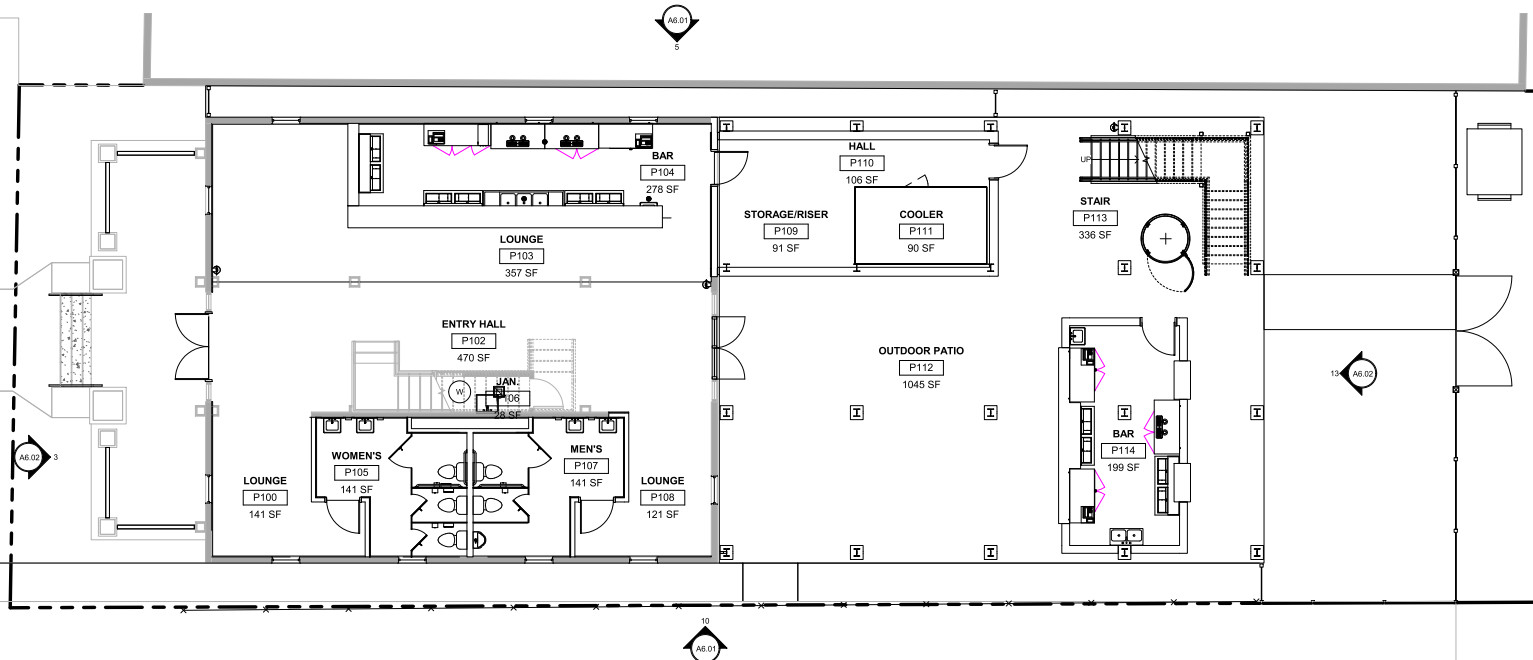

FINISH SCHEDULE - FIRST FLOOR										
ROOM NUMBER	ROOM NAME	FLOOR	BASE	WALL FINISH				CEILING FINISH	CEILING HEIGHT	REMARKS
				NORTH WALL	EAST WALL	SOUTH WALL	WEST WALL			
P100	LOUNGE	WS-2	WB-1	P-3	P-4	P-1	P-1	WS-2		
P102	ENTRY HALL	WS-2	WB-1	NA	P-1	P-4WS-1	P-1	WS-2		
P103	LOUNGE	WS-2	WB-1	PT-1	P-3	NA	P-1	WS-2		STRIP AND STAIN WOOD STAIR AND RAILING
P104	BAR	WS-2	WB-1	P-3	P-3	FRP-1	FRP-1	WS-2		TILE AT BAR PONY WALL
P105	WOMEN'S	PT-1	TB-1	P-1	PT-1SR-1	P-1	P-1	P-2		
P106	JAN	WS-2	WB-1	P-1	P-1	FRP-1	P-1	P-2		
P107	MEN'S	PT-1	TB-1	P-1	P-1	PT-1SR-1	P-1	P-2		
P108	LOUNGE	WS-2	WB-1	NA	P-1	P-1	P-4	WS-2		
P109	STORAGE/RISER	S-1	WB-2	NA	NA	P-1	P-1	P-2		
P110	HALL	CS-1	WB-2	P-1	P-1	NA	P-1	P-2		
P111	COOLER	CS-1	NA	NA	NA	NA	NA	NA		
P112	OUTDOOR PATIO	SC-1	P-4	P-3	P-4	P-4	P-1	NA		
P113	STAIR	SC-1	NA	P-4	P-4	P-4	P-4	NA		REF. RAILING DETAILS
P114	BAR	SC-1	WB-2	FRP-1	FRP-1	FRP-1	FRP-1	NA		



CHECKED BY: Checker

DRAWN BY: Author

8/3/2023 9:41:39 PM

5 COMPOSITE FIRST FLOOR PLAN

3/16" = 1'-0"

ARCHITECT Above Ground Design, PLLC
2001 Grooms Road
Cibola, Texas 78108

MEPT HNS Engineering
2902 N Flores Street
San Antonio, Texas 78212

STRUCTURAL Hoffer Structural Solutions
945 Prosper Road
San Antonio, Texas 78258

COPYRIGHT 2023

BAR HOUSE, LLC
NEW BAR HOUSE

360 NORTH A AND STREET
SAN ANTONIO TEXAS 78215
ISSUE FOR PERMIT

CLIENT
BAR HOUSE, LLC
PROJECT NUMBER
#1003

DATE
AUGUST 3, 2023

REVISIONS

No.	Description	Date

ISSUE FOR PERMIT

COMPOSITE FIRST FLOOR PLAN


A2.01

WINDOW SCHEDULE - ALL										
MARK	TAG COUNT	Level	Sill Height	FRAME SIZE W x H		FRAME MATERIAL	DETAILS			REMARKS
				WIDTH	HEIGHT		SILL	JAMB	HEAD	
E 1		FIRST FLOOR	1'-6"	2'-8"	7'-0"	AL-CLAD WOOD	13/A9.01	15/A9.01	14/A9.01	ALL SIZES ARE APPROXIMATE TO EXISTING WALL R.O.
E 2		FIRST FLOOR	1'-6"	2'-8"	7'-0"	AL-CLAD WOOD	13/A9.01	15/A9.01	14/A9.01	ALL SIZES ARE APPROXIMATE TO EXISTING WALL R.O.
E 3		FIRST FLOOR	1'-8 1/4"	2'-8"	7'-0"	AL-CLAD WOOD	13/A9.01	15/A9.01	14/A9.01	ALL SIZES ARE APPROXIMATE TO EXISTING WALL R.O.
E 4		FIRST FLOOR	1'-8 1/4"	2'-8"	7'-0"	AL-CLAD WOOD	13/A9.01	15/A9.01	14/A9.01	ALL SIZES ARE APPROXIMATE TO EXISTING WALL R.O.
E 5		FIRST FLOOR	1'-6"	2'-8"	7'-0"	AL-CLAD WOOD	13/A9.01	15/A9.01	14/A9.01	ALL SIZES ARE APPROXIMATE TO EXISTING WALL R.O.
E 6		FIRST FLOOR	1'-6"	2'-8"	7'-0"	AL-CLAD WOOD	13/A9.01	15/A9.01	14/A9.01	ALL SIZES ARE APPROXIMATE TO EXISTING WALL R.O.
E 7		FIRST FLOOR	1'-8 1/4"	2'-8"	7'-0"	AL-CLAD WOOD	13/A9.01	15/A9.01	14/A9.01	ALL SIZES ARE APPROXIMATE TO EXISTING WALL R.O.
ET 8		FIRST FLOOR	1'-8 1/4"	2'-8"	7'-0"	AL-CLAD WOOD	13/A9.01	15/A9.01	14/A9.01	"T" IS TRANSLUCENT GLAZING
ET 9		FIRST FLOOR	1'-6"	2'-8"	7'-0"	AL-CLAD WOOD	13/A9.01	15/A9.01	14/A9.01	"T" IS TRANSLUCENT GLAZING
ET 10		FIRST FLOOR	1'-6"	2'-8"	7'-0"	AL-CLAD WOOD	13/A9.01	15/A9.01	14/A9.01	"T" IS TRANSLUCENT GLAZING
S 11		SECOND FLOOR	1'-6"	2'-8"	4'-6"	AL-CLAD WOOD	13/A9.01	15/A9.01	14/A9.01	ALL SIZES ARE APPROXIMATE TO EXISTING WALL R.O.
S 12		SECOND FLOOR	1'-6"	2'-8"	4'-6"	AL-CLAD WOOD	13/A9.01	15/A9.01	14/A9.01	ALL SIZES ARE APPROXIMATE TO EXISTING WALL R.O.
S 13		SECOND FLOOR	2'-10"	2'-8"	4'-6"	AL-CLAD WOOD	13/A9.01	15/A9.01	14/A9.01	ALL SIZES ARE APPROXIMATE TO EXISTING WALL R.O.
S 14		SECOND FLOOR	2'-10"	2'-8"	4'-6"	AL-CLAD WOOD	13/A9.01	15/A9.01	14/A9.01	ALL SIZES ARE APPROXIMATE TO EXISTING WALL R.O.
S 15		SECOND FLOOR	2'-10"	2'-8"	4'-6"	AL-CLAD WOOD	13/A9.01	15/A9.01	14/A9.01	ALL SIZES ARE APPROXIMATE TO EXISTING WALL R.O.
S 16		SECOND FLOOR	2'-10"	2'-8"	4'-6"	AL-CLAD WOOD	13/A9.01	15/A9.01	14/A9.01	ALL SIZES ARE APPROXIMATE TO EXISTING WALL R.O.
S 17		SECOND FLOOR	2'-3 3/4"	2'-8"	4'-6"	AL-CLAD WOOD	13/A9.01	15/A9.01	14/A9.01	ALL SIZES ARE APPROXIMATE TO EXISTING WALL R.O.
S 18		SECOND FLOOR	2'-10"	2'-8"	4'-6"	AL-CLAD WOOD	13/A9.01	15/A9.01	14/A9.01	ALL SIZES ARE APPROXIMATE TO EXISTING WALL R.O.
S 19		SECOND FLOOR	2'-10"	2'-8"	4'-6"	AL-CLAD WOOD	13/A9.01	15/A9.01	14/A9.01	ALL SIZES ARE APPROXIMATE TO EXISTING WALL R.O.
S 20		SECOND FLOOR	2'-10"	2'-8"	4'-6"	AL-CLAD WOOD	13/A9.01	15/A9.01	14/A9.01	ALL SIZES ARE APPROXIMATE TO EXISTING WALL R.O.
W1 21		SECOND FLOOR	1'-0"	3'-0"	6'-0"	AL-CLAD WOOD	13/A9.01	15/A9.01	14/A9.01	ALL SIZES ARE APPROXIMATE TO EXISTING WALL R.O.

Grand total: 21

GENERAL NOTES

- DO NOT SCALE DRAWINGS. WRITTEN DIMENSIONS TAKE PRECEDENCE. CONTACT ARCH IF CLARIFICATION IS NECESSARY IN ORDER TO DETERMINE THE INTENT OF THE CONTRACT DOCUMENTS.
- DRAWINGS NOTED AS "N.T.S." OR "N.T.S." ARE NOT TO SCALE.
- ALL DIMENSIONS ARE TO STRUCTURAL COLUMN LINES OR THE FACE OF FINISHED SURFACES UNLESS NOTED OTHERWISE.
- FIELD VERIFY ALL DIMENSIONS AND EXISTING CONDITION BEFORE COMMENCING WORK. NOTIFY ARCH OF ANY DISCREPANCIES PRIOR TO PROCEEDING WITH AFFECTED WORK.
- NOTES OR DIMENSIONS NOTED AS "TYPICAL" OR "TYP." OR "TYP." SHALL APPLY TO CONDITIONS THAT ARE THE SAME OR SIMILAR.
- DIMENSIONS NOTED AS "FIELD VERIFY" OR "F.V." OR "V.F." SHALL BE MEASURED AND CONFIRMED AT THE PROJECT SITE BY THE CONTRACTOR AND REVIEWED WITH THE ARCH. BEFORE INCORPORATING INTO THE WORK.
- DIMENSIONS NOTED AS "CLEAR" OR "CLEAR INSIDE" REQUIRE SPECIFIC COORDINATION AMONG DISCIPLINES AND/OR MANUFACTURERS.
- ALL DOOR THRESHOLDS AT ALL EXTERIOR DOORS SHALL BE SET IN FULL BED OF SEALANT.
- COORD. HOUSEKEEPING PAD LOCATIONS AND DIMENSIONS WITH EQUIPMENT TO BE INSTALLED.
- ALL FLOOR FINISH MATERIAL CHANGES SHALL HAVE REDUCER STRIPS.
- ALL REQUIRED ACCESSIBLE CLEARANCES FOR ALL ITEMS INCLUDING BUT NOT LIMITED TO ALL COUNTER TOPS, ALL PLUMBING FIXTURES, ALL LAVATORIES, ALL URINALS, ALL TOILETS SHALL BE STRICTLY ENFORCED.
- REFER TO OTHER DISCIPLINE DOCUMENTS FOR ADDITIONAL SCOPE OF WORK.
- ALL NEW DOOR HARDWARE TO MEET TEAS ACCESSIBLE STANDARDS TO INCLUDE BUT NOT LIMITED TO REQUIREMENTS FOR HEIGHTS, CLEARANCES, PUSH/PULL FORCE, LEVERS, CLOSERS, AND LOCKS.
- ALL FIRST EIGHT CMU COURSES SHALL HAVE EPOXY PAINT APPLIED TO ALL EXPOSED SURFACES.
- ALL WALL MOUNTED ELECTRICAL DEVICES SHALL BE MOUNTED ABOVE THE SIXTH CMU COURSE TO REMAIN ABOVE BASE FLOOD ELEVATION.
- NEW SINGLE HUNG WINDOWS TO BE INSTALLED IN PLACE OF EXISTING MISSING WINDOW OPENINGS EXISTING WOOD-FRAMED WALLS. PROVIDE ALL NECESSARY TRIM, SEALANT AND FLASHINGS.
- ALL EXPOSED NEW STEEL STRUCTURE AND DECK TO BE PAINTED TO MATCH EXISTING BUILDING COLOR.



ARCHITECT Above Ground Design, PLLC
2001 Grooms Road
Cibola, Texas 79108

MEPT HNS Engineering
2902 N Flores Street
San Antonio, Texas 78212


STRUCTURAL Hoffer Structural Solutions
945 Prosper Road
San Antonio, Texas 78268

COPYRIGHT 2023

BAR HOUSE, LLC
NEW BAR HOUSE

201 NORTH A AND STREET
SAN ANTONIO TEXAS 78205

ISSUE FOR PERMIT



AUGUST 3, 2023

CLIENT
BAR HOUSE, LLC

PROJECT NUMBER
#1003

DATE
AUGUST 3, 2023

REVISIONS

No.	Description	Date
1	ISSUE REVISION	08.03.2023

ISSUE FOR PERMIT

FIRST FLOOR PLAN - AREA A


A2.01A

CHECKED BY: Checker


DRAWN BY: Author

8/3/2023 9:41:41 PM

5 FIRST FLOOR PLAN - AREA A
1/4" = 1'-0"

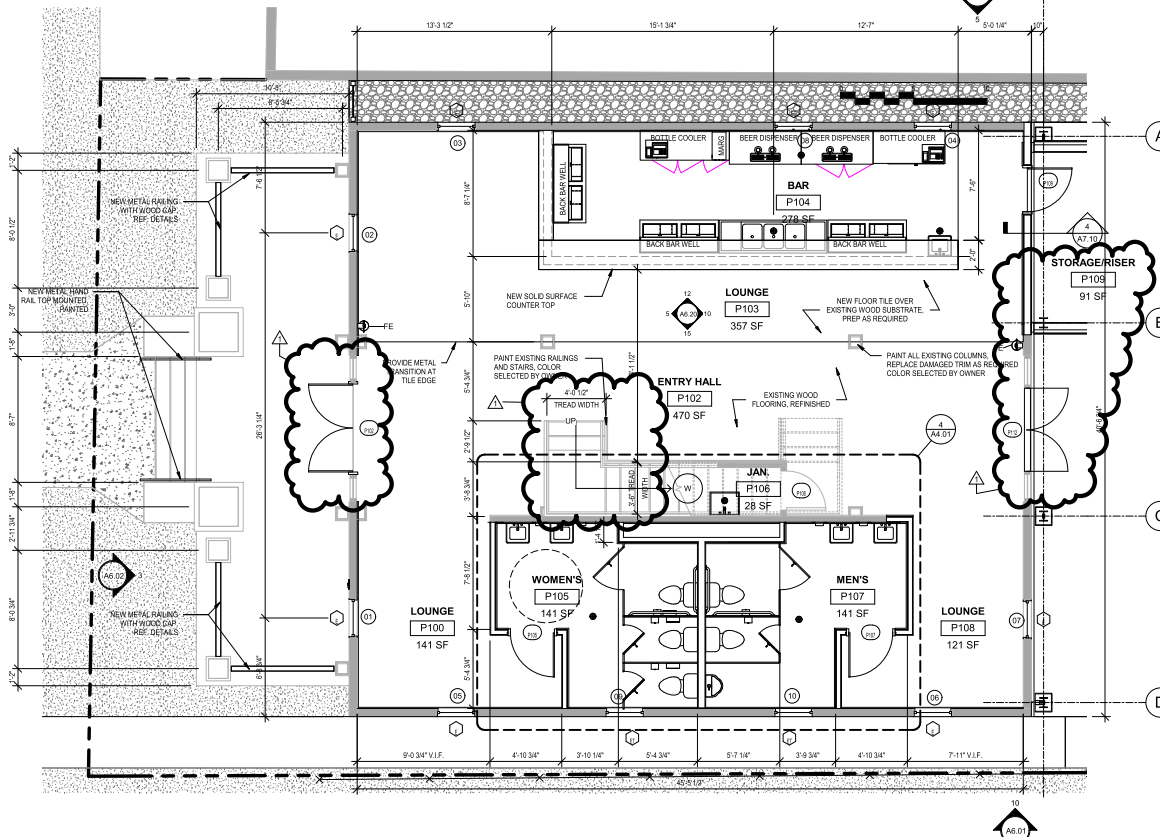

5 FIRST FLOOR PLAN - AREA B
1/4" = 1'-0"

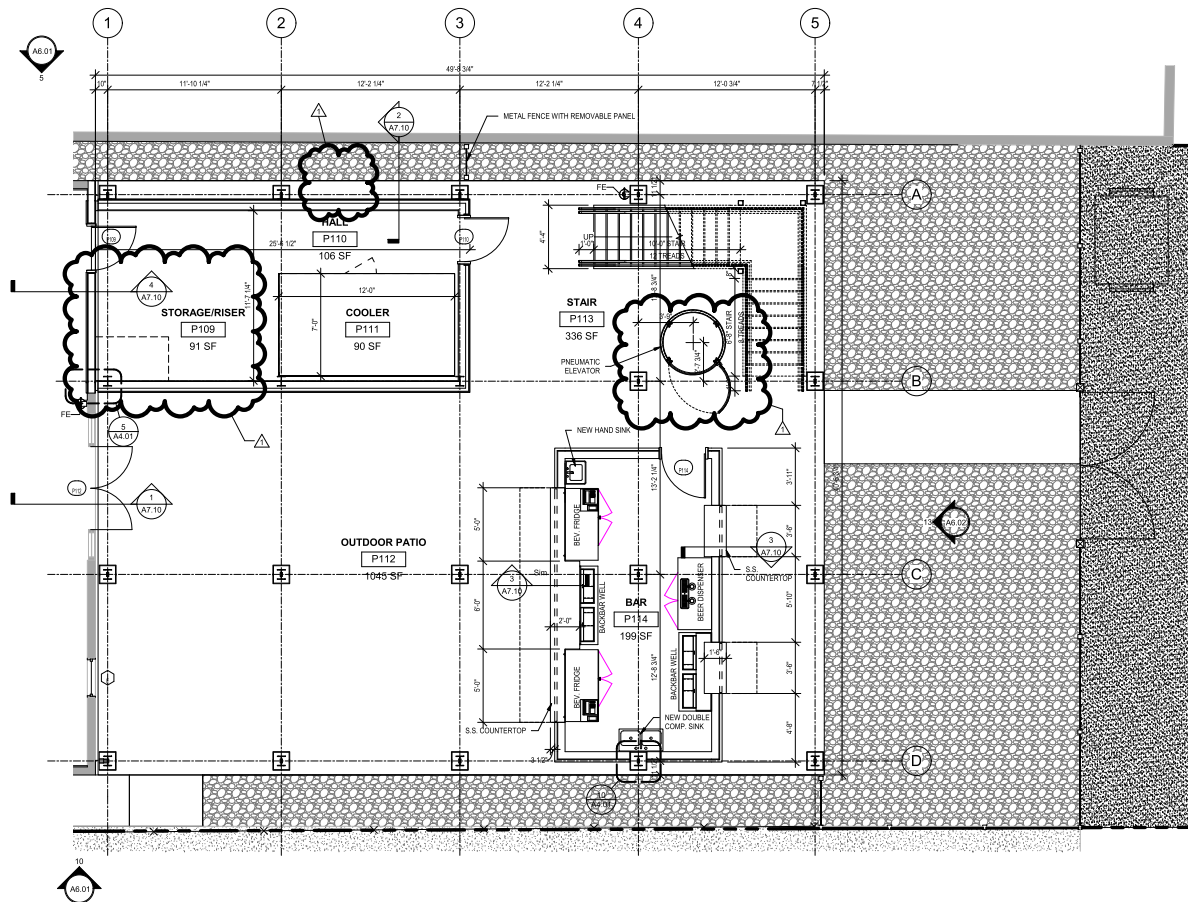

1. DO NOT SCALE DRAWINGS. WRITTEN DIMENSIONS TAKE PRECEDENCE. CONTACT ARCH IF CORRECTIONS IS NECESSARY IN ORDER TO DETERMINE THE INTENT OF THE CONTRACT DOCUMENTS.
ARCHITECT	Above Ground Design, PLLC 200 Grooms Road Cibola, Texas 78108
MEPT	HM3 Engineering 2902 N Flores Street San Antonio, Texas 78212
STRUCTURAL	Hoffer Structural Solutions 845 Proton Road San Antonio, Texas 78258
COPYRIGHT 2023	

BAR HOUSE, LLC
NEW BAR HOUSE



KEY PLAN



CLIENT BAR HOUSE, LLC		
PROJECT NUMBER 21003		
DATE	AUGUST 3, 2023	
REVISIONS		
No.	Description	Date
1	COSA REVISION	08.03.2023

ISSUE FOR PERMIT
FIRST FLOOR PLAN
- AREA B

A2.01B

CHECKED BY: Checker


DRAWN BY: Author

8/3/2023 9:41:45 PM

5

COMPOSITE SECOND FLOOR PLAN

3/8" = 1'-0"

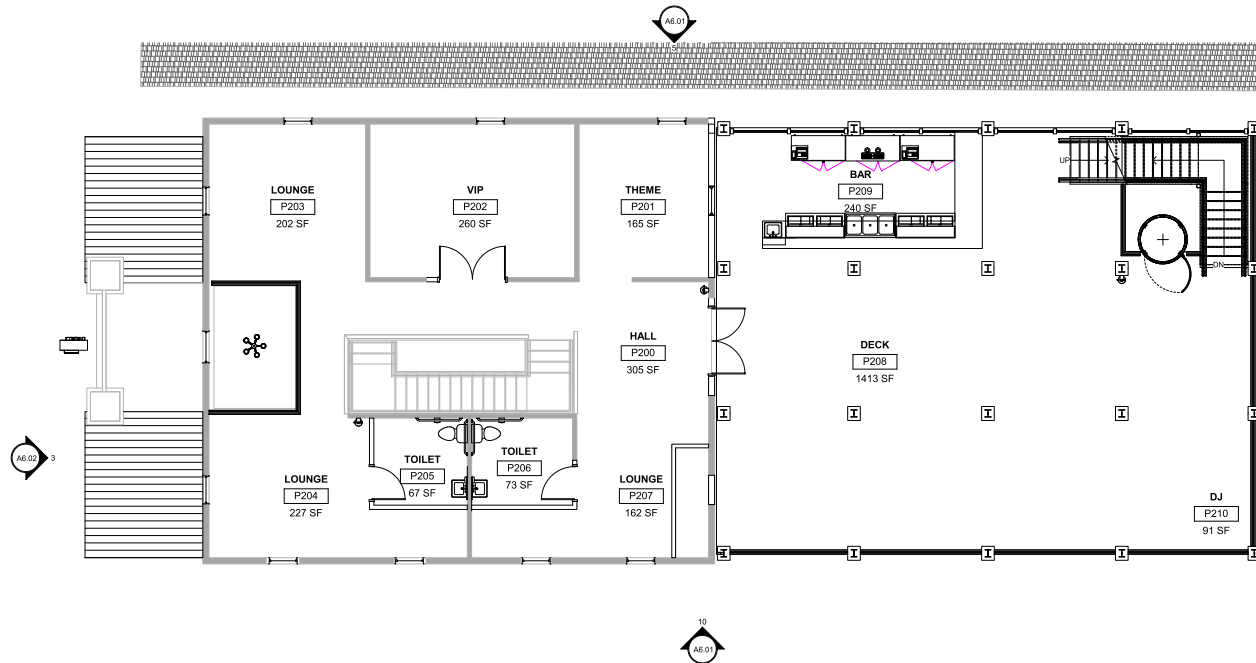


FINISH SCHEDULE - SECOND FLOOR										
ROOM NUMBER	ROOM NAME	FLOOR	BASE	WALL FINISH				CEILING FINISH	CEILING HEIGHT	REMARKS
				NORTH WALL	EAST WALL	SOUTH WALL	WEST WALL			
P200	HALL	WS-2	WB-1	P-1	P-1	P-4/WS-1	P-1	P-2		
P201	THEME	WS-2	WB-1	P-3	P-1	P-1	P-1	P-2		
P202	VIP	WS-2	WB-1	P-4	P-1	P-1	P-1	P-2		
P203	LOUNGE	WS-2	WB-1	P-3	P-1	P-1	P-1	P-2		
P204	LOUNGE	WS-2	WB-1	P-1	P-3	P-1	P-1	P-2		
P205	TOILET	PT-1	TB-1	P-1	PT-1B-1	P-1	P-1	P-2		
P206	TOILET	PT-1	TB-1	P-1	P-1	P-1	PT-1B-1	P-2		
P207	LOUNGE	WS-2	WB-1	P-1	P-1	P-1	P-1	P-2		
P208	DECK	SC-1	N/A	PT-1	N/A	N/A	P-1	N/A		TILE AT BAR PONY WALL
P209	BAR	SC-1	N/A	N/A	P-1	P-1	P-1	N/A		
P210	DJ	SC-1	N/A	N/A	N/A	N/A	N/A	N/A		

FINISH LEGEND

Key Name	FINISH DESCRIPTION	MANUFACTURER	SERIES	COLOR	SIZE	REMARK
RP-1	FIBERGLASS REINFORCED PANEL	SELECTED BY OWNER		WHITE		
P-1	PAINT - FIELD, TYPE 1	SELECTED BY OWNER		WHITE		LIGHT COLOR
P-2	PAINT - CEILING	SELECTED BY OWNER		WHITE		ALL HARD GYPSUM BOARD CEILINGS
P-3	PAINT - ACCENT, TYPE 1	SELECTED BY OWNER		WHITE		AS REQUIRED BY OWNER
P-4	PAINT - ACCENT, TYPE 2	SELECTED BY OWNER		WHITE		AS REQUIRED BY OWNER
PT-1	PORCELAIN TILE, TYPE 1	SELECTED BY OWNER		VARIABLES		RESTROOM FLOORS, WET WALLS AND BAR PONY WALLS
SC-1	SEALED CONCRETE	SELECTED BY OWNER		CLEAR		AT ALL UNFINISHED CONCRETE FLOORS
SS-1	SOLID SURFACE, TYPE 1	SELECTED BY OWNER		WHITE		AT ALL COUNTER TOPS
TB-1	TILE BASE	SELECTED BY OWNER		VARIABLES		AT ALL WALLS ADJACENT TO FLOOR TILE
WB-1	WOOD WALL BASE	N/A		STAINED		TO MATCH EXISTING PROFILE
WB-2	W RUBBER BASE	ROPPE	Pinnacle	TEAK		ROLLS
WS-1	WOOD STAIN	SELECTED BY OWNER		WALNUT COLOR		AT ALL NEW EXPOSED WOOD ELEMENTS
WS-2	WOOD STAIN	SELECTED BY OWNER		CLEAR COAT		AT ALL EXISTING EXPOSED WOOD ELEMENTS

GENERAL FINISH LEGEND NOTES

1. ALL FINISH MATERIALS SHALL MEET THE FLAME SPREAD RATINGS PER THE BUILDING CODE.
2. REFER TO INTERIOR ELEVATIONS FOR SPECIFIC MATERIAL LOCATIONS.
3. PAINT ALL EXTERIOR EXPOSED STRUCT. MEMBERS, STRUCT. DECK, DUCTWORK, DIFFUSERS, SPRING, CONDUIT, EQUIP. HOUSINGS, LIGHT FIXTURE HOUSINGS, CABLE SUPPORTS, CABLE TRAYS, EQUIP. SUPPORTS, HANGERS, ETC. AT THE DIRECTION OF THE OWNER.
4. PAINT ALL NON-FACTORY FINISHED EXPOSED METAL.
5. PROVIDE ALL FLOOR TRANSITIONS AS REQUIRED FOR EGRESS AND MATERIAL TRANSITIONS.
6. FLOORING TRANSITIONS AT DOORS SHOULD BE LOCATED UNDER THE DOOR IN THE CLOSED POSITION, UNLESS NOTED OTHERWISE.
7. PROTECT ALL FINISHED FLOORING SURFACES FROM DAMAGE DURING ALL CONSTRUCTION PHASES.
8. PROVIDE AND INSTALL BULLNOSE TRIM AT ALL TRANSITIONS AT CMU WALL OPENINGS TO OTHER MATERIAL UNO.
9. REFER TO REFLECTED CEILING PLANS FOR CEILING HEIGHTS.
10. ALL ELECTRICAL DEVICE COVERS ARE TO BE STAINLESS STEEL UNO.
11. PAINT ALL DOOR FRAMES ADJACENT WALL COLOR UNO.



BAR HOUSE, LLC
NEW BAR HOUSE

365 PINE STREET
SAN ANTONIO, TEXAS 78205

ISSUE FOR PERMIT

ARCHITECT Above Ground Design, PLLC
2001 Grooms Road
Cibola, Texas 78108

MEET HNS Engineering
2902 N Flores Street
San Antonio, Texas 78212

STRUCTURAL Hoffer Structural Solutions
945 Pinedale Road
San Antonio, Texas 78208

COPYRIGHT 2023

KEY PLAN

PLAN NORTH
TRUE NORTH

REGISTERED ARCHITECT
STATE OF TEXAS
AUGUST 3, 2023

CLIENT BAR HOUSE, LLC
PROJECT NUMBER #1003
DATE AUGUST 3, 2023

REVISIONS

No.	Description	Date

ISSUE FOR PERMIT

COMPOSITE SECOND FLOOR PLAN

A2.02


CHECKED BY: Checker

DRAWN BY: Author

8/3/2023 9:41:47 PM

5 SECOND FLOOR PLAN - AREA A


1/4" = 1'-0"

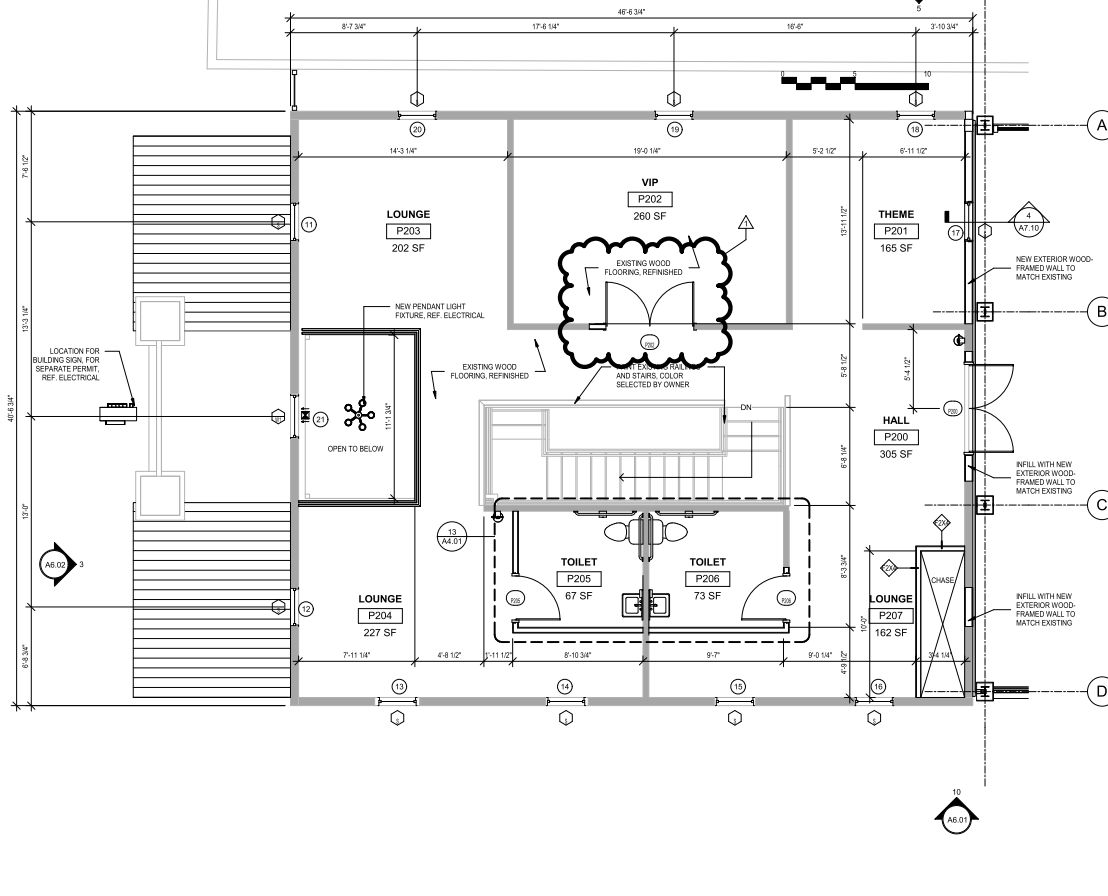

WINDOW SCHEDULE - ALL										
MARK	COUNT	Level	Sill Height	FRAME SIZE W x H		FRAME MATERIAL	DETAILS			REMARKS
				WIDTH	HEIGHT		SILL	JAMB	HEAD	
E 1	1	FIRST FLOOR	1'-6"	2'-8"	7'-0"	AL-CLAD WOOD	13/A9.01	15/A9.01	14/A9.01	ALL SIZES ARE APPROXIMATE TO EXISTING WALL R.O.
E 2	1	FIRST FLOOR	1'-6"	2'-8"	7'-0"	AL-CLAD WOOD	13/A9.01	15/A9.01	14/A9.01	ALL SIZES ARE APPROXIMATE TO EXISTING WALL R.O.
E 3	1	FIRST FLOOR	1'-8 1/4"	2'-8"	7'-0"	AL-CLAD WOOD	13/A9.01	15/A9.01	14/A9.01	ALL SIZES ARE APPROXIMATE TO EXISTING WALL R.O.
E 4	1	FIRST FLOOR	1'-8 1/4"	2'-8"	7'-0"	AL-CLAD WOOD	13/A9.01	15/A9.01	14/A9.01	ALL SIZES ARE APPROXIMATE TO EXISTING WALL R.O.
E 5	1	FIRST FLOOR	1'-6"	2'-8"	7'-0"	AL-CLAD WOOD	13/A9.01	15/A9.01	14/A9.01	ALL SIZES ARE APPROXIMATE TO EXISTING WALL R.O.
E 6	1	FIRST FLOOR	1'-6"	2'-8"	7'-0"	AL-CLAD WOOD	13/A9.01	15/A9.01	14/A9.01	ALL SIZES ARE APPROXIMATE TO EXISTING WALL R.O.
E 7	1	FIRST FLOOR	1'-8 1/4"	2'-8"	7'-0"	AL-CLAD WOOD	13/A9.01	15/A9.01	14/A9.01	ALL SIZES ARE APPROXIMATE TO EXISTING WALL R.O.
ET 8	1	FIRST FLOOR	1'-6"	2'-8"	7'-0"	AL-CLAD WOOD	13/A9.01	15/A9.01	14/A9.01	"T" IS TRANSLUCENT GLAZING
ET 9	1	FIRST FLOOR	1'-6"	2'-8"	7'-0"	AL-CLAD WOOD	13/A9.01	15/A9.01	14/A9.01	"T" IS TRANSLUCENT GLAZING
ET 10	1	FIRST FLOOR	1'-6"	2'-8"	7'-0"	AL-CLAD WOOD	13/A9.01	15/A9.01	14/A9.01	"T" IS TRANSLUCENT GLAZING
S 11	1	SECOND FLOOR	1'-6"	2'-8"	4'-6"	AL-CLAD WOOD	13/A9.01	15/A9.01	14/A9.01	ALL SIZES ARE APPROXIMATE TO EXISTING WALL R.O.
S 12	1	SECOND FLOOR	1'-6"	2'-8"	4'-6"	AL-CLAD WOOD	13/A9.01	15/A9.01	14/A9.01	ALL SIZES ARE APPROXIMATE TO EXISTING WALL R.O.
S 13	1	SECOND FLOOR	2'-10"	2'-8"	4'-6"	AL-CLAD WOOD	13/A9.01	15/A9.01	14/A9.01	ALL SIZES ARE APPROXIMATE TO EXISTING WALL R.O.
S 14	1	SECOND FLOOR	2'-10"	2'-8"	4'-6"	AL-CLAD WOOD	13/A9.01	15/A9.01	14/A9.01	ALL SIZES ARE APPROXIMATE TO EXISTING WALL R.O.
S 15	1	SECOND FLOOR	2'-10"	2'-8"	4'-6"	AL-CLAD WOOD	13/A9.01	15/A9.01	14/A9.01	ALL SIZES ARE APPROXIMATE TO EXISTING WALL R.O.
S 16	1	SECOND FLOOR	2'-10"	2'-8"	4'-6"	AL-CLAD WOOD	13/A9.01	15/A9.01	14/A9.01	ALL SIZES ARE APPROXIMATE TO EXISTING WALL R.O.
S 17	1	SECOND FLOOR	2'-3 3/4"	2'-8"	4'-6"	AL-CLAD WOOD	13/A9.01	15/A9.01	14/A9.01	ALL SIZES ARE APPROXIMATE TO EXISTING WALL R.O.
S 18	1	SECOND FLOOR	2'-10"	2'-8"	4'-6"	AL-CLAD WOOD	13/A9.01	15/A9.01	14/A9.01	ALL SIZES ARE APPROXIMATE TO EXISTING WALL R.O.
S 19	1	SECOND FLOOR	2'-10"	2'-8"	4'-6"	AL-CLAD WOOD	13/A9.01	15/A9.01	14/A9.01	ALL SIZES ARE APPROXIMATE TO EXISTING WALL R.O.
S 20	1	SECOND FLOOR	2'-10"	2'-8"	4'-6"	AL-CLAD WOOD	13/A9.01	15/A9.01	14/A9.01	ALL SIZES ARE APPROXIMATE TO EXISTING WALL R.O.
W1 21	1	SECOND FLOOR	1'-0"	3'-0"	6'-0"	AL-CLAD WOOD	13/A9.01	15/A9.01	14/A9.01	ALL SIZES ARE APPROXIMATE TO EXISTING WALL R.O.
Grand total: 21										

GENERAL NOTES

- DO NOT SCALE DRAWINGS. WRITTEN DIMENSIONS TAKE PRECEDENCE. CONTACT ARCHITECT FOR CLARIFICATION IF NECESSARY IN ORDER TO DETERMINE THE INTENT OF THE CONTRACT DOCUMENTS.
- DRAWINGS NOTED AS "T.S." OR "N.T.S." ARE NOT TO SCALE.
- ALL DIMENSIONS ARE TO STRUCTURAL COLUMN LINES OR THE FACE OF FINISHED SURFACES UNLESS NOTED OTHERWISE.
- FIELD VERIFY ALL DIMENSIONS AND EXISTING CONDITION BEFORE COMMENCING WORK. NOTIFY ARCHITECT OF ANY DISCREPANCIES PRIOR TO PROCEEDING WITH AFFECTED WORK.
- NOTES OR DIMENSIONS NOTED AS "TYPICAL" OR "TYP." OR "TYP." SHALL APPLY TO CONDITIONS THAT ARE THE SAME OR SIMILAR.
- DIMENSIONS NOTED AS "FIELD VERIFY" OR "V.I.F." OR "V.I.F." SHALL BE MEASURED AND CONFIRMED AT THE PROJECT SITE BY THE CONTRACTOR AND REVIEWED WITH THE ARCHITECT BEFORE INCORPORATING INTO THE WORK.
- DIMENSIONS NOTED AS "CLEAR" OR "CLEAR INSIDE" REQUIRE SPECIFIC COORDINATION AMONG DISCIPLINES AND/OR MANUFACTURERS.
- ALL DOOR THRESHOLDS AT ALL EXTERIOR DOORS SHALL BE SET IN FULL BED OF SEALANT.
- COORD. HOUSEKEEPING PAD LOCATIONS AND DIMENSIONS WITH EQUIPMENT TO BE INSTALLED.
- ALL FLOOR FINISH MATERIAL CHANGES SHALL HAVE REDUCER STRIPS.
- ALL REQUIRED ACCESSIBLE CLEARANCES FOR ALL ITEMS, INCLUDING BUT NOT LIMITED TO ALL COUNTER TOPS, ALL PLUMBING FIXTURES, ALL LAVATOIRES, ALL URINALS, ALL TOILETS SHALL BE STRICTLY ENFORCED.
- REFER TO OTHER DISCIPLINE DOCUMENTS FOR ADDITIONAL SCOPE OF WORK.
- ALL NEW DOOR HARDWARE TO MEET TEXAS ACCESSIBLE STANDARDS TO INCLUDE BUT NOT LIMITED TO REQUIREMENTS FOR HEIGHTS, CLEARANCES, PUSH/PULL FORCE, LEVERS, CLOSERS, AND LOCKS.
- FIRST EIGHT CMU COURSES SHALL HAVE EPoxy PAINT APPLIED TO ALL EXPOSED SURFACES.
- ALL WALL MOUNTED ELECTRICAL DEVICES SHALL BE MOUNTED ABOVE THE SIXTH CMU COURSE TO REMAIN ABOVE BASE FLOOD ELEVATION.
- NEW SINGLE HUNG WINDOWS TO BE INSTALLED IN PLACE OF EXISTING MISSING WINDOW OPENINGS EXISTING WOOD-FRAMED WALLS. PROVIDE ALL NECESSARY TRIM, SEALANT AND GLAZING.
- ALL EXPOSED NEW STEEL STRUCTURE AND DECK TO BE PAINTED TO MATCH EXISTING BUILDING COLOR.



ARCHITECT Above Ground Design, PLLC
2001 Grooms Road
Cibola, Texas 78108

MEET HNS Engineering
2902 N Flores Street
San Antonio, Texas 78212

STRUCTURAL Hoffer Structural Solutions
945 Prosper Road
San Antonio, Texas 78258

COPYRIGHT 2023

BAR HOUSE, LLC
NEW BAR HOUSE

NEW NORTH 4 AND STREET
SAN ANTONIO TEXAS 78205
ISSUE FOR PERMIT

KEY PLAN

PLAN NORTH
TRUE NORTH

REGISTERED ARCHITECT
STATE OF TEXAS
AUGUST 3, 2023

CUSTOMER
BAR HOUSE, LLC
PROJECT NUMBER
#1003
DATE
AUGUST 3, 2023

REVISIONS

No.	Description	Date
1	ISSUE REVISION	08.03.2023

ISSUE FOR PERMIT

SECOND FLOOR
PLAN - AREA A

A2.02A

- 10. DIMENSIONS NOTED AS "R" OR "R" SHALL BE MEASURED INCLUSIVE OF THE CORNER COORDINATOR, ANCHOR DISCIPLES AND OR MANUFACTURERS
- 11. ALL REQUIRED ACCESSIBLE CLEARANCES FOR ALL ITEMS, INCLUDING BUT NOT LIMITED TO: TOILETS, SHOWERS, ENTRYWAYS, STAIRS, LAVATORIES, ALL WALKS, ALL TOILETS SHALL BE STRICTLY ENFORCED
- 12. REFER TO OTHER DISPERSED DOCUMENTS FOR ADDITIONAL SCOPE OF WORK
ARCHITECT	Above Ground Design, PLLC 200 Grooms Road Cibola, Texas 78108
MEPT	HIM3 Engineering 2902 N Flores Street San Antonio, Texas 78212
STRUCTURAL	Hoffer Structural Solutions 845 Proton Road San Antonio, Texas 78258
COPYRIGHT 2023	

BAR HOUSE, LLC
NEW BAR HOUSE



KEY PLAN




AUGUST 3, 2023

[illegible]

ISSUE FOR PERMIT

**SECOND FLOOR
PLAN - AREA B**

A2.02B

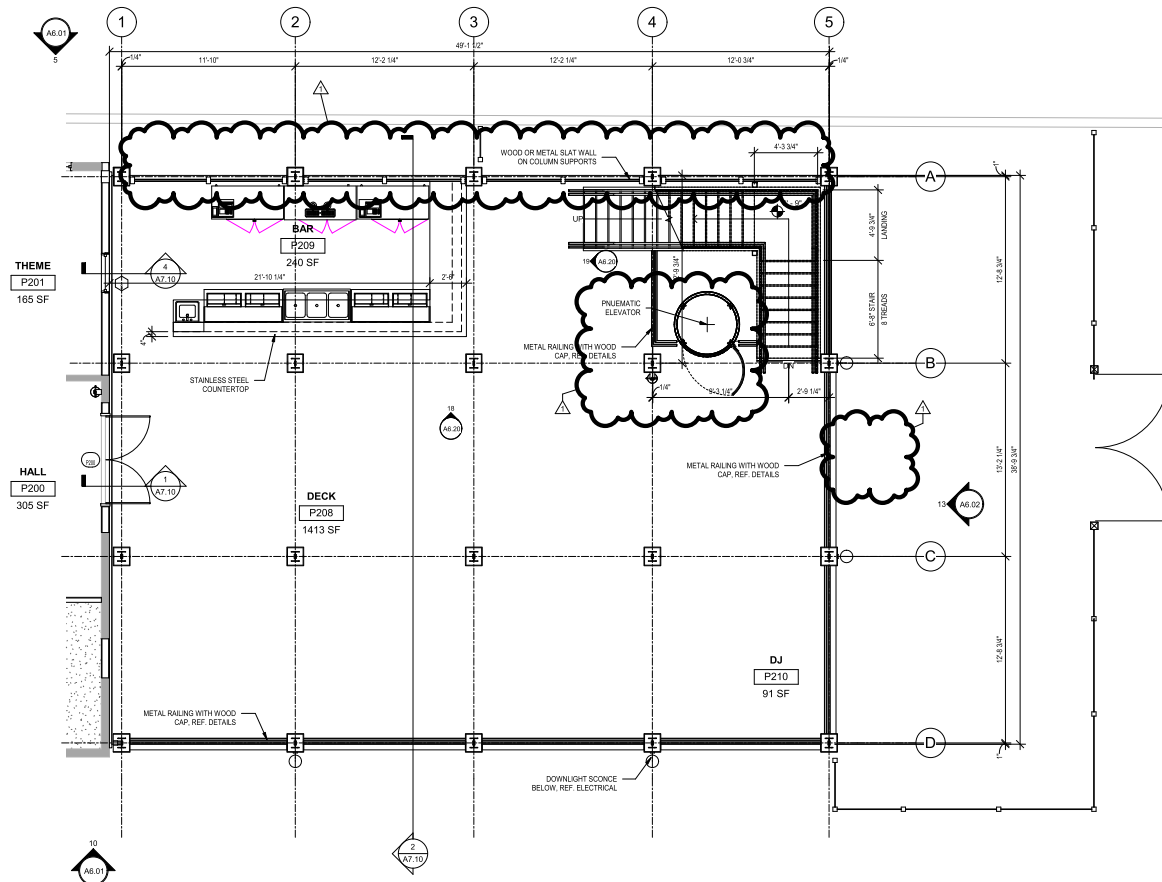

CHECKED BY: Checker

DRAWN BY: Author

8/3/2023 9:41:49 PM

5	SECOND FLOOR PLAN - AREA B 1/4" = 1'-0"
----------	---


CHECKED BY: Checker

DRAWN BY: Author

8/3/2023 9:41:50 PM

5 THIRD FLOOR PLAN - AREA B

1/8" = 1'-0"

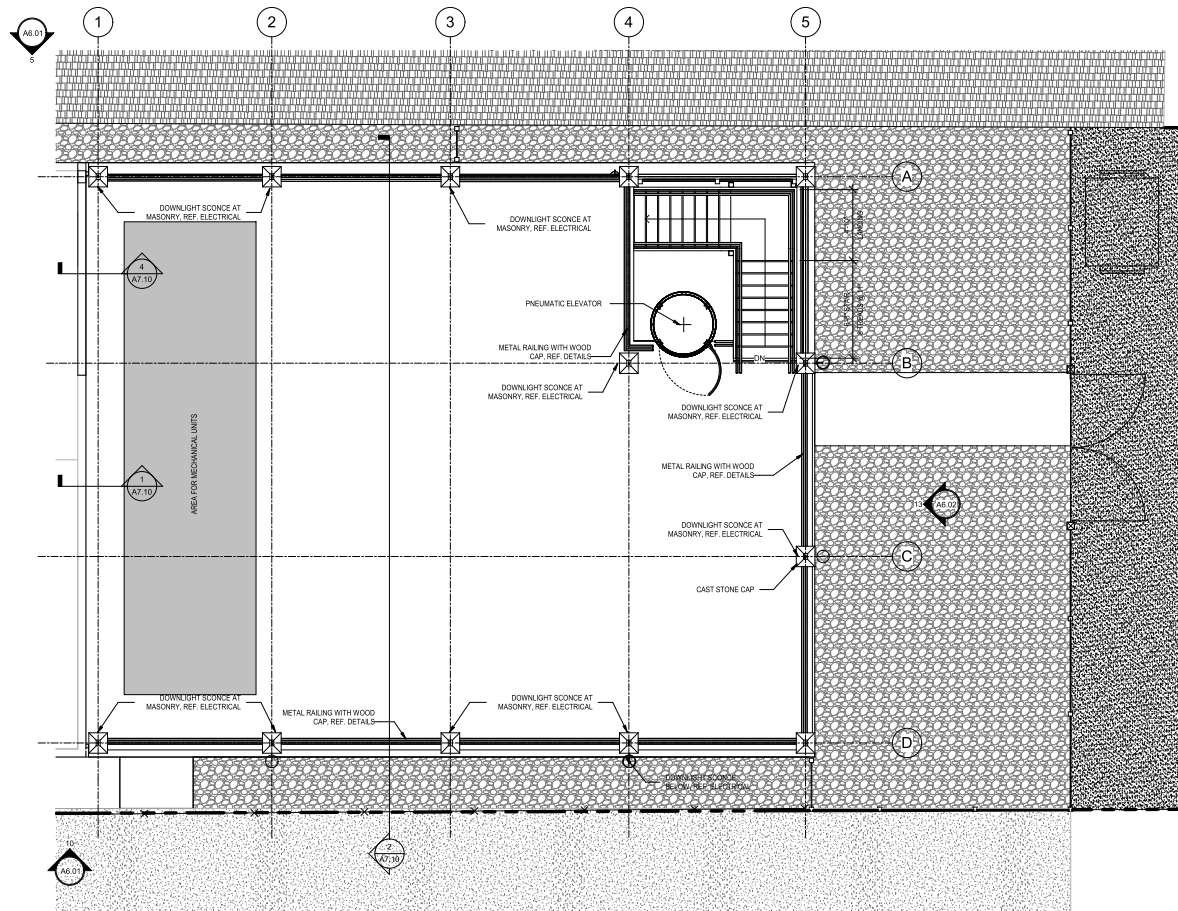

ARCHITECT	Above Ground Design, PLLC 2001 Grooms Road Cibola, Texas 78108
MEPT	HMS Engineering 2902 N Flores Street San Antonio, Texas 78212
STRUCTURAL	Hoffer Structural Solutions 945 Prosper Road San Antonio, Texas 78258
COPYRIGHT 2023	

BAR HOUSE, LLC
NEW BAR HOUSE

BETWEEN 4 AND STREET
SAN ANTONIO TEXAS 78215
ISSUE FOR PERMIT



KEY PLAN

PLAN
NORTH




AUGUST 3, 2023


CLIENT BAR HOUSE, LLC		
PROJECT NUMBER 21003		
DATE		AUGUST 3, 2023
REVISIONS		
No.	Description	Date
1	COSA REVISION	08.03.2023

ISSUE FOR PERMIT
THIRD FLOOR PLAN
- AREA B


A2.03B

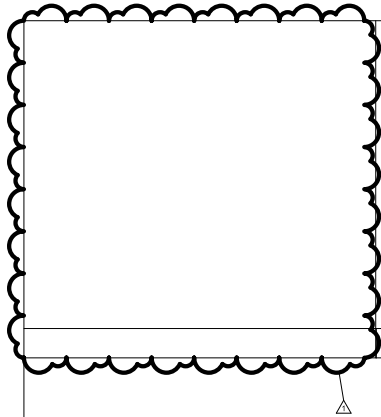


19 METAL ROOF RIDGE
1 1/2" x 1'-0"

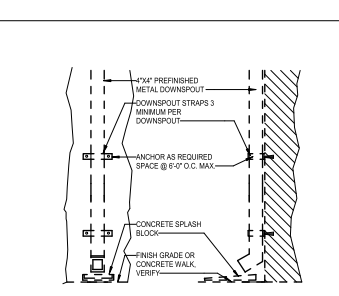

18 ROOF DOWNSPOUT
1 1/2" x 1'-0"

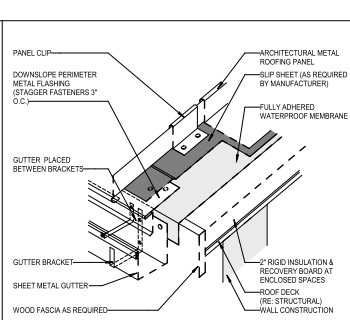

17 ROOF EDGE W/ GUTTER
1 1/2" x 1'-0"

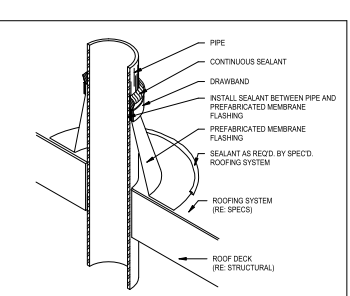


16 PIPE PENETRATION - ROOF
1 1/2" x 1'-0"


CHECKED BY: Checker

DRAWN BY: Author

8/3/2023 9:41:52 PM

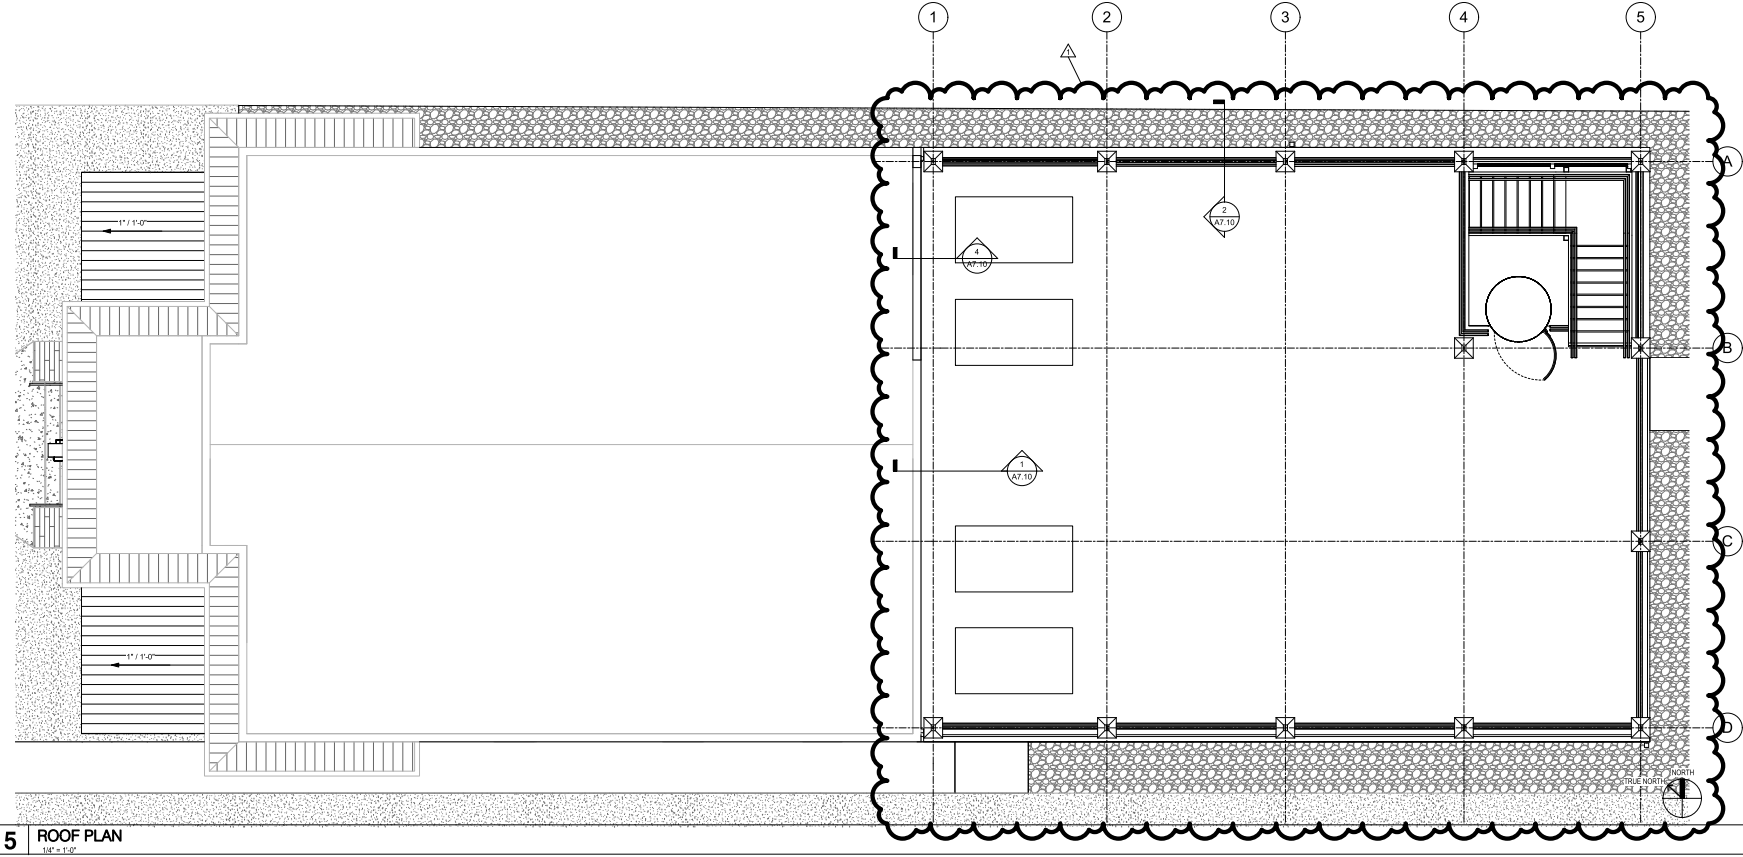

5 ROOF PLAN
1/4" = 1'-0"



ARCHITECT Above Ground Design, PLLC
2001 Grooms Road
Cibola, Texas 78108


MEPT HNS Engineering
2902 N Flores Street
San Antonio, Texas 78212

STRUCTURAL Hoffer Structural Solutions
940 Pryor Road
San Antonio, Texas 78258

COPYRIGHT 2023


BAR HOUSE, LLC
NEW BAR HOUSE

360 NORTH A AND STREET
SAN ANTONIO TEXAS 78205
ISSUE FOR PERMIT

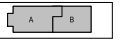

KEY PLAN

PLAN NORTH
TRUE NORTH



AUGUST 3, 2023

CLIENT
BAR HOUSE, LLC

PROJECT NUMBER
21003

DATE
AUGUST 3, 2023


REVISIONS	No.	Description	Date
1	EXISA REVISION		08/03/2023

ISSUE FOR PERMIT


ROOF PLAN & DETAILS

A3.01

EXTERIOR MATERIALS LEGEND

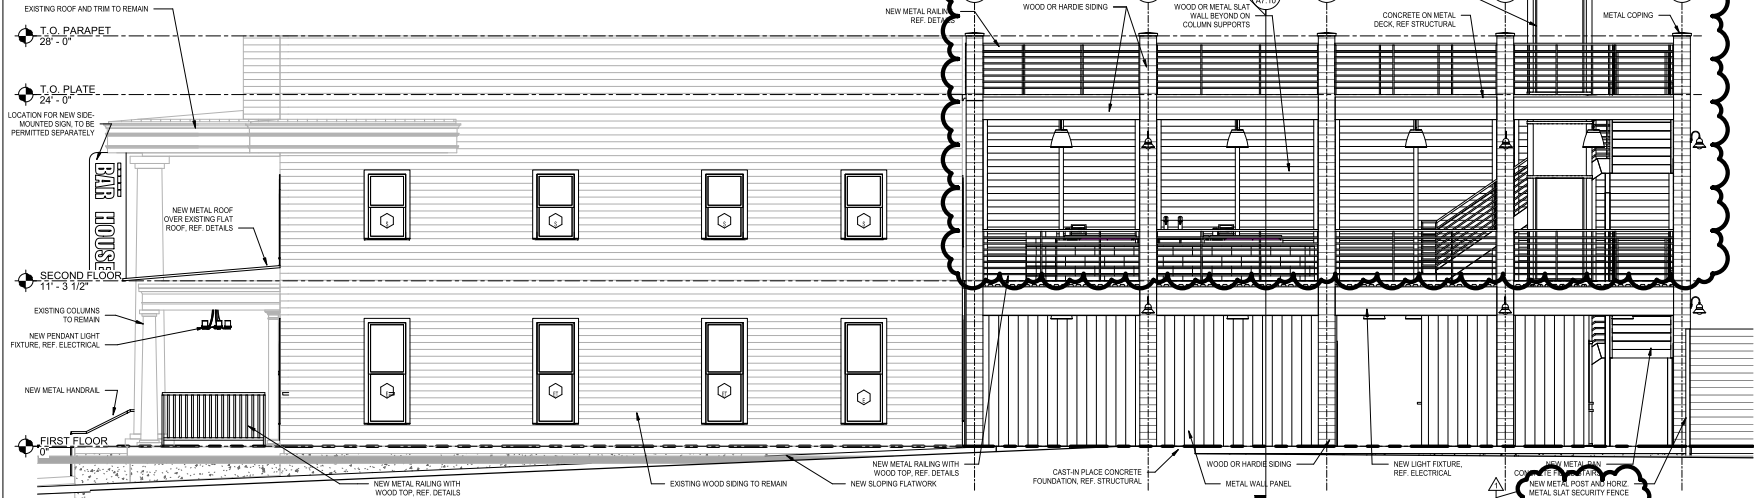

10 BARHOUSE EXTERIOR ELEVATION - SOUTH
1/4" = 1'-0"

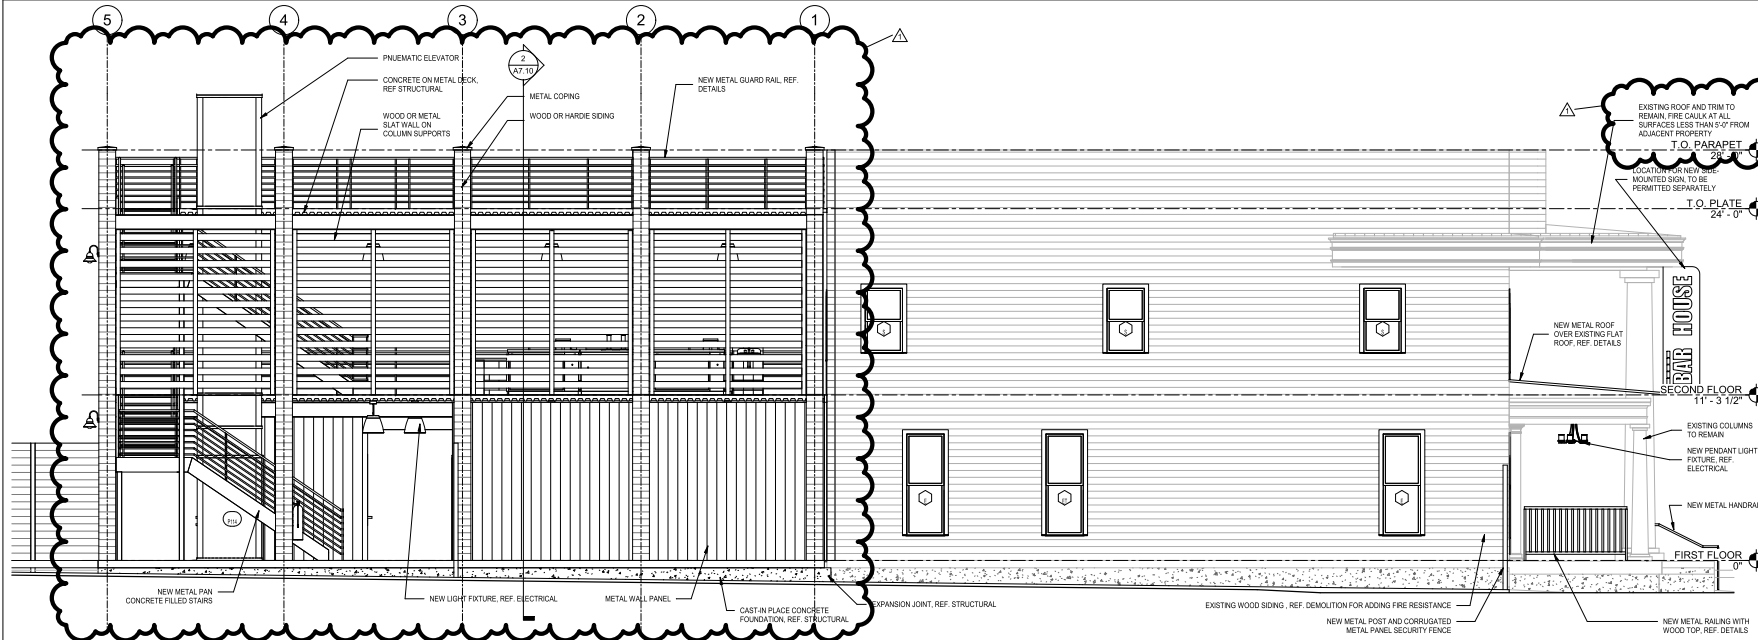

5 BARHOUSE EXTERIOR ELEVATION - NORTH
1/4" = 1'-0"



ARCHITECT Above Ground Design, PLLC
2001 Grimes Road
Cibola, Texas 78108
MEET HNS Engineering
2902 N Flores Street
San Antonio, Texas 78212
STRUCTURAL Hoffer Structural Solutions
945 Prosper Road
San Antonio, Texas 78258
COPYRIGHT 2023

BAR HOUSE, LLC
NEW BAR HOUSE

NEW NORTH AND STREET
SAN ANTONIO TEXAS 78205
ISSUE FOR PERMIT



KEY PLAN

PLAN NORTH
TRUE NORTH



CLIENT BAR HOUSE, LLC
PROJECT NUMBER 21003
DATE AUGUST 3, 2023
REVISIONS
No. Description Date
1 EXISA REVISION 08.03.2023

ISSUE FOR PERMIT
EXTERIOR ELEVATIONS

A6.01

CHECKED BY: Checker

DRAWN BY: Author



8/3/2023 9:41:59 PM

CHECKED BY: Checker


DRAWN BY: Author

8/3/2023 9:42:03 PM

EXTERIOR MATERIALS LEGEND

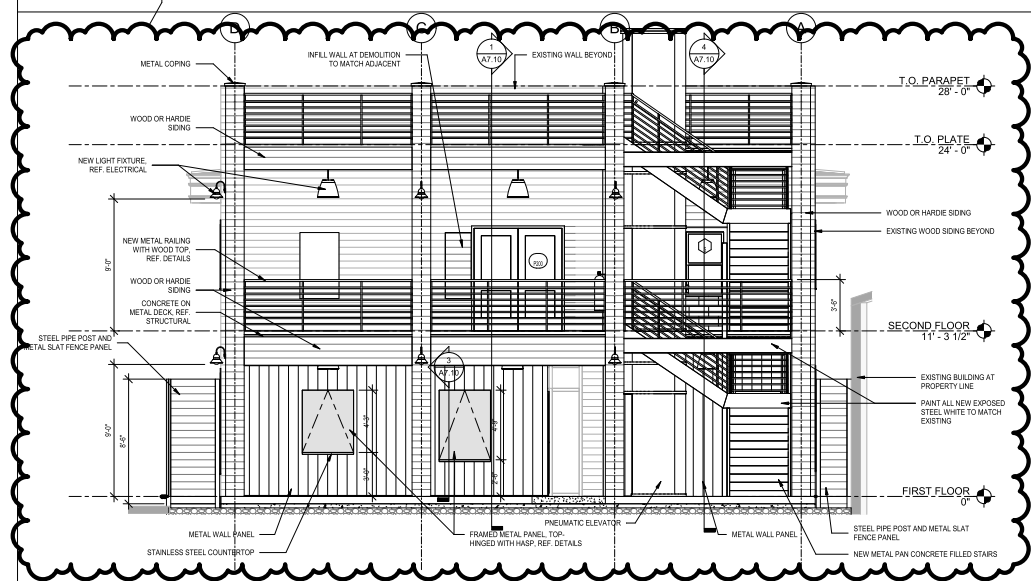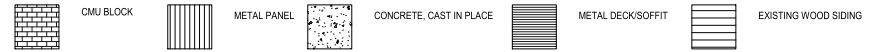

13 BARHOUSE EXTERIOR ELEVATION - EAST
1/4" = 1'-0"

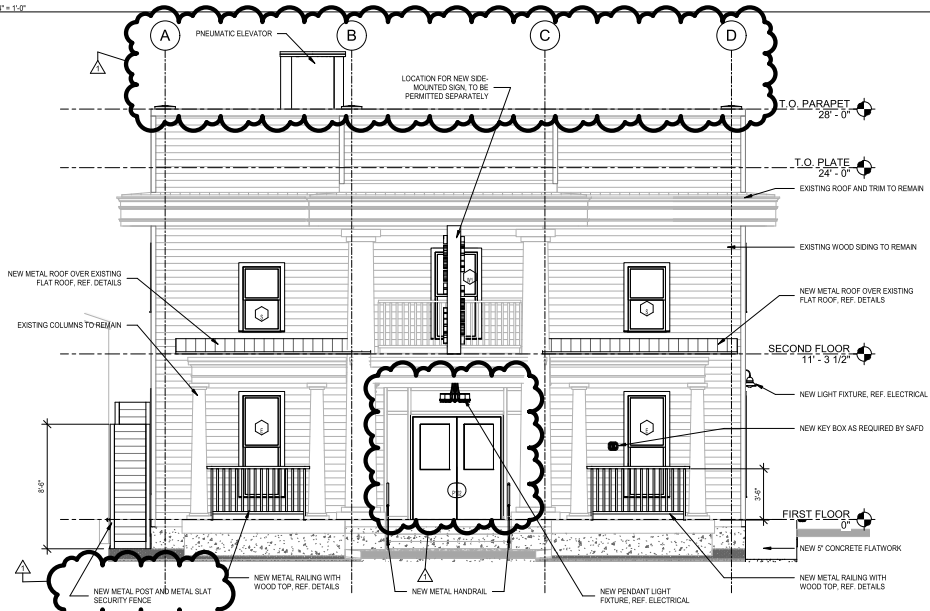


3 BARHOUSE EXTERIOR ELEVATION - WEST
1/4" = 1'-0"



ARCHITECT Above Ground Design, PLLC
2001 Grooms Road
Cibola, Texas 78108
MEPT HNS Engineering
2902 N Flores Street
San Antonio, Texas 78212
STRUCTURAL Hoffer Structural Solutions
940 Prosper Road
San Antonio, Texas 78258
COPYRIGHT 2023

BAR HOUSE, LLC
NEW BAR HOUSE

200 NORTH A AND STREET
SAN ANTONIO, TEXAS 78215
ISSUE FOR PERMIT

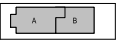

KEY PLAN

PLAN
NORTH
TRUE
NORTH



CLIENT BAR HOUSE, LLC		
PROJECT NUMBER 21003		
DATE AUGUST 3, 2023		
REVISIONS		
No.	Description	Date
1	ISSUE REVISION	08/03/2023

ISSUE FOR PERMIT
**EXTERIOR
ELEVATIONS**


A6.02

CHECKED BY: Checker


Autor

DRAWN BY:


8/3/2023 9:42:12 PM

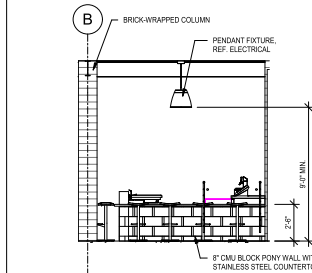


19 SECOND FLOOR BAR NORTH ELEVATION
10' ± 1'-0"

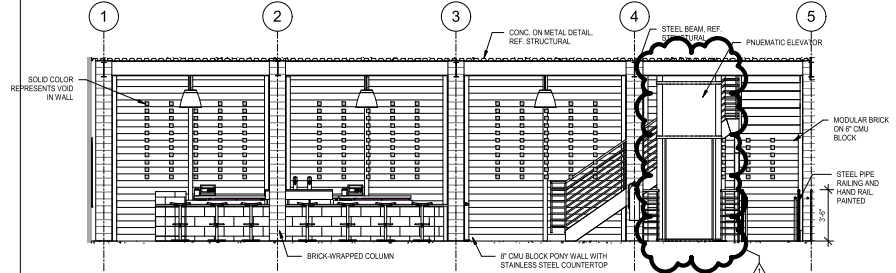


18 SECOND FLOOR BAR EAST
10' ± 1'-0"

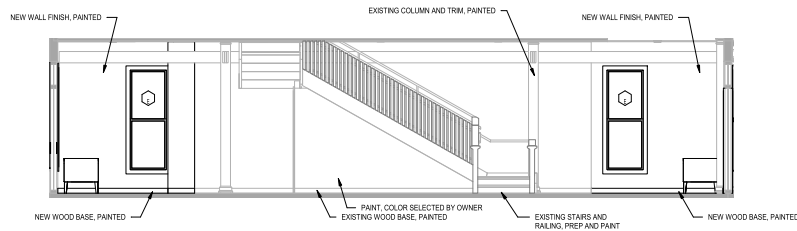


15 EXISTING STAIR WEST ELEVATION
10' ± 1'-0"

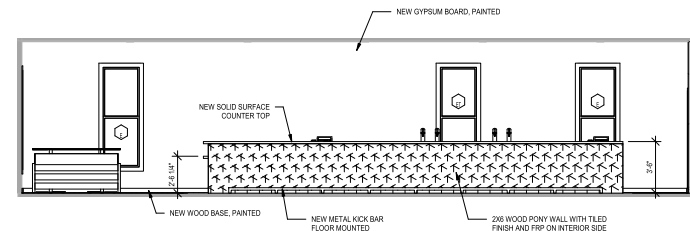


12 LOUNGE FRONT ELEVATION
10' ± 1'-0"

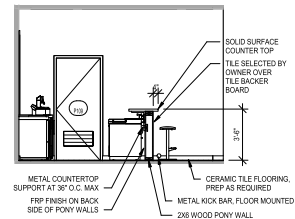


10 LOUNGE SOUTH ELEVATION
10' ± 1'-0"

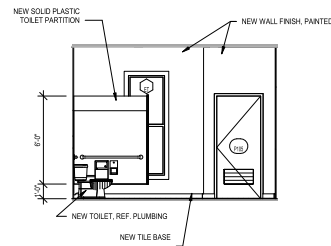


9 WOMEN'S WEST ELEVATION
10' ± 1'-0"

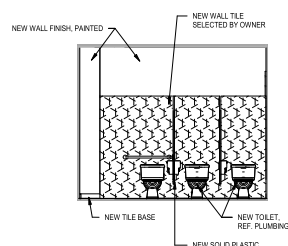


8 WOMEN'S SOUTH ELEVATION
10' ± 1'-0"

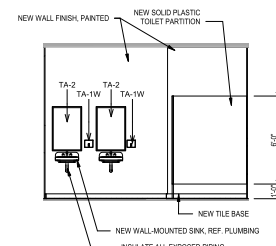


7 WOMEN'S EAST ELEVATION
10' ± 1'-0"

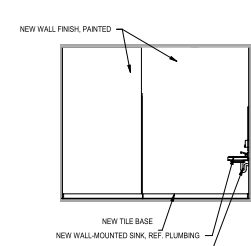


6 WOMEN'S NORTH ELEVATION
10' ± 1'-0"

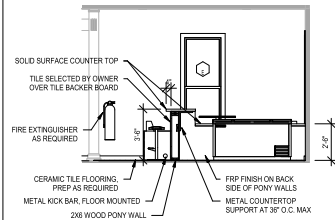


5 LOUNGE NORTH ELEVATION
10' ± 1'-0"

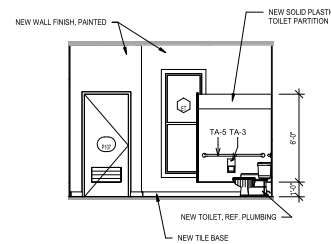


4 MEN'S WEST ELEVATION
10' ± 1'-0"

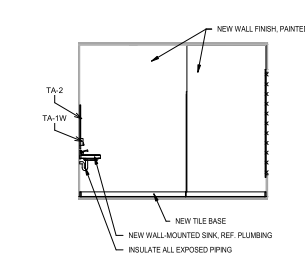

3 MEN'S SOUTH ELEVATION
10' ± 1'-0"

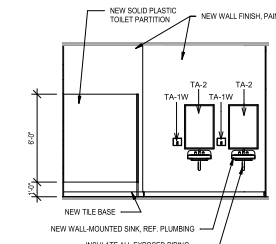

2 MEN'S EAST ELEVATION
10' ± 1'-0"

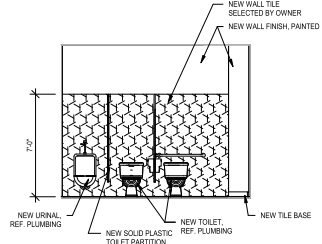


1 MEN'S NORTH ELEVATION
10' ± 1'-0"



ARCHITECT Above Ground Design, PLLC
2001 Grooms Road
Cibola, Texas 78108
MEET HNS Engineering
2902 N Flores Street
San Antonio, Texas 78212
STRUCTURAL Hoffer Structural Solutions
945 Prosper Road
San Antonio, Texas 78258
COPYRIGHT 2023

BAR HOUSE, LLC
NEW BAR HOUSE

NEW NORTH AND STREET
SAN ANTONIO TEXAS 78215
ISSUE FOR PERMIT

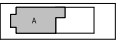

KEY PLAN

PLAN NORTH
TRUE NORTH



CLIENT BAR HOUSE, LLC
PROJECT NUMBER 21003
DATE AUGUST 3, 2023
REVISIONS
No. Description Date
1 EXISA REVISION 08/03/2023


ISSUE FOR PERMIT
INTERIOR ELEVATIONS

A6.20

CHECKED BY: Checker

DRAWN BY: Author


8/3/2023 9:42:16 PM

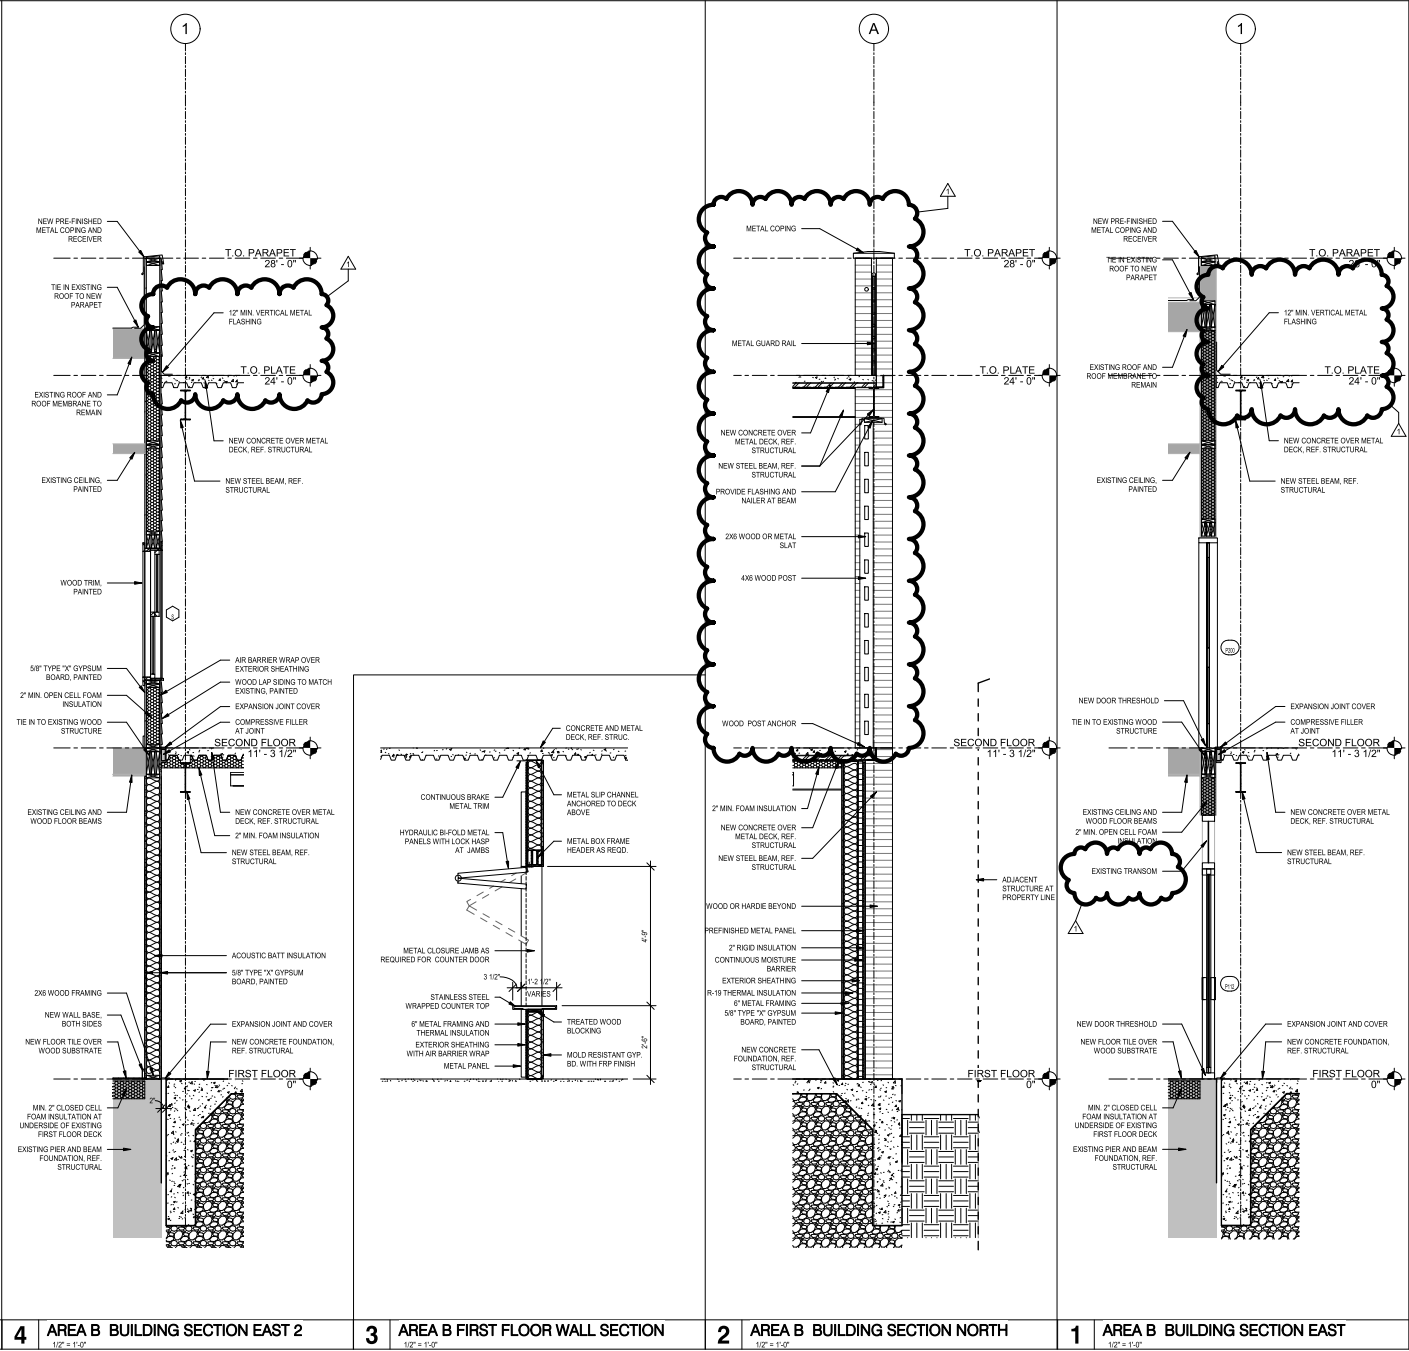

ARCHITECT Above Ground Design, PLLC
2001 Grooms Road
Cibola, Texas 78108
MEET HNS Engineering
2902 N Flores Street
San Antonio, Texas 78212
STRUCTURAL Hoffer Structural Solutions
940 Prosper Road
San Antonio, Texas 78258
COPYRIGHT 2023

BAR HOUSE, LLC
NEW BAR HOUSE

NEW NORTH AND STREET
SAN ANTONIO TEXAS 78205
ISSUE FOR PERMIT

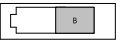

KEY PLAN

PLAN NORTH
TRUE NORTH



CLIENT BAR HOUSE, LLC		
PROJECT NUMBER #1003		
DATE AUGUST 3, 2023		
REVISIONS		
No.	Description	Date
1	ISSUE FOR PERMIT	08/03/2023


ISSUE FOR PERMIT
WALL SECTION
DETAILS

A7.10

8/3/2023 9:42:19 PM

DRAWN BY:

Autor

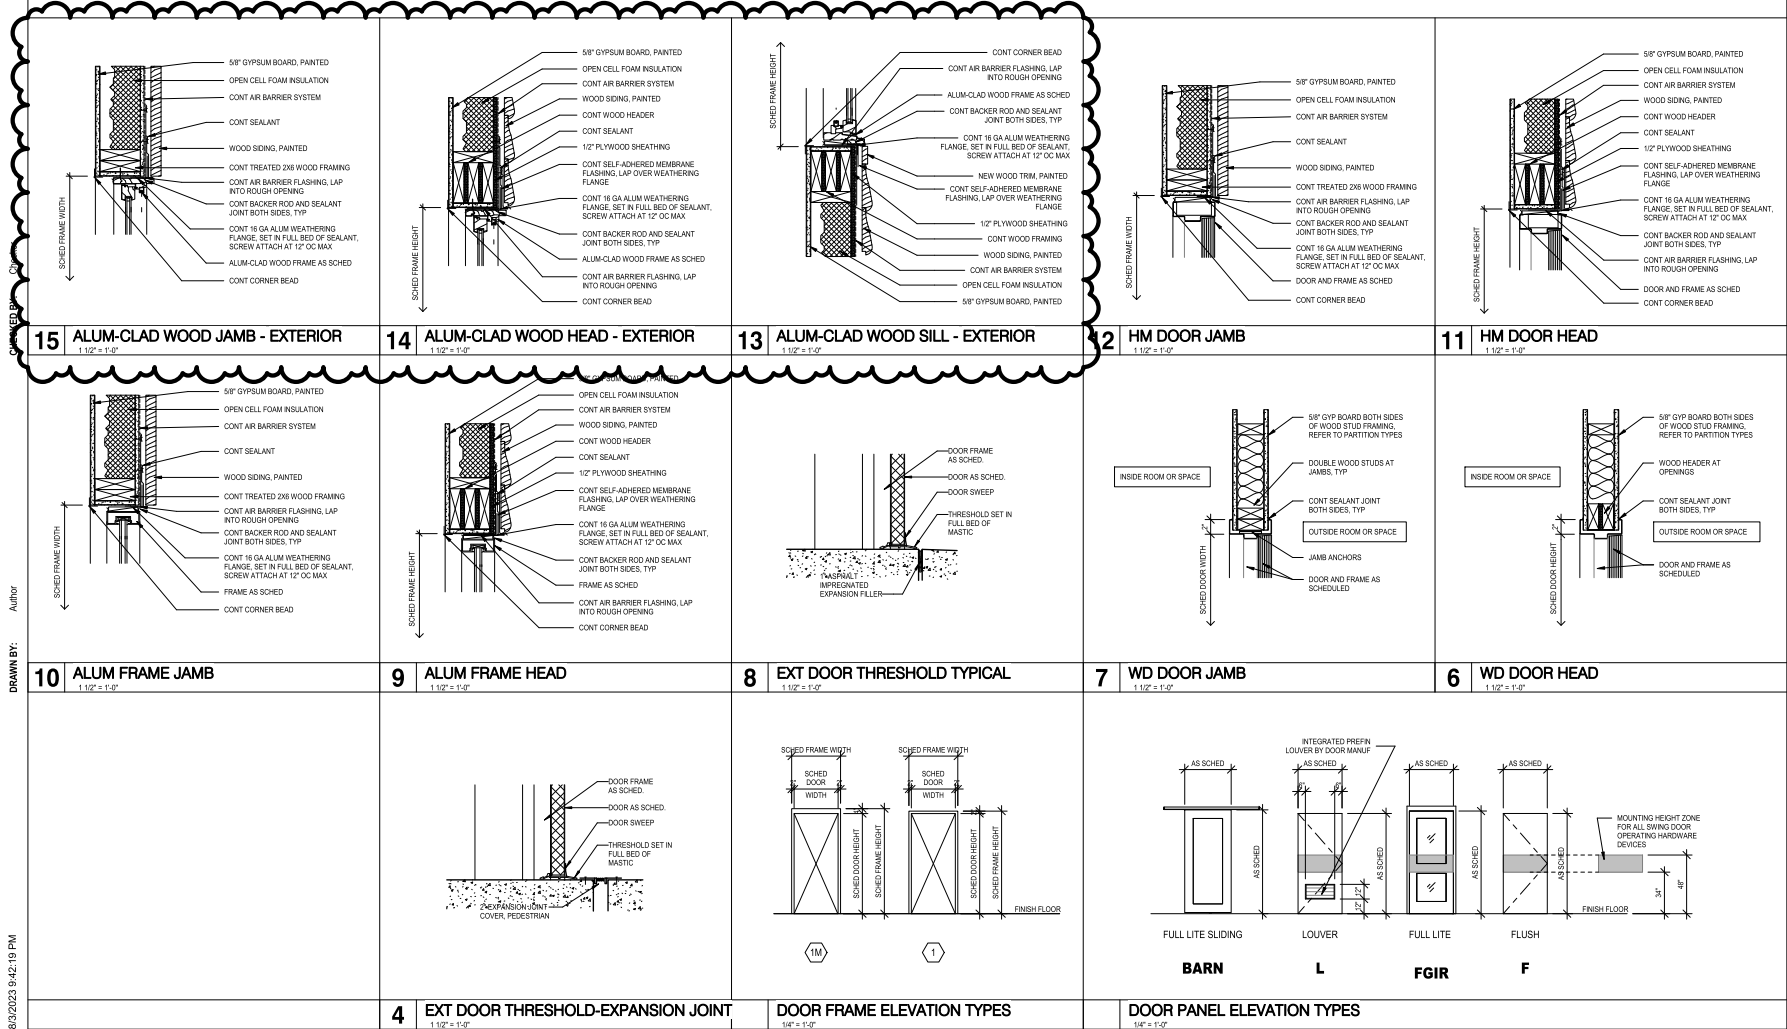

ARCHITECT Above Ground Design, PLLC
2001 Grooms Road
Cibola, Texas 78108


MEPT HNS Engineering
2902 N Flores Street
San Antonio, Texas 78212

STRUCTURAL Hoffer Structural Solutions
940 Pryor Road
San Antonio, Texas 78258

COPYRIGHT 2023

BAR HOUSE, LLC
NEW BAR HOUSE

200 NORTH A AND STREET
SAN ANTONIO TEXAS 78205
ISSUE FOR PERMIT

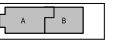

KEY PLAN

PLAN NORTH
TRUE NORTH



CLIENT BAR HOUSE, LLC
PROJECT NUMBER 21003
DATE AUGUST 3, 2023

REVISIONS

No.	Description	Date
1	ISSUE REVISION	08/03/2023


ISSUE FOR PERMIT
DOOR, WINDOW AND FRAME ELEVATIONS

A9.01

CHECKED BY: Checker

DRAWN BY: Author

8/3/2023 9:42:20 PM

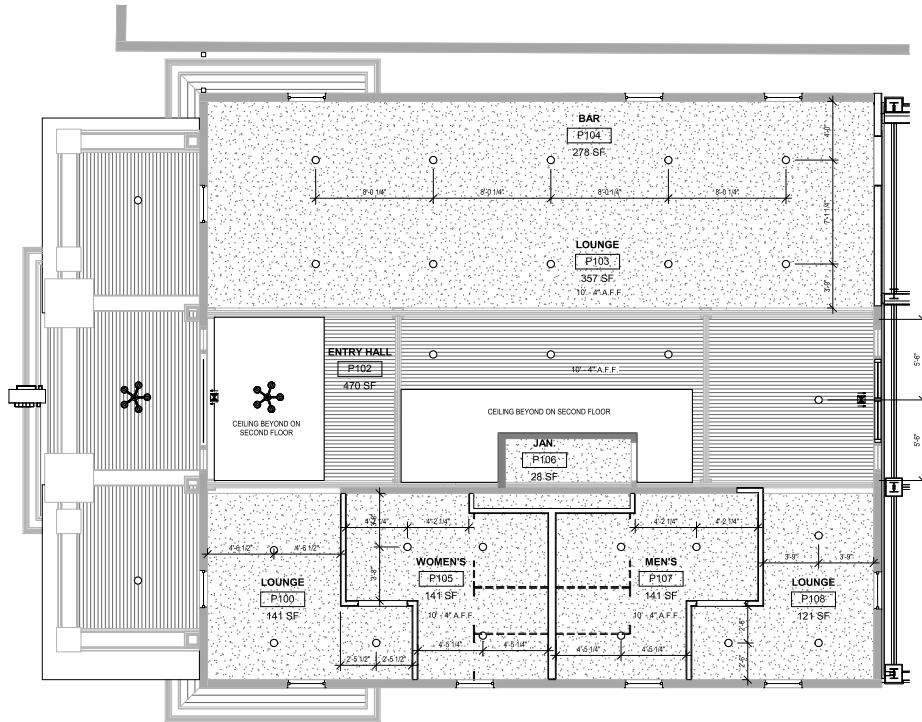

5 FIRST FLOOR REFLECTED CEILING PLAN - AREA A
1/4" = 1'-0"

GENERAL CEILING PLAN NOTES

1. REFER TO AND COORD. WITH ROOM FINISH SCHEDULES FOR SPECIFIC CEILING TYPES.
2. ALL SCHEDULED CEILING HEIGHTS ARE FROM THE MAIN FLOOR LEVEL WITHIN THE ROOM AND OR SPACE, AND ARE NOT FROM AN ELEVATED FLOOR LEVEL, AND ARE NOT FROM A RECESSED FLOOR LEVEL.
3. NO FIRE SPRINKLER HEADS ARE SHOWN ON ARCH. CEILING PLANS. ALL SPRINKLER HEADS SHALL BE CENTERED WITHIN CEILING TILES U.N.C.
4. ONLY CEILING MOUNTED FIXTURES AND EQUIP. IS SHOWN ON ARCH. CEILING PLANS. REFER TO INTERIOR ELEVATIONS FOR WALL MOUNTED FIXTURES. REFER TO MEPT DOCUMENTS FOR ADDITIONAL INFORMATION CONCERNING CEILING MOUNTED FIXTURES AND/OR WALL MOUNTED FIXTURES.
5. CEILING MOUNTED LIGHT FIXTURES ARE SHOWN FOR LOCATION PURPOSES ONLY. COORD. WITH ELEC. DOCUMENTS FOR LIGHT FIXTURE DESIGNATIONS.
6. CEILING MOUNTED LIGHT FIXTURES WITHIN FIRE RATED CEILING ASSEMBLIES SHALL HAVE LIGHT FIXTURE PROTECTION AND BE TENTED OR OTHERWISE FIRE RATED TO MATCH CEILING ASSEMBLY FIRE RATING.
7. VERIFY LOCATIONS OF ALL CEILING ACCESS PANELS WITH MEPT DOCUMENTS. COORD. LOCATIONS OF CEILING ACCESS PANELS WITH ARCH. PRIOR TO INSTALLATION. CEILING ACCESS PANEL FIRE RATINGS SHALL MATCH CEILING ASSEMBLY FIRE RATINGS.
8. REFER TO WALL SECTIONS FOR WALL-CEILING INTERFACE.

CEILING MATERIALS LEGEND


- GYPSUM BOARD
RE: FINISH SCHEDULE
- WOOD BEAD BOARD
RE: FINISH SCHEDULE
- 6" RECESSED LED CAN LIGHT
- SHIELD LED DOWN LIGHT
- EXIT LIGHT
- 1X4 LED RECESSED LIGHT
- HIGH BAY LED LIGHT FIXTURE
- LED SURFACE STRIP LIGHT FIXTURE
- LED METAL FAN



ARCHITECT	Above Ground Design, PLLC 200 Grooms Road Cibola, Texas 78108
MEPT	HMS Engineering 2902 N Flores Street San Antonio, Texas 78212
STRUCTURAL	Hoffler Structural Solutions 945 Prosper Road San Antonio, Texas 78228
COPYRIGHT 2023	

BAR HOUSE, LLC
NEW BAR HOUSE

REVISIONS
1. NORTH AND STREET
SAN ANTONIO TEXAS 78215
ISSUE FOR PERMIT

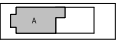

KEY PLAN

PLAN
NORTH



CLIENT		
BAR HOUSE, LLC		
PROJECT NUMBER		
21003		
DATE	AUGUST 3, 2023	
REVISIONS		
No.	Description	Date

ISSUE FOR PERMIT
REFLECTED
CEILING PLAN -
FIRST FLOOR AREA
A

A10.01A


CHECKED BY: Checker

DRAWN BY: Author

8/3/2023 9:42:22 PM

5 FIRST FLOOR REFLECTED CEILING PLAN - AREA B

1/4" = 1'-0"

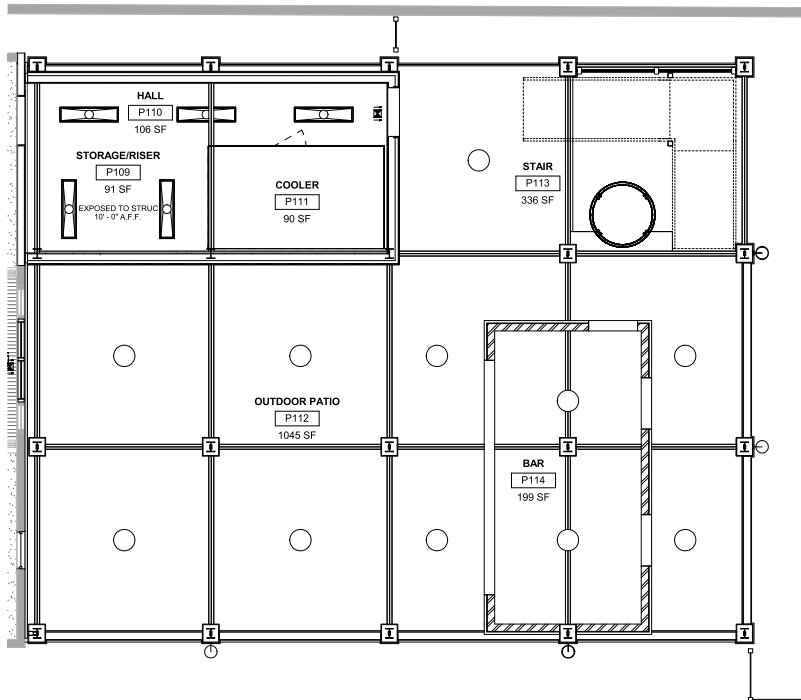

GENERAL CEILING PLAN NOTES

1. REFER TO AND COORD. WITH ROOM FINISH SCHEDULES FOR SPECIFIC CEILING TYPES.
2. ALL SCHEDULED CEILING HEIGHTS ARE FROM THE MAIN FLOOR LEVEL WITHIN THE ROOM AND OR SPACE, AND ARE NOT FROM AN ELEVATED FLOOR LEVEL, AND ARE NOT FROM A RECESSED FLOOR LEVEL.
3. NO FIRE SPRINKLER HEADS ARE SHOWN ON ARCH. CEILING PLANS. ALL SPRINKLER HEADS SHALL BE CENTERED WITHIN CEILING TILES U.N.C.
4. ONLY CEILING MOUNTED FIXTURES AND EQUIP. IS SHOWN ON ARCH. CEILING PLANS. REFER TO INTERIOR ELEVATIONS FOR WALL MOUNTED FIXTURES. REFER TO MEPT DOCUMENTS FOR ADDITIONAL INFORMATION CONCERNING CEILING MOUNTED FIXTURES AND OR WALL MOUNTED FIXTURES.
5. CEILING MOUNTED LIGHT FIXTURES ARE SHOWN FOR LOCATION PURPOSES ONLY. COORD. WITH ELEC. DOCUMENTS FOR LIGHT FIXTURE DESIGNATIONS.
6. CEILING MOUNTED LIGHT FIXTURES WITHIN FIRE RATED CEILING ASSEMBLIES SHALL HAVE LIGHT FIXTURE PROTECTION AND BE TESTED OR OTHERWISE FIRE RATED TO MATCH CEILING ASSEMBLY FIRE RATINGS.
7. VERIFY LOCATIONS OF ALL CEILING ACCESS PANELS WITH MEPT DOCUMENTS. COORD. LOCATIONS OF CEILING ACCESS PANELS WITH ARCH. PRIOR TO INSTALLATION. CEILING ACCESS PANEL FIRE RATINGS SHALL MATCH CEILING ASSEMBLY FIRE RATINGS.
8. REFER TO WALL SECTIONS FOR WALL-CEILING INTERFACE

CEILING MATERIALS LEGEND

- GYPSUM BOARD
RE: FINISH SCHEDULE
- WOOD BEAD BOARD
RE: FINISH SCHEDULE
- 6" RECESSED LED CAN LIGHT
- SHIELD LED DOWN LIGHT
- EXIT LIGHT
- 1X4 LED RECESSED LIGHT
- HIGH BAY LED LIGHT FIXTURE
- LED SURFACE STRIP LIGHT FIXTURE
- LED METAL FAN



ARCHITECT	Above Ground Design, PLLC 200 Grooms Road Cibola, Texas 78108
MEPT	HMS Engineering 2902 N Flores Street San Antonio, Texas 78212
STRUCTURAL	Hoffler Structural Solutions 945 Prosper Road San Antonio, Texas 78208
COPYRIGHT 2023	
BAR HOUSE, LLC NEW BAR HOUSE 10 NORTH A AND STREET SAN ANTONIO TEXAS 78215 ISSUE FOR PERMIT	

KEY PLAN
PLAN NORTH
TRUE NORTH

AUGUST 3, 2023


CLIENT	BAR HOUSE, LLC	
PROJECT NUMBER	21003	
DATE	AUGUST 3, 2023	
REVISIONS		
No.	Description	Date

ISSUE FOR PERMIT
REFLECTED CEILING PLAN - FIRST FLOOR AREA B
A10.01B

CHECKED BY: Checker

DRAWN BY: K.BRITAIN

8/3/2023 9:42:23 PM

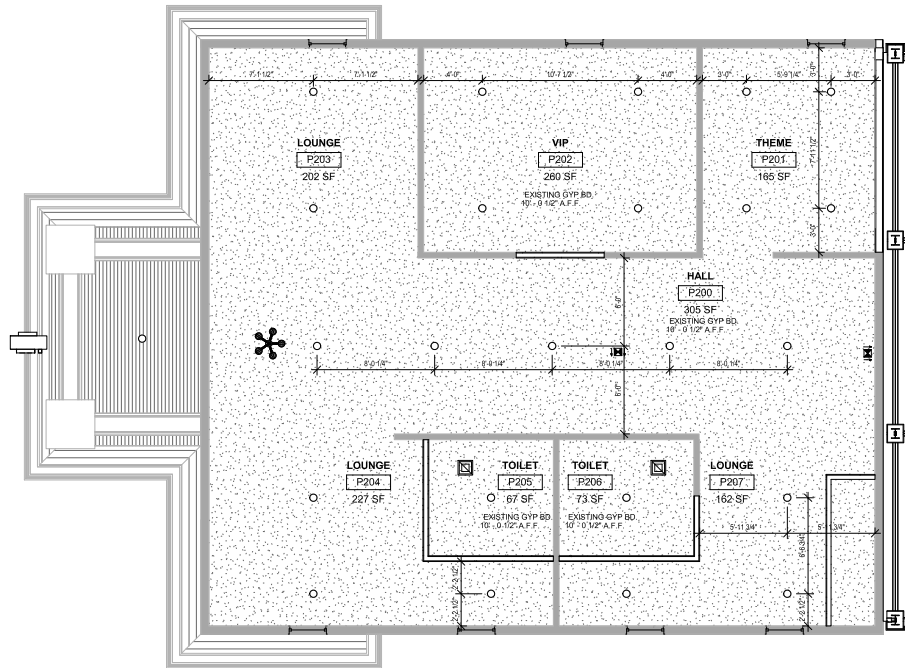









5 SECOND FLOOR REFLECTED CEILING PLAN - AREA A
1/4\"/>

GENERAL NOTES

1. DO NOT SCALE DRAWINGS. WRITTEN DIMENSIONS TAKE PRECEDENCE. CONTACT ARCHITECT FOR CLARIFICATION IF NECESSARY IN ORDER TO DETERMINE THE INTENT OF THE CONTRACT DOCUMENTS.
2. DRAWINGS NOTED AS "N.T.S." OR "NOT TO SCALE".
3. ALL DIMENSIONS ARE TO STRUCTURAL COLUMN LINES OR THE FACE OF FINISHED SURFACES UNLESS NOTED OTHERWISE.
4. FIELD VERIFY ALL DIMENSIONS AND EXISTING CONDITION BEFORE COMMENCING WORK. NOTIFY ARCHITECT OF ANY DISCREPANCIES PRIOR TO PROCEEDING WITH AFFECTED WORK.
5. NOTES OR DIMENSIONS NOTED AS "TYPICAL" OR "TYP." OR "TYP." SHALL APPLY TO CONDITIONS THAT ARE THE SAME OR SIMILAR.
6. DIMENSIONS NOTED AS "FIELD VERIFY" OR "V.F." OR "VF" SHALL BE MEASURED AND CONFIRMED AT THE PROJECT SITE BY THE CONTRACTOR AND REVIEWED WITH THE ARCHITECT BEFORE INCORPORATING INTO THE WORK.
7. COORD. HOUSEKEEPING PAD LOCATIONS AND DIMENSIONS WITH EQUIPMENT TO BE INSTALLED.
8. THE FOUNDATION PLAN, DETAILS AND GENERAL NOTES FOR THIS PROJECT DO NOT REPRESENT ENGINEERED DRAWINGS. FOR REPRESENTATION OF DESIGN INTENT ONLY. CONSULT A PROFESSIONAL ENGINEER FOR ANY WORK CONSIDERED STRUCTURAL IN NATURE. THIS INFORMATION IS FOR PERMITTING AND BIDDING PURPOSES ONLY.

CEILING MATERIALS LEGEND


-  GYPSUM BOARD
RE: FINISH SCHEDULE
-  WOOD BEAD BOARD
RE: FINISH SCHEDULE
-
-  SHIELD LED DOWN LIGHT
-  EXIT LIGHT
-  1X4 LED RECESSED LIGHT
-  HIGH BAY LED LIGHT FIXTURE
-  LED SURFACE STRIP LIGHT FIXTURE
-  LED METAL FAN



ARCHITECT	Above Ground Design, PLLC 2001 Grooms Road Cibola, Texas 78108
MEPT	HMS Engineering 2902 N Flores Street San Antonio, Texas 78212
STRUCTURAL	Hoffer Structural Solutions 940 Prosper Road San Antonio, Texas 78258 COPYRIGHT 2023

BAR HOUSE, LLC
NEW BAR HOUSE

SAN ANTONIO TEXAS 78215
ISSUE FOR PERMIT

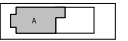

KEY PLAN

PLAN
NORTH

TRUE
NORTH



CLIENT BAR HOUSE, LLC		
PROJECT NUMBER 21003		
DATE	AUGUST 3, 2023	
REVISIONS		
No.	Description	Date


ISSUE FOR PERMIT
REFLECTED
CEILING PLAN -
SECOND FLOOR
AREA A

A10.02A

CHECKED BY: Checker

DRAWN BY: Author



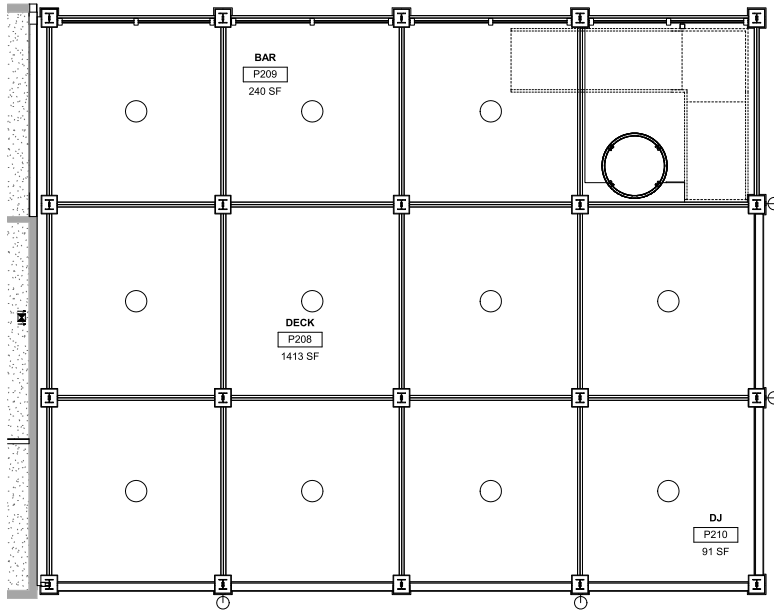






8/3/2023 9:42:25 PM



GENERAL CEILING PLAN NOTES



1. REFER TO AND COORD. WITH ROOM FINISH SCHEDULES FOR SPECIFIC CEILING TYPES.
2. ALL SCHEDULED CEILING HEIGHTS ARE FROM THE MAIN FLOOR LEVEL WITHIN THE ROOM AND OR SPACE, AND ARE NOT FROM AN ELEVATED FLOOR LEVEL, AND ARE NOT FROM A RECESSED FLOOR LEVEL.
3. NO FIRE SPRINKLER HEADS ARE SHOWN ON ARCH. CEILING PLANS. ALL SPRINKLER HEADS SHALL BE CENTERED WITHIN CEILING TILES UNLESS OTHERWISE NOTED.
4. ONLY CEILING MOUNTED FIXTURES AND EQUIP. IS SHOWN ON ARCH. CEILING PLANS. REFER TO INTERIOR ELEVATIONS FOR WALL MOUNTED FIXTURES. REFER TO MEPT DOCUMENTS FOR ADDITIONAL INFORMATION CONCERNING CEILING MOUNTED FIXTURES AND OR WALL MOUNTED FIXTURES.
5. CEILING MOUNTED LIGHT FIXTURES ARE SHOWN FOR LOCATION PURPOSES ONLY. COORD. WITH ELEC. DOCUMENTS FOR LIGHT FIXTURE DESIGNATIONS.
6. CEILING MOUNTED LIGHT FIXTURES WITHIN FIRE RATED CEILING ASSEMBLIES SHALL HAVE LIGHT FIXTURE PROTECTION AND BE TENTED OR OTHERWISE FIRE RATED TO MATCH CEILING ASSEMBLY FIRE RATING.
7. VERIFY LOCATIONS OF ALL CEILING ACCESS PANELS WITH MEPT DOCUMENTS. COORD. LOCATIONS OF CEILING ACCESS PANELS WITH ARCH. PRIOR TO INSTALLATION. CEILING ACCESS PANEL FIRE RATINGS SHALL MATCH CEILING ASSEMBLY FIRE RATINGS.
8. REFER TO WALL SECTIONS FOR WALL-CEILING INTERFACE

CEILING MATERIALS LEGEND

-  GYPSUM BOARD
RE: FINISH SCHEDULE
-  WOOD BEAD BOARD
RE: FINISH SCHEDULE
-  6" RECESSED LED CAN LIGHT
-  SHIELD LED DOWN LIGHT
-  EXIT LIGHT
-  1X4 LED RECESSED LIGHT
-  HIGH BAY LED LIGHT FIXTURE
-  LED SURFACE STRIP LIGHT FIXTURE
-  LED METAL FAN



ARCHITECT	Above Ground Design, PLLC 2001 Grooms Road Cibola, Texas 78108
MEPT	HMS Engineering 2902 N Flores Street San Antonio, Texas 78212
STRUCTURAL	Hoffler Structural Solutions 940 Prosper Road San Antonio, Texas 78258
COPYRIGHT 2023	
BAR HOUSE, LLC NEW BAR HOUSE	
100 NORTH A AND STREET SAN ANTONIO TEXAS 78215 ISSUE FOR PERMIT	


KEY PLAN	
	B
	TRUE NORTH




CLIENT BAR HOUSE, LLC		
PROJECT NUMBER 21003		
DATE	AUGUST 3, 2023	
REVISIONS		
No.	Description	Date


ISSUE FOR PERMIT
REFLECTED CEILING PLAN - SECOND FLOOR AREA B
A10.02B

GENERAL MECHANICAL NOTES AND SPECIFICATIONS:

 


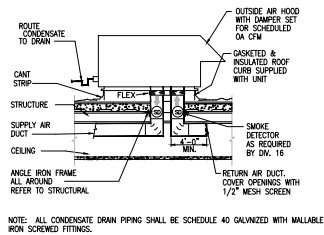


1 ROOF TOP UNIT MOUNTING DETAIL
NTS

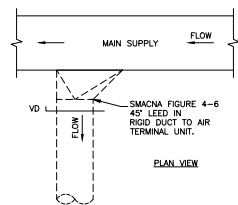


4 ALTERNATE SUPPLY DUCT TAKEOFF - AIR TERMINAL UNITS
NTS

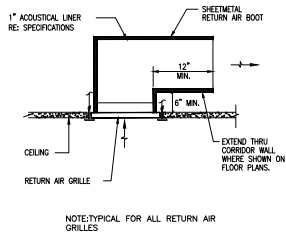


7 RETURN AIR BOOT AT GRILLE
NTS

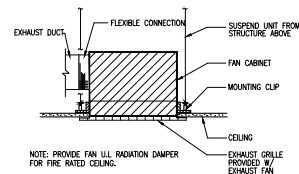


2 CEILING MOUNTED EXHAUST FAN
NTS

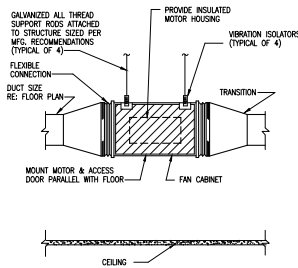


5 IN-LINE EXHAUST FAN DETAIL
NTS

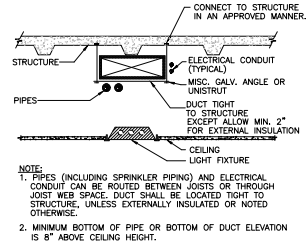


8 RECTANGULAR DUCT INSTALLATION
NTS

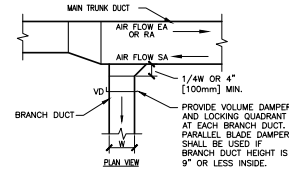

3 BRANCH DUCT TAKE-OFF PAN VIEW
NTS

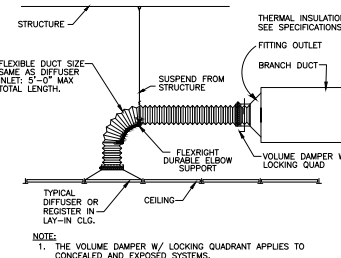

6 FLEXIBLE AIR DUCT CONNECTOR
NTS

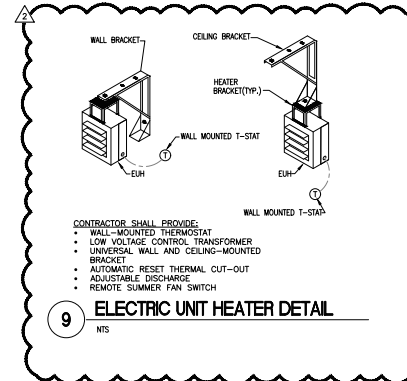

9 ELECTRIC UNIT HEATER DETAIL
NTS

HMB
ENGINEERING
CONSULTANTS

2902 NORTH FLORES
SAN ANTONIO, TEXAS 78212
210.393.1840 PHONE
SAN ANTONIO - RGJ
TPE FIRM REGISTRATION NO. 13341

ARCHITECT Above Ground Design, PLLC
200 Grooms Road
Cocke, Texas 78108

MEPT HMB Engineering
2802 N Flores Street
San Antonio, Texas 78212

STRUCTURAL Hoffer Structural Solutions
948 Preston Road
San Antonio, Texas 78256

COPYRIGHT 2023

BAR HOUSE, LLC
NEW BAR HOUSE
100 NORTH ALAMO STREET
SAN ANTONIO, TEXAS 78205
DESIGN DEVELOPMENT

KEY PLAN
PLAN NORTH
TRUE NORTH

CLIENT BAR HOUSE, LLC
PROJECT NUMBER 23016
DATE MARCH 10, 2023

NO.	DESCRIPTION	DATE
1	HDR Comments	8/3/2023
2		
3		
4		
5		
6		
7		
8		
9		
10		

DESIGN DEVELOPMENT


MECHANICAL
DETAILS

M001

CHECKED BY: Choder

DRAWN BY: Author

DRAWN BY: Author

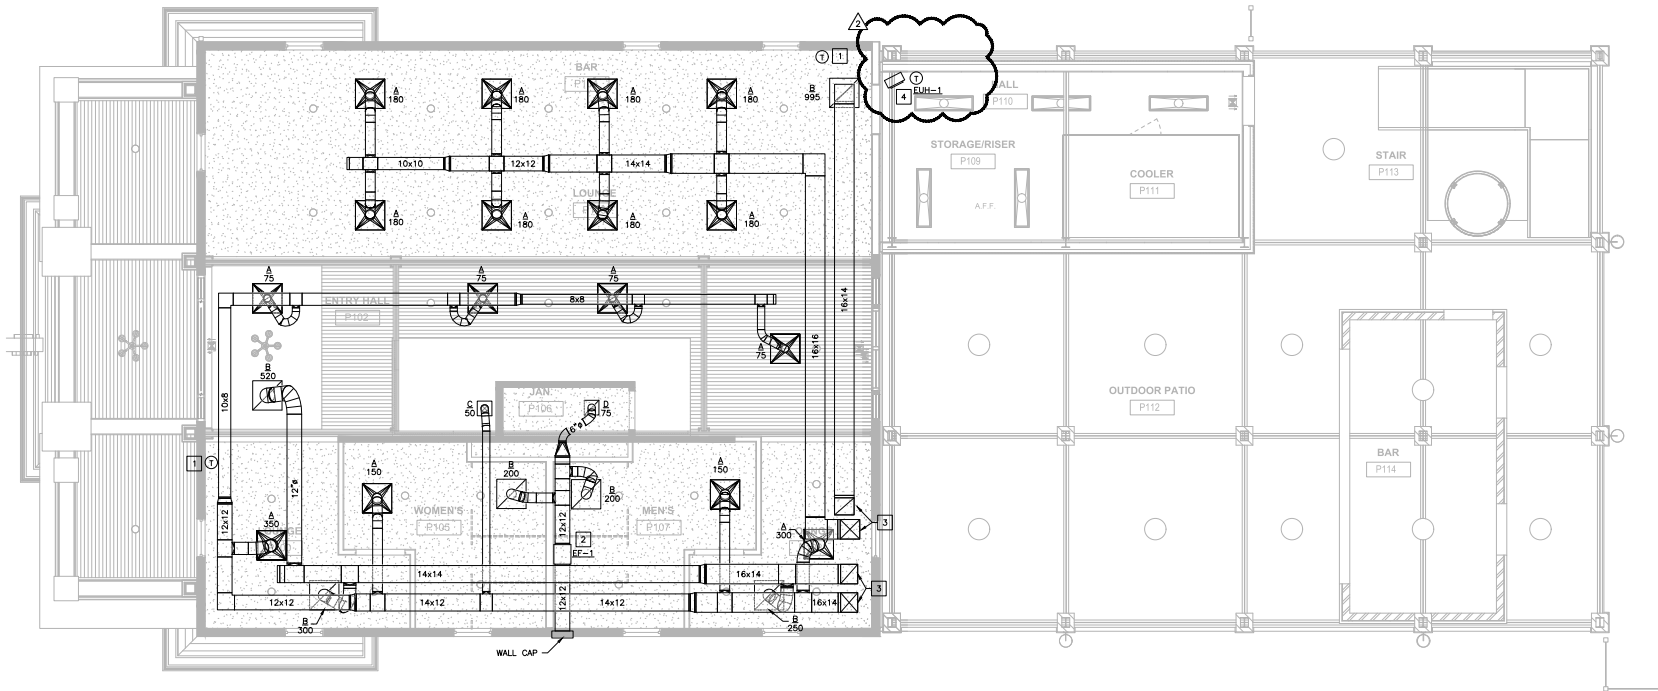

1 FIRST FLOOR MECHANICAL PLAN
1/4" = 1'-0"

MECHANICAL GENERAL NOTES:

- CONTRACTOR SHALL BALANCE EACH DEVICE WITH THE CFM SHOWN ON PLAN.
- NEW PIPING AND DUCTWORK SHOWN ON PLAN ARE SCHEMATIC ONLY. CONTRACTOR SHALL COORDINATE WITH OTHER TRADES FOR PIPING AND DUCTWORK ROUTING, OFFSET AND RUN, FITTINGS, INSULATIONS AND OTHER ACCESSORIES IN ORDER TO COMPLETE THE INSTALLATION.
- COORDINATE LOCATIONS AND SIZES OF ROOF OPENINGS WITH OWNER AND STRUCTURE ENGINEERS.
- EQUIPMENT SIZES, DIMENSIONS AND REQUIRED CONNECTIONS SHALL BE VERIFIED WITH THE ACTUAL EQUIPMENT SELECTED PRIOR TO INSTALLATION.
- DUCT SIZES SHOWN ON PLANS ARE CLEAR INSIDE AIR STREAM DIMENSIONS.
- CONTRACTOR SHALL COORDINATE ALL ELECTRICAL REQUIREMENTS FOR ALL HVAC BASED ON ACTUAL EQUIPMENT SELECTED PRIOR TO INSTALLATION.
- CONTRACTOR SHALL COORDINATE EQUIPMENT WEIGHTS AND SUPPORTS BASED ON ACTUAL EQUIPMENT SELECTED.
- ALL EXPOSED DUCTWORK SHALL BE AS SHOWN, DOUBLE-WALL, INSULATED METAL, PRIMED FOR PAINTING, UNLESS OTHERWISE NOTED ON PLAN. ALL CONCEALED DUCTWORK SHALL BE INSULATED DUCT BOARD RECTANGULAR UNLESS ALLOWED IN WRITING BY THE ENGINEER OF RECORD. COORDINATE FINAL FINISH WITH ARCHITECT.
- COORDINATE WITH ALL TRADES FOR MATERIALS IN RATED AND PLENUM SPACES.
- ALL EXHAUST FANS SCHEDULED TO BE AUTOMATICALLY CONTROLLED BY MECHANICAL AIR HANDLERS SHALL BE CONNECTED BY MEANS OF AN AUXILIARY RELAY. PROVIDE AUXILIARY RELAY AS NEEDED.
- ALL SOURCE OF MECHANICAL INTAKE SHALL MAINTAIN 10 LINEAR FEET SEPARATION BETWEEN ANY SOURCE OF EXHAUST. CONTRACTOR IS RESPONSIBLE TO ADJUST DUCT LENGTH AS NEEDED.

KEYED NOTES:

- LOCATION OF DIGITAL THERMOSTAT CONTROL. PROVIDE LOCKABLE COVER.
- PROVIDE ACCESS PANEL FOR INLINE EXHAUST FAN. INTERCONNECT EXHAUST FAN WITH AUXILIARY RELAY OF RTU-2. FAN SHALL BE SUSPENDED FROM STRUCTURE ABOVE. VERIFY EXACT LOCATION OF STRUCTURAL MEMBERS PRIOR TO INSTALLATION. PROVIDE WALL CAP EQUAL TO LOREN COOK WORK-ALUM AND INSTALL BOTTOM OF WALL CAP AT SAME HEIGHT AS EXHAUST FAN.

- REFER TO M200 FOR CONTINUATION.
- PROVIDE ELECTRIC UNIT HEATER AS SCHEDULED. INTERCONNECT WITH T-STAT AND SET OUT-ON TEMP TO 40F.

HMB
ENGINEERING
CONSULTANTS

2902 NORTH ALAMOS
SAN ANTONIO, TEXAS 78212
210.393.1840 PHONE
SAN ANTONIO - RGJ
TYPE FIRM REGISTRATION NO. 13241



ARCHITECT Above Ground Design, PLLC
200 Grooms Road
Cocke, Texas 78108
MEPT HMB Engineering
2802 N Flores Street
San Antonio, Texas 78212
STRUCTURAL Hoffer Structural Solutions
948 Preston Road
San Antonio, Texas 78256
COPYRIGHT 2023

BAR HOUSE, LLC
NEW BAR HOUSE

100 NORTH ALAMO STREET
SAN ANTONIO, TEXAS 78203
DESIGN DEVELOPMENT



KEY PLAN

PLAN
NORTH
TRUE
NORTH



CLIENT
BAR HOUSE, LLC
PROJECT NUMBER
23016
DATE MARCH 10, 2023
REVISIONS
No. Description Date
2 HDRC Comments 8/3/2023


DESIGN DEVELOPMENT

FIRST FLOOR
MECHANICAL PLAN

M100

CHECKED BY: Choder

DRAWN BY: Author

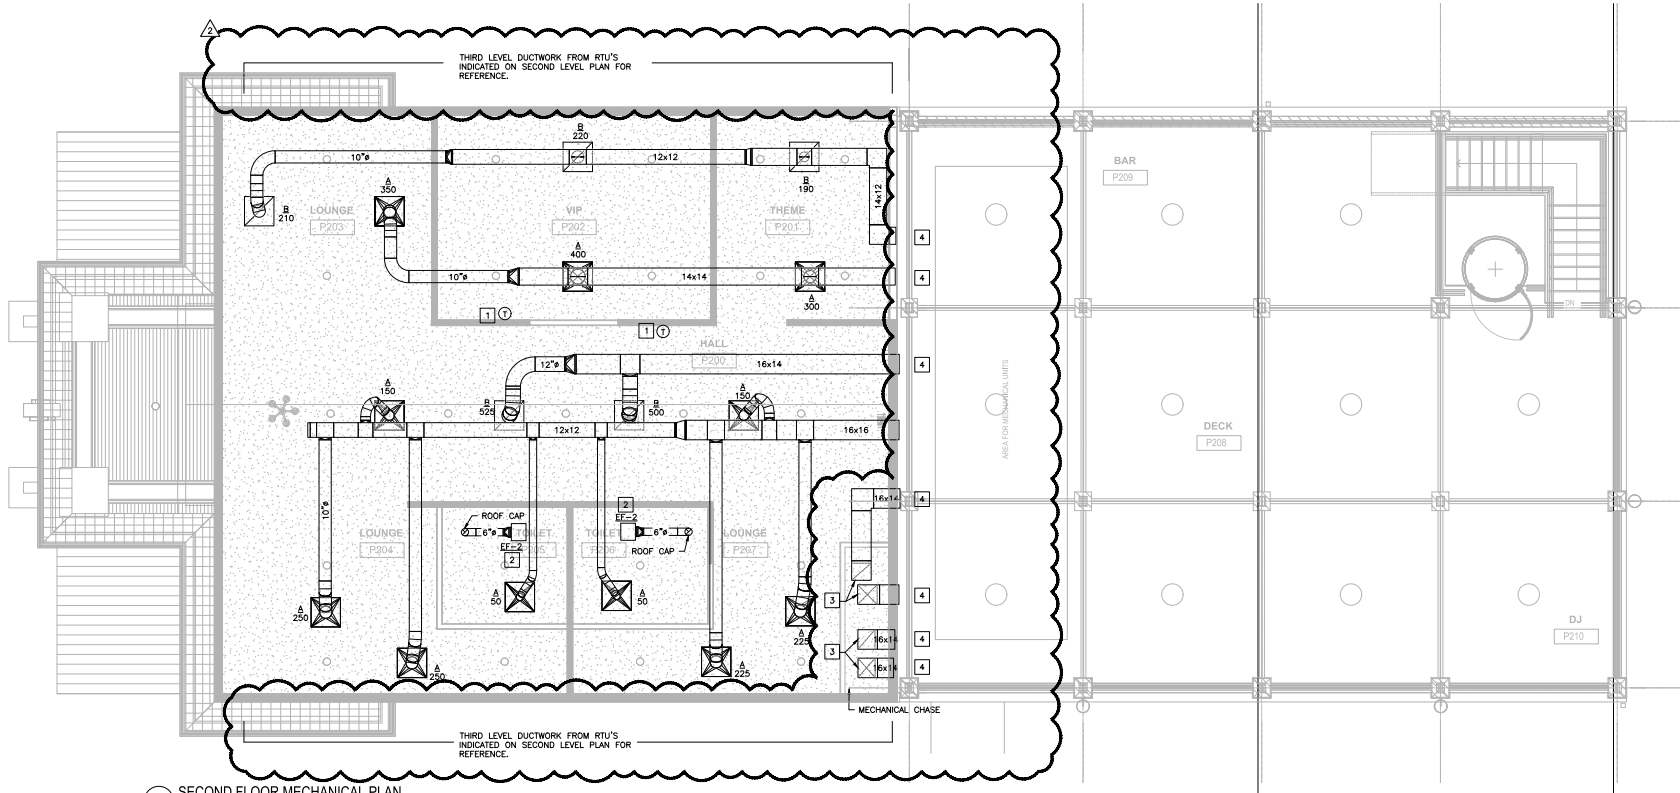

1 SECOND FLOOR MECHANICAL PLAN
1/4" = 1'-0"

MECHANICAL GENERAL NOTES:

- CONTRACTOR SHALL BALANCE EACH DEVICE WITH THE CFM SHOWN ON PLAN.
- NEW PIPING AND DUCTWORK SHOWN ON PLAN ARE SCHEMATIC ONLY. CONTRACTOR SHALL COORDINATE WITH OTHER TRADES FOR PIPING AND DUCTWORK ROUTING, OFFSET AND RUN PIPING, DUCTWORK INSIDE THE STRUCTURE IF REQUIRED, PROVIDE ANY EXTRA PIPING, DUCTWORK, FITTINGS, INSULATIONS AND OTHER ACCESSORIES IN ORDER TO COMPLETE THE INSTALLATION.
- COORDINATE LOCATIONS AND SIZES OF ROOF OPENINGS WITH OWNER AND STRUCTURE ENGINEERS.
- EQUIPMENT SIZES, DIMENSIONS AND REQUIRED CONNECTIONS SHALL BE VERIFIED WITH THE ACTUAL EQUIPMENT SELECTED VENDOR DRAWINGS BEFORE FABRICATION OF DUCTWORK, PIPING, ETC...
- DUCT SIZES SHOWN ON PLANS ARE CLEAR INSIDE AIR STREAM DIMENSIONS.
- CONTRACTOR SHALL COORDINATE ALL ELECTRICAL REQUIREMENTS FOR ALL HVAC BASED ON ACTUAL EQUIPMENT SELECTED PRIOR TO INSTALLATION.
- CONTRACTOR SHALL COORDINATE EQUIPMENT WEIGHTS AND SUPPORTS BASED ON ACTUAL EQUIPMENT SELECTED.
- ALL EXPOSED DUCTWORK SHALL BE AS SHOWN, DOUBLE-WALL, INSULATED METAL, PRIMED FOR PAINTING, UNLESS OTHERWISE NOTED ON PLAN. ALL CONCEALED DUCTWORK SHALL BE INSULATED DUCT BOARD RECTANGULAR UNLESS ALLOWED IN WRITING BY THE ENGINEER OF RECORD. COORDINATE FINAL FINISH WITH ARCHITECT.
- COORDINATE WITH ALL TRADES FOR MATERIALS IN RATED AND PLENUM SPACES.
- ALL EXHAUST FANS SCHEDULED TO BE AUTOMATICALLY CONTROLLED BY MECHANICAL AIR HANDLERS SHALL BE CONNECTED BY MEANS OF AN AUXILIARY RELAY. PROVIDE AUXILIARY RELAY AS NEEDED.
- ALL SOURCE OF MECHANICAL INTAKE SHALL MAINTAIN 10 LINEAR FEET SEPARATION BETWEEN ANY SOURCE OF EXHAUST. CONTRACTOR IS RESPONSIBLE TO ADJUST DUCT LENGTH AS NEEDED.

2 KEYED NOTES:

- LOCATION OF DIGITAL THERMOSTAT CONTROL. PROVIDE LOOKABLE COVER.
- PROVIDE ACCESS PANEL FOR CEILING MOUNTED EXHAUST FAN. INTERCONNECT EXHAUST FAN WITH LIGHTS IN THIS ROOM. REFER TO ELECTRICAL LIGHTING PLAN. FAN SHALL BE SUPPLIED FROM STRUCTURE ABOVE. VERIFY EXACT LOCATION OF STRUCTURAL MEMBERS PRIOR TO INSTALLATION. PROVIDE ROOF CAP.
- REFER TO M200 FOR CONTINUATION.
- REFER TO M200 FOR CONTINUATION.

HMB
ENGINEERING
CONSULTANTS

2902 NORTH FLORES
SAN ANTONIO, TEXAS 78212
210.393.1840 PHONE
SAN ANTONIO - RGV
TYPE FIRM REGISTRATION NO. 13341



ARCHITECT	Above Ground Design, PLLC 200 Grooms Road Cibola, Texas 78108
MEPT	HMB Engineering 2802 N Flores Street San Antonio, Texas 78212
STRUCTURAL	Hoffer Structural Solutions 948 Preton Road San Antonio, Texas 78256
COPYRIGHT 2023	

BAR HOUSE, LLC
NEW BAR HOUSE

100 NORTH ALAMO STREET
SAN ANTONIO, TEXAS 78203
DESIGN DEVELOPMENT



KEY PLAN
PLAN NORTH
TRUE NORTH




CLIENT: BAR HOUSE, LLC		
PROJECT NUMBER: 23016		
DATE: MARCH 10, 2023		
REVISIONS		
No.	Description	Date
2	HDR Comments	8/3/2023
DESIGN DEVELOPMENT		

SECOND FLOOR
MECHANICAL PLAN

M200

CHECKED BY: Chandler

DRAWN BY: Author

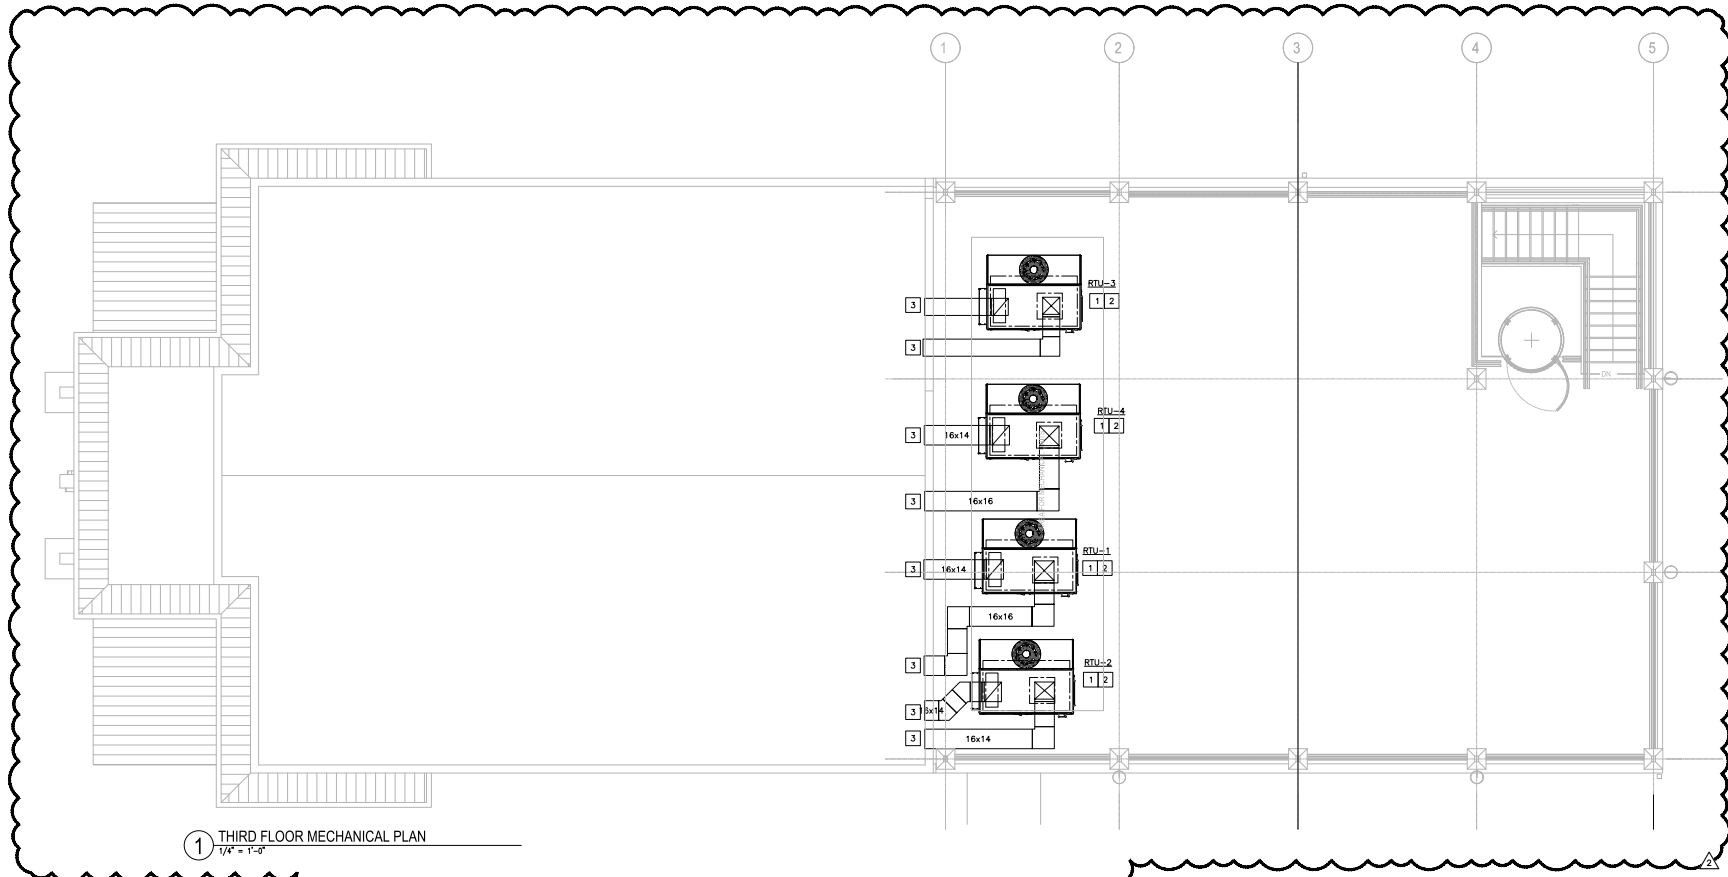

1 THIRD FLOOR MECHANICAL PLAN
1/4" = 1'-0"

MECHANICAL GENERAL NOTES:

- CONTRACTOR SHALL BALANCE EACH DEVICE WITH THE CFM SHOWN ON PLAN.
- NEW PIPING AND DUCTWORK SHOWN ON PLAN ARE SCHEMATIC ONLY. CONTRACTOR SHALL COORDINATE WITH OTHER TRADES FOR PIPING AND DUCTWORK ROUTING, OFFSET AND RUN PIPING, DUCTWORK INSIDE THE STRUCTURE IF REQUIRED. PROVIDE ANY EXTRA PIPING, DUCTWORK, FITTINGS, INSULATIONS AND OTHER ACCESSORIES IN ORDER TO COMPLETE THE INSTALLATION.
- COORDINATE LOCATIONS AND SIZES OF ROOF OPENINGS WITH OWNER AND STRUCTURE ENGINEERS.
- EQUIPMENT SIZES, DIMENSIONS AND REQUIRED CONNECTIONS SHALL BE VERIFIED WITH THE ACTUAL EQUIPMENT SELECTED VENDOR DRAWINGS BEFORE FABRICATION OF DUCTWORK, PIPING, ETC.
- DUCT SIZES SHOWN ON PLANS ARE CLEAR INSIDE AIR STREAM DIMENSIONS.
- CONTRACTOR SHALL COORDINATE ALL ELECTRICAL REQUIREMENTS FOR ALL HVAC BASED ON ACTUAL EQUIPMENT SELECTED PRIOR TO INSTALLATION.
- CONTRACTOR SHALL COORDINATE EQUIPMENT WEIGHTS AND SUPPORTS BASED ON ACTUAL EQUIPMENT SELECTED.
- ALL EXPOSED DUCTWORK SHALL BE AS SHOWN, DOUBLE-WALL, INSULATED METAL, PRIMED FOR PAINTING, UNLESS OTHERWISE NOTED ON PLAN. ALL CONCEALED DUCTWORK SHALL BE INSULATED DUCT BOARD RECTANGULAR UNLESS ALLOWED IN WRITING BY THE ENGINEER OF RECORD. COORDINATE FINAL FINISH WITH ARCHITECT.
- COORDINATE WITH ALL TRADES FOR MATERIALS IN RATED AND PLENUM SPACES.
- ALL EXHAUST FANS SCHEDULED TO BE AUTOMATICALLY CONTROLLED BY MECHANICAL AIR HANDLERS SHALL BE CONNECTED BY MEANS OF AN AUXILIARY RELAY. PROVIDE AUXILIARY RELAY AS NEEDED.
- ANY SOURCE OF MECHANICAL INTAKE SHALL MAINTAIN 10 LINEAR FEET SEPARATION BETWEEN ANY SOURCE OF EXHAUST. CONTRACTOR IS RESPONSIBLE TO ADJUST DUCT LENGTH AS NEEDED.

KEYED NOTES:

- CONTRACTOR TO RUN CONDENSATE DRAIN TO MOP SINK IN JANITOR CLOSET.
- COORDINATE FINAL LOCATION OF EQUIPMENT WITH STRUCTURAL DRAWINGS. UNIT MUST BE AT LEAST 3' AWAY FROM EDGE OF ROOF.
- REFER TO M200 FOR CONTINUATION.

HMB3
ENGINEERING
CONSULTANTS

2902 NORTH FLORES
SAN ANTONIO, TEXAS 78212
210.393.1840 PHONE
SAN ANTONIO - RGJ
TYPE FIRM REGISTRATION NO. 13241



ARCHITECT	Above Ground Design, PLLC 200 Grooms Road Cocke, Texas 78108
MEPT	HMB3 Engineering 2802 N Flores Street San Antonio, Texas 78212
STRUCTURAL	Hoffer Structural Solutions 948 Preston Road San Antonio, Texas 78256
COPYRIGHT 2023	

BAR HOUSE, LLC
NEW BAR HOUSE

100 NORTH ALAMO STREET
SAN ANTONIO, TEXAS 78203
DESIGN DEVELOPMENT



KEY PLAN

PLAN
NORTH

TRUE
NORTH



CLIENT: BAR HOUSE, LLC		
PROJECT NUMBER: 23016		
DATE: MARCH 10, 2023		
REVISIONS		
No.	Description	Date
2	HDRC Comments	8/3/2023

DESIGN DEVELOPMENT

THIRD FLOOR
MECHANICAL PLAN



ELECTRIC UNIT HEATER SCHEDULE	
MARK	EL#-1
SERIES	RISER
KW	3.3/2.5
VOLTS/PHASE/HERTZ	240-208/1/60
AMPS.	13.7/12.0
MANUFACTURER	MARKEL 5100
MODEL NO.	HF285103
WEIGHT	25
NOTES	1

NOTE:

1. SHALL INCLUDE WALL MOUNTED THERMOSTAT, FUSED CONTROL CIRCUIT, MANUAL RESET HIGH LIMIT, "FAN ONLY" SWITCH AND WALL BRACKET.

MECHANICAL FAN SCHEDULE											
TAG	FLOW RATE	STATIC PRESSURE/MOTOR DATA			ELECTRICAL DATA		MAXIMUM LOUNESS	BASIS OF DESIGN			NOTES
		EXTERNAL	INTERNAL	LOAD/ SPEED	HP	MCFA		MOCP	VOLTAJE	SONES	
EF-1	475	0.15	-	1400	0.4	15	120	3.5	L COOK	GN-422	2.3-4
EF-2	75	0.15	-	750	0.4	15	120	0.9	L COOK	GC-128	1.3-4

NOTES:

- INTERCONNECT WITH LIGHTS IN ROOM. REFER TO ELECTRICAL LIGHTING PLAN
- PROVIDE FACTORY MOUNTED AND INSTALLED DISCONNECT
- PROVIDE ACCESS DOOR TO SERVICE UNIT F IN HARD CEILING
- INTERCONNECT WITH INTEGRATED AUXILIARY RELAY OF RTU-2. PROVIDE SUPPLEMENTAL AUXILIARY RELAY AS REQUIRED



820 NORTH ALAMO STREET
SAN ANTONIO TEXAS 78215

DESIGN DEVELOPMENT



DESIGN DEVELOPMENT

M400



GENERAL NOTES LIGHTING SHEETS:
(APPLIES TO ALL LIGHTING SHEETS)

- A. WHEN LOCATING SYSTEMS NEXT TO DOORS, LOCATE 8 INCHES OFF DOOR JAMB TO CENTER OF DEVICE. WHEN MULTIPLE DEVICES ARE TOGETHER, STACK BUT NO MORE THAN 72 INCHES AFF. COORDINATE SWITCH LOCATIONS IN ROOMS WITH ARCHITECT AND OTHER DEVICES (THERMOSTATS, FIRE ALARM, AND CALL BUTTONS).
- B. MINIMUM CIRCUIT SIZE IS 2 #12 AND 1 #12 GROUND IN 3/4" CONDUIT. MAXIMUM FIXTURE WHIP LENGTH FROM ANY J-BOX 6 FEET. LIGHTING CIRCUITS JOINTS SHALL BE MADE UP IN OVERHEAD J-BOXES SECURED TO STRUCTURE WITH LIGHTING WHIPS FROM THE J-BOXES. FIXTURES DESIGNED TO BE QUICK-CLIPPED TOGETHER SHALL BE CONNECTED AS PER MANUFACTURER.
- C. COORDINATE LIGHT LOCATIONS WITH OTHER CEILING ITEMS OR JOIST ITEMS PRIOR TO INSTALLATION. LIGHT LOCATIONS TAKE PRECEDENCE OVER AIR DEVICES.
- D. PROVIDE SECONDARY SUPPORT WIRES FROM ALL FOUR (4) CORNERS OF THE LAY-IN FIXTURES TO THE STRUCTURE ABOVE. DO NOT SUPPORT FIXTURES FROM CEILING GRID WIRE SUPPORTS, PIPING, CONDUIT, SIDE WALLS, OR MECHANICAL EQUIPMENT. CEILING SPECIFICATIONS DO NOT SUPERCEDE THIS REQUIREMENT.
- E. PROVIDE INTEGRAL BATTERY BACK-UP W/INTEGRAL BATTERY & TEST SWITCH FOR ALL FIXTURES WITH AN "E" SUFFIX.
- F. FIRESTOP ALL CONDUIT PENETRATIONS IN RATED WALLS. SEE ARCHITECTURAL FOR WALL RATINGS. THE CONTRACTOR SHALL BE RESPONSIBLE FOR DAMAGE TO SHEET ROCK AND REPAIR. PROVIDE FIRE RATED SLEEVES IN ALL FLOOR PENETRATIONS.
- G. CONTRACTOR TO VERIFY FIXTURE VOLTAGE PRIOR TO INSTALLING ANY RELOCATED FIXTURE. COORDINATE WITH ROP FOR FIXTURE LOCATIONS.
- H. ALL ROOMS AND HALLWAYS SHALL HAVE LOCAL SWITCHES PER NEC WHETHER SHOWN ON PLAN OR NOT. ALL SPACES WITH MORE THAN ONE FIXTURE SHALL HAVE SWITCHING CAPABLE OF REDUCING LIGHTING OUTPUT BY AT LEAST 50% THROUGH DIMMING OR DUAL SWITCHING. ALL HALLWAYS GREATER THAN 30'-0" IN LENGTH SHALL HAVE AT LEAST (2) 3-WAY SWITCHES.
- I. PROVIDE AN EXTRA UNSWITCHED HOT LEG FOR EXITS LIGHTS, NIGHTLIGHTS AND EMERGENCY LIGHTS. PROVIDE THE EXTRA UNSWITCHED HOT LEG FROM THE LINE SIDE OF THE CONTACTOR TO EACH EXIT AND EMERGENCY LIGHT AS INDICATED ON DRAWINGS. DO NOT ROUTE A SWITCHED (EITHER BY SWITCH OR CONTACTOR) HOT LEG TO EMERGENCY LIGHTS AND BALLASTS AS THIS WILL NOT ALLOW FOR PROPER OPERATION OF THE EMERGENCY/EXIT FIXTURE.
- J. UNLESS OTHER METHODS OF LIGHTING CONTROL ARE SHOWN, PROVIDE A MINIMUM OF (2) CONTACTORS ADJACENT TO NEW TENANT PANEL. (1) 8 POLE CONTACTOR SHALL BE PROVIDED WITH PROGRAMMABLE ASTRONOMICAL TIME CLOCK WITH HOLIDAY SCHEDULE FOR "ON/OFF" CONTROL OF ALL INTERIOR LIGHTS COMPLETE WITH (3) 20 MINUTE MANUAL OVERRIDE SWITCHES. COORDINATE OVERRIDE SWITCH LOCATIONS WITH OWNER PRIOR TO INSTALLATION. THE SECOND CONTACTOR SHALL ALSO BE MOUNTED ADJACENT TO THE TENANT PANEL AND SHALL BE A POLE FOR CONTROL OF EXTERIOR LIGHTING AS NOTED. PROVIDE 120V FROM TENANT PANEL SPARE 20A/1P C.B. SPECIFICATION OF A LIGHTING CONTROL RELAY PANEL SHALL SUPERSEDE ALL OTHER REQUIREMENTS OF NOTE J.

GENERAL NOTES POWER SHEETS:
(APPLIES TO ALL POWER SHEETS)

- A. SEE ALL OTHER PLANS FOR ADDITIONAL DEVICES. SOME POWER CIRCUITING MAY BE ON OTHER PLANS. COORDINATE THE LOCATIONS OF DATA/CATV JACKS WITH THE RECEPTACLES. MOUNT ADJACENT TO EACH OTHER.
- B. WHEN LOCATING SYSTEMS NEXT TO DOORS, LOCATE 8 INCHES OFF DOOR JAMB TO CENTER OF DEVICE. WHEN MULTIPLE DEVICES ARE TOGETHER, STACK BUT NO MORE THAN 72 INCHES AFF.
- C. MINIMUM CIRCUIT SIZE IS 2 #12 AND 1 #12 GROUND IN 3/4" CONDUIT FOR INDIVIDUAL CIRCUITS. 3/4" CONDUIT FOR MULTIPLE CIRCUITS. ALL CONDUCTORS SHALL BE 75 DEGREE (MINIMUM) COPPER THHN. COLOR CODED AS PER NEC AND LOCAL AMENDMENTS WITH SIZE, TEMPERATURE, AND VOLTAGE PERMANENTLY PRINTED ON THE JACKET. ALL JOINTS SHALL BE MADE UP USING SELF LOCKING, TWIST-ON, COLOR CODED, SQUARE WIRE SPRING GRAB, LONG SKIRT, WIRE CONNECTORS WITH SWEPT WINGS.
- D. PROVIDE #10 AWG MIN NEUTRAL FOR ALL MULTIWIRE BRANCH CIRCUITS AND PROVIDE HANDLE TIES FOR CIRCUIT BREAKERS AS REQUIRED BY NEC 210.4
- E. CONDUCTOR SIZES INDICATED ASSUME NO MORE THAN (3) SINGLE POLE BRANCH CIRCUITS IN EACH CONDUIT. IT SHALL BE THE CONTRACTOR'S RESPONSIBILITY TO DE-RATE CONDUCTORS PER NEC TABLE 310.15(B)(2)(a) FOR CONDUITS WITH MORE THAN (3) CURRENT "CARRYING CONDUCTORS". THE NEUTRAL CONDUCTOR SHALL BE CONSIDERED "CURRENT CARRYING" FOR ALL BRANCH CIRCUITS SERVING MORE THAN (4) COMPUTERS.
- F. REFER TO VOLTAGE DROP FEEDER SCHEDULE FOR BRANCH CIRCUITS EXCEEDING 100' IN LENGTH.
- G. COORDINATE RECEPTACLE LOCATIONS WITH MILLWORK AND COUNTERS. DO NOT LOCATE RECEPTACLES BEHIND DRAWERS OR HIDDEN IN MILLWORK UNLESS SPECIFICALLY DIRECTED BY OWNER/ARCHITECT. REVIEW ARCHITECTURAL ELEVATIONS PRIOR TO RECEPTACLE ROUGH-INS. SEE ARCH. ELEVATIONS IN BREAKROOMS FOR APPLIANCES AND RECEPTACLE MOUNTING LOCATIONS.
- H. MOUNT RECEPTACLES 18" AFF. 6" ABOVE BACKSPLASH AT COUNTERS, 48" IN TOILET ROOMS, AT EQUIPMENT ROUGH-IN LOCATIONS FOR APPLIANCES, AND 96" FOR TV'S. PROVIDE GFI RECEPTACLES AT/LOCATED ALL SINKS. ROOFTOP RECEPTACLES, KITCHEN RECEPTACLES, BATHROOM/TOILET ROOMS, EXTERIOR RECEPTACLES, AND UNDERCOUNTER EQUIPMENT. ALSO, ALL RECEPTACLES SERVING DRINKING FOUNTAINS SHALL HAVE GFI.
- M. ALL RECEPTACLES NOT DEDICATED TO EQUIPMENT WITHIN 6' OF SINK, WOP SINK, DRINKING FOUNTAIN OR OTHER USER WATER SOURCE SHALL BE GFI PROTECTED.
- N. ALL RECEPTACLES IN KITCHENS SHALL BE GFI PROTECTED.
- O. ALL EQUIPMENT SHALL HAVE A LOCAL DISCONNECTING MEANS, EITHER CORDED PLUG AND RECEPTACLE OR SWITCHED DISCONNECT. VERIFY FROM EQUIPMENT SUBMITTED OR RELOCATED IF DIRECT CONNECT OR RECEPTACLE. IF DIRECT CONNECT, PROVIDE SWITCH AS PER NEC OTHERWISE, PROVIDE RECEPTACLE, CORD PLUG AS REQUIRED BY EQUIPMENT SUBMITTAL.
- P. FIRESTOP ALL CONDUIT PENETRATIONS IN RATED WALLS. SEE ARCHITECTURAL FOR WALL RATINGS. CONTRACTOR SHALL BE RESPONSIBLE FOR DAMAGE TO SHEET ROCK AND REPAIR.
- Q. PROVIDE FIRE RATED SLEEVES IN ALL FLOOR PENETRATIONS.
- R. PROVIDE A DUCT-MOUNTED SMOKE DETECTOR ON THE RETURN SIDE OF ALL RTU'S, AHU'S, AND FOU'S RATED AT 2000 CFM SUPPLY AND OVER. PROVIDE A DUCT-MOUNTED SMOKE DETECTOR ON THE RETURN AND SUPPLY SIDE OF ALL MECHANICAL EQUIPMENT RATED AT 10,000 CFM AND OVER. CONNECT FOR AUTOMATIC SHUTDOWN OF UNIT AND ALARM TO FACP (WHERE APPLICABLE). REFER TO MECHANICAL EQUIPMENT SCHEDULES FOR CFM RATINGS.
- S. PROVIDE A MINIMUM OF (10) SPARE 20A/1P BREAKERS AND (3) 20A/1P SPACES IN EACH PANEL WHETHER SHOWN ON SCHEDULE OR NOT.

GENERAL MECHANICAL CONNECTION NOTES:
(APPLIES TO ALL MECHANICAL POWER SHEETS)

- A. REFER TO MECHANICAL EQUIPMENT ELECTRICAL CONNECTION SCHEDULE FOR CIRCUITING, SIZE OF CONDUCTORS, DISCONNECTS AND ALL CONNECTION REQUIREMENTS.
- B. COORDINATE EQUIPMENT LOCATION WITH MECHANICAL PLAN.
- C. ALL EQUIPMENT SHALL HAVE A LOCAL DISCONNECTING MEANS, EITHER CORDED PLUG AND RECEPTACLE OR SWITCHED DISCONNECT. VERIFY FROM EQUIPMENT SUBMITTED OR RELOCATED IF DIRECT CONNECT OR RECEPTACLE. IF DIRECT CONNECT, PROVIDE SWITCH AS PER NEC OTHERWISE, PROVIDE RECEPTACLE, CORD PLUG AS REQUIRED BY EQUIPMENT SUBMITTAL.
- D. PROVIDE DISCONNECTS (FUSED AND NON-FUSED) FULL RATING OF EQUIPMENT PROTECTED. COORDINATE SIZES WITH EQUIPMENT SUBMITTED. PROVIDE FUSED DISCONNECTS FOR ALL MULTIPLE PIECES OF EQUIPMENT ON THE SAME CIRCUIT. DISCONNECTS AND FUSES SHALL BE EQUAL TO OR GREATER THAN THE FEEDER/BREAKER SIZE. SIZE LOAD SIDE OF DISCONNECTS FOR EQUIPMENT AS LISTED.
- E. MOUNT DISCONNECTS ON UNISTRUT SUPPORTS. PROVIDE UNISTRUT RACKS FOR DISCONNECTS ON ROOF AS DETAILED. DISCONNECTS LOCATED ABOVE CEILING SHALL BE SUPPORTED FROM STRUCTURE.
- F. PROVIDE A WEATHERPROOF, GFCI RECEPTACLE ON UNISTRUT RACKS FOR ROOF MOUNTED EQUIPMENT SO THAT EACH UNIT IS NO MORE THAN 25' FROM MECHANICAL EQUIPMENT. CIRCUIT ROOF MOUNTED RECEPTACLES FROM A 20A/1P SPARE CIRCUIT BREAKER IN THE NEAREST 120/208V PANEL BELOW. CIRCUIT NO MORE THAN (5) RECEPTACLES PER 20A CIRCUIT.
- G. ON CIRCUITS GREATER THAN 20A, FEEDING MULTIPLE PIECES OF EQUIPMENT, PROVIDE FUSED DISCONNECTS (SIZED FOR EQUIPMENT PROTECTING). PROVIDE FULL SIZED FEEDERS FROM BRANCH CIRCUIT BREAKER TO EQUIPMENT DISCONNECT WITH CONDUCTORS QUANTITIES AS INDICATED ON MECHANICAL EQUIPMENT ELECTRICAL SCHEDULE.
- H. PROVIDE SEPARATE NEUTRAL FOR MOTORS FOR ALL FAN POWER BOXES.
- I. PROVIDE ENT UNDER ROOF. SECURE TO STRUCTURE WITH BEAM CLAMPS (SINGLE) OR UNISTRUT (MULTIPLE).
- J. PROVIDE IMC ON ROOF FROM ROOF HOODS TO DISCONNECTS.
- K. PROVIDE RIGID STEEL CONDUIT ON ROOF FROM ROOF HOODS TO DISCONNECTS.
- L. PENETRATE ROOFS AS PER ROOFING GUIDELINES AND GANG CONDUIT TOGETHER. SUPPORT ROOFTOP CONDUIT WITH NEOPRENE BLOCKS WITH INTEGRAL UNISTRUT. SECURE CONDUIT TO BLOCKS ON ROOF.
- M. PROVIDE SEAL/TIE WITH WP FITTINGS TO MECHANICAL EQUIPMENT, MAX DISTANCE 48". DO NOT USE CONDUITS.
- N. PROVIDE INDIVIDUAL DISCONNECTS FOR ALL SMOKE FIRE DAMPERS AND VAV'S. NO EXCEPTIONS.
- O. FIRESTOP ALL CONDUIT PENETRATIONS IN RATED WALLS. SEE ARCHITECTURAL FOR WALL RATINGS. CONTRACTOR SHALL BE RESPONSIBLE FOR DAMAGE TO SHEET ROCK AND REPAIR.
- P. PROVIDE NEMA 3R DISCONNECTS FOR ALL EXTERIOR LOCATIONS AND NEMA 1 DISCONNECTS FOR ALL INTERIOR, DRY LOCATIONS.
- Q. POWER AND DATA REQUIREMENTS FOR HVAC CONTROLLERS ARE SHOWN ON POWER SHEETS.
- R. ALL EQUIPMENT CONNECTION POINTS ARE DIAGRAMMATIC IN NATURE. ELECTRICAL CONTRACTOR SHALL COORDINATE WITH EQUIPMENT INSTALLER FOR EXACT POINT OF CONNECTION. EXTEND FEEDERS IN CONDUIT AS REQUIRED.



ARCHITECT	Above Ground Design, PLLC 200 Grooms Road Cibola, Texas 78108
MEET	HMB Engineering 2902 N Flores Street San Antonio, Texas 78212
STRUCTURAL	Hoffer Structural Solutions 845 Foster Road San Antonio, Texas 78258
COPYRIGHT 2023	

BAR HOUSE, LLC
NEW BAR HOUSE

SAN ANTONIO TEXAS 78205

DESIGN DEVELOPMENT



KEY PLAN

PLAN NORTH
TRUE NORTH



CLIENT BAR HOUSE, LLC		
PROJECT NUMBER 23016		
DATE MARCH 10, 2023		
REVISIONS		
No.	Description	Date

DESIGN DEVELOPMENT

ELECTRICAL
GENERAL NOTES










E001



2902 NORTH FLORES
SAN ANTONIO, TEXAS 78212
210.393.1640 PHONE
SAN ANTONIO - RGV
TYPE 19M REGISTRATION NO. 13561

CHECKED BY: Checker

DRAWN BY: Author

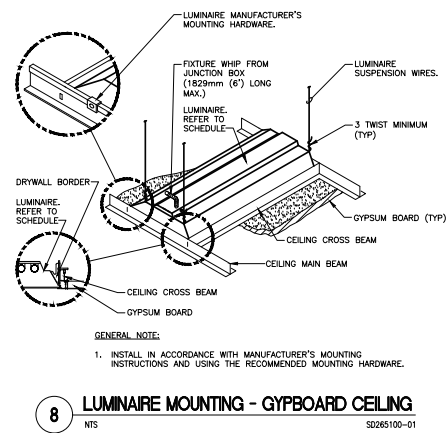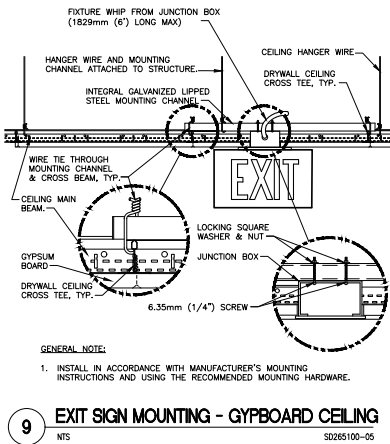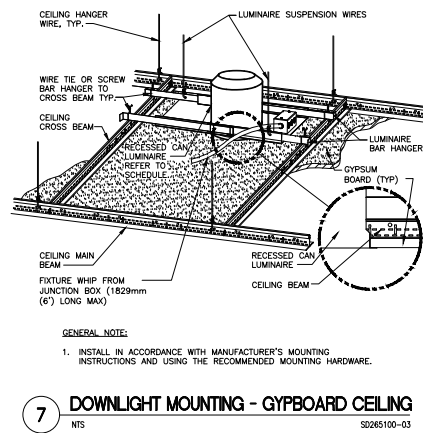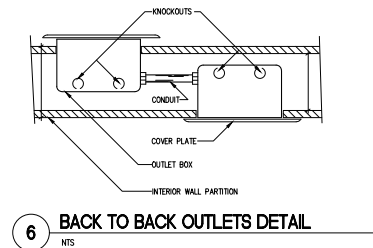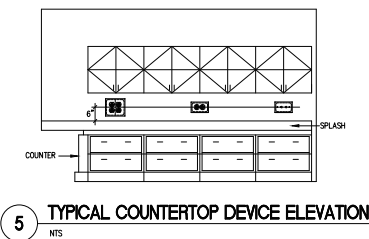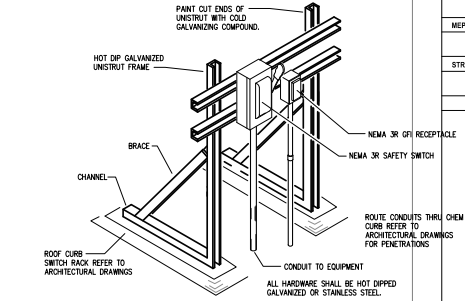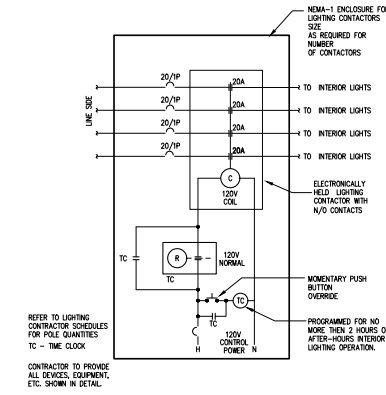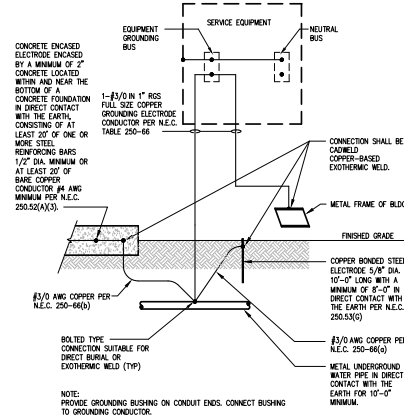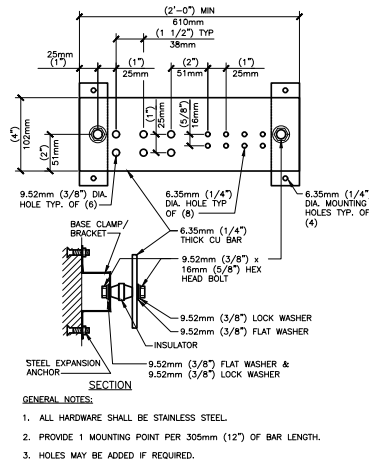

HMB ENGINEERING CONSULTANTS

2802 NORTH RICHES
SAN ANTONIO, TEXAS 78212
210.393.1840 PHONE
SAN ANTONIO - RGW
TYPE TEAM REGISTRATION NO. 13361

ARCHITECT Above Ground Design, PLLC
200 Grooms Road
Cibola, Texas 78108

MEPT HMB Engineering
2802 N. Flores Street
San Antonio, Texas 78212

STRUCTURAL Hoffer Structural Solutions
345 Foster Road
San Antonio, Texas 78258

COPYRIGHT 2023


BAR HOUSE, LLC
NEW BAR HOUSE

SAN ANTONIO TEXAS 78205


DESIGN DEVELOPMENT

ELECTRICAL DETAILS


E002

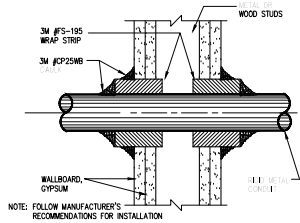


1 AND 2 HR. GYPSUM/WALLBOARD PENETRATION DETAIL
NTS

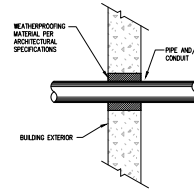


PIPE AND/OR CONDUIT PENETRATION
NTS

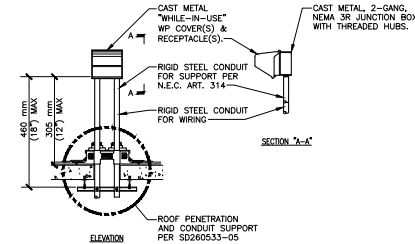


RECEPTACLE ROOF MOUNTING DETAIL
NTS SD260533-01

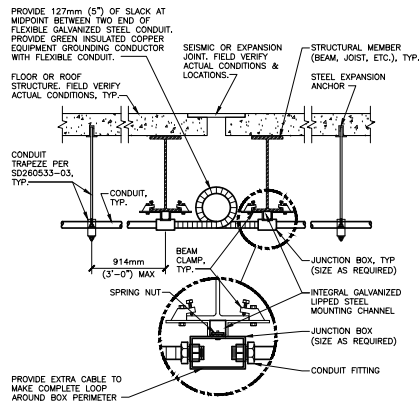

CONDUIT EXPANSION JOINT CROSSING DETAIL-FLEXIBLE CONDUIT
NTS SD260533-01

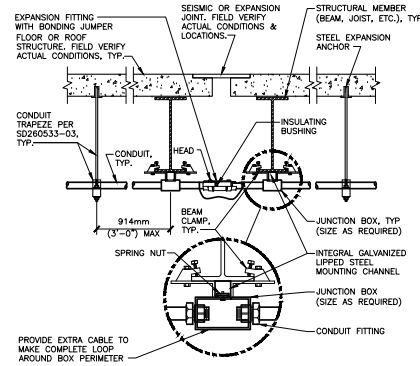


CONDUIT EXPANSION JOINT CROSSING DETAIL-EXPANSION FITTING
NTS SD260533-02

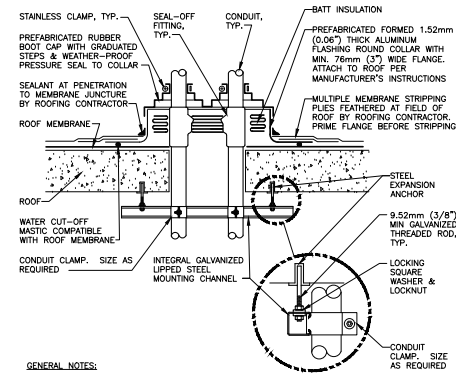


CONDUIT ROOF PENETRATION DETAIL
NTS SD260533-05

CONDUIT EXPANSION JOINT CROSSING DETAIL-FLEXIBLE CONDUIT
NTS SD260533-01

CONDUIT EXPANSION JOINT CROSSING DETAIL-EXPANSION FITTING
NTS SD260533-02

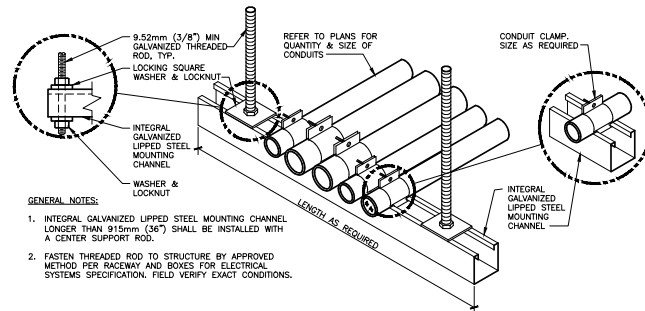

CONDUIT TRAPEZE MOUNTING DETAIL
NTS SD260533-03

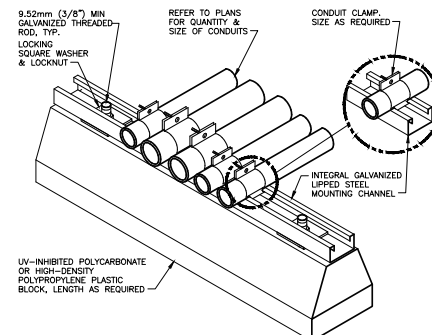

ROOF CONDUIT SUPPORT DETAIL
NTS SD260533-04



ARCHITECT	Above Ground Design, PLLC 200 Grooms Road Cibola, Texas 78108
MEPT	HMB Engineering 2902 N Flores Street San Antonio, Texas 78212
STRUCTURAL	Hoffer Structural Solutions 345 Foster Road San Antonio, Texas 78258
COPYRIGHT 2023	

BAR HOUSE, LLC
NEW BAR HOUSE

SAN ANTONIO TEXAS 78205
DESIGN DEVELOPMENT



KEY PLAN

PLAN NORTH
TRUE NORTH



CLIENT		
BAR HOUSE, LLC		
PROJECT NUMBER		
23016		
DATE	MARCH 10, 2023	
REVISIONS		
No.	Description	Date
DESIGN DEVELOPMENT		

DESIGN DEVELOPMENT

ELECTRICAL
DETAILS

E003

HMB
ENGINEERING
CONSULTANTS

2902 NORTH FLORES
SAN ANTONIO, TEXAS 78212
210.393.1840 PHONE
SAN ANTONIO - RGW
TYPED BY REGISTRATION NO. 13561

CHECKED BY: Checker

DRAWN BY: Author



ARCHITECT Above Ground Design, PLLC
200 Grooms Road
Cibola, Texas 78108
MEPT HMB Engineering
2902 N Flores Street
San Antonio, Texas 78212
STRUCTURAL Hoffer Structural Solutions
3405 Preston Road
San Antonio, Texas 78258
COPYRIGHT 2023

BAR HOUSE, LLC
NEW BAR HOUSE
DESIGN DEVELOPMENT




KEY PLAN
PLAN NORTH
TRUE NORTH



CLIENT
BAR HOUSE, LLC
PROJECT NUMBER
22016
DATE MARCH 10, 2023
REVISIONS
No. Description Date
DESIGN DEVELOPMENT

FIRST FLOOR
LIGHTING PLAN

E100

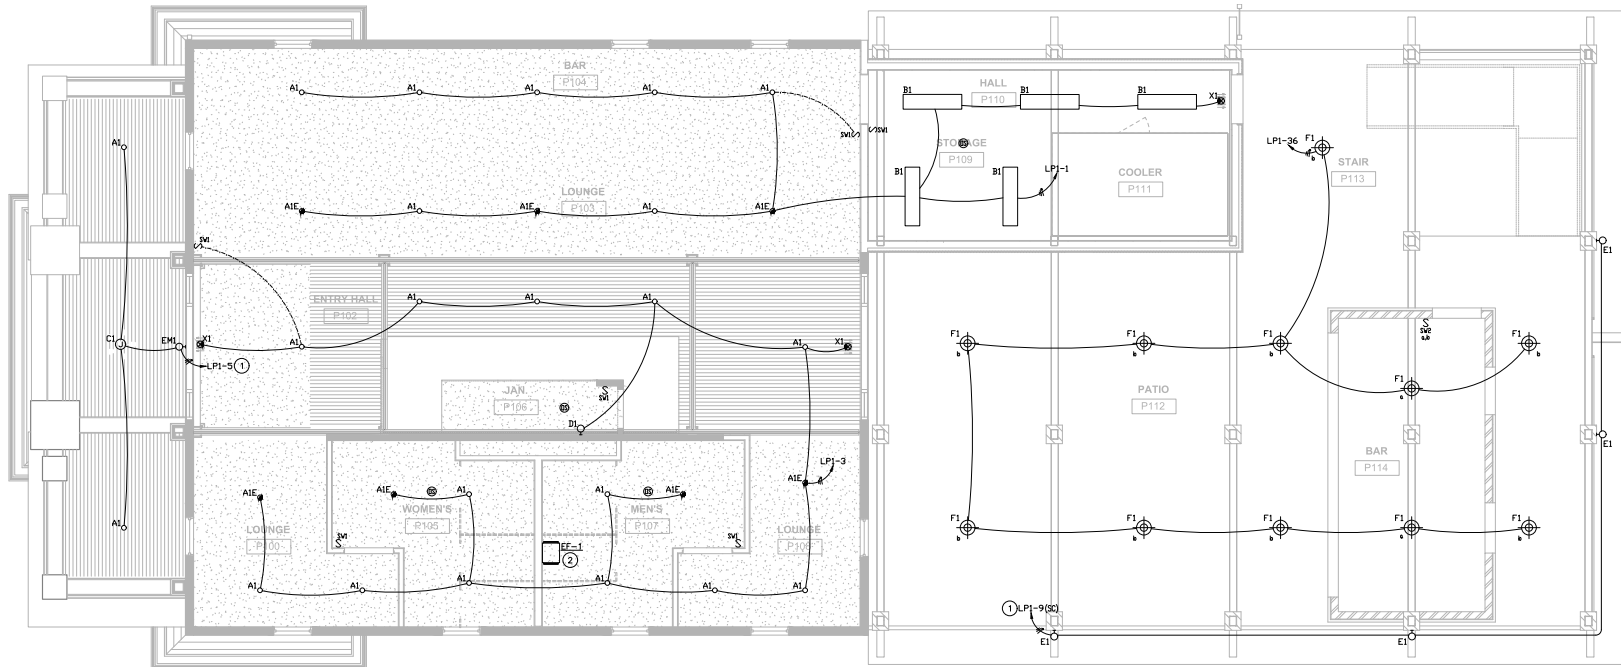

1 FIRST FLOOR LIGHTING PLAN
1/4" = 1'-0"

Mark	Manuf.	Model	Description
SW1	nLight	rPOOM	SINGLE CHANNEL ON/OFF ONLY WALL SWITCH. VERIFY FINISH WITH ARCHITECT.
SW2	nLight	rPOOM 2P	TWO CHANNEL ON/OFF ONLY WALL SWITCH. VERIFY FINISH WITH ARCHITECT.
OS	nLight	rCM 9	SMALL MOTION PIR OCCUPANCY SENSOR

PROVIDE ALL LOW VOLTAGE WIRING, ACCESSORIES, AND HARDWARE FOR A COMPLETE AND OPERABLE SYSTEM.
BASIS OF DESIGN: LIGHT CONTROLS
ACCEPTABLE EQUIVLS: SENSOR SWITCH, WATTSTOPPER, HUBBLE, EATON

KEYED NOTES:

- ROUTE CIRCUIT THROUGH LIGHTING CONTROL PANEL FOR PHOTOCELL ON/TIMELOCK OFF OPERATION.
- PROVIDE FACTORY MOUNTED AND INSTALLED DISCONNECT. INTERCONNECT WITH INTEGRATED AUXILIARY RELAY OF RTU-2.

HMB
ENGINEERING
CONSULTANTS

2902 NORTH FLORES
SAN ANTONIO, TEXAS 78212
210.393.1640 PHONE
SAN ANTONIO - RGW
18PE T&E REGISTRATION NO. 13361

CHECKED BY: Checker

DRAWN BY: Author



ARCHITECT	Above Ground Design, PLLC 200 Grooms Road Cibola, Texas 78108
MEPT	HMB Engineering 2902 N Flores Street San Antonio, Texas 78212
STRUCTURAL	Hoffer Structural Solutions 845 Preston Road San Antonio, Texas 78209
COPYRIGHT 2023	

BAR HOUSE, LLC
NEW BAR HOUSE

SAN ANTONIO, TEXAS 78212

DESIGN DEVELOPMENT



KEY PLAN

PLAN NORTH
TRUE NORTH




CLIENT		
BAR HOUSE, LLC		
PROJECT NUMBER		
23016		
DATE	MARCH 10, 2023	
REVISIONS		
No.	Description	Date
DESIGN DEVELOPMENT		

DESIGN DEVELOPMENT

SECOND FLOOR
LIGHTING PLAN

E101

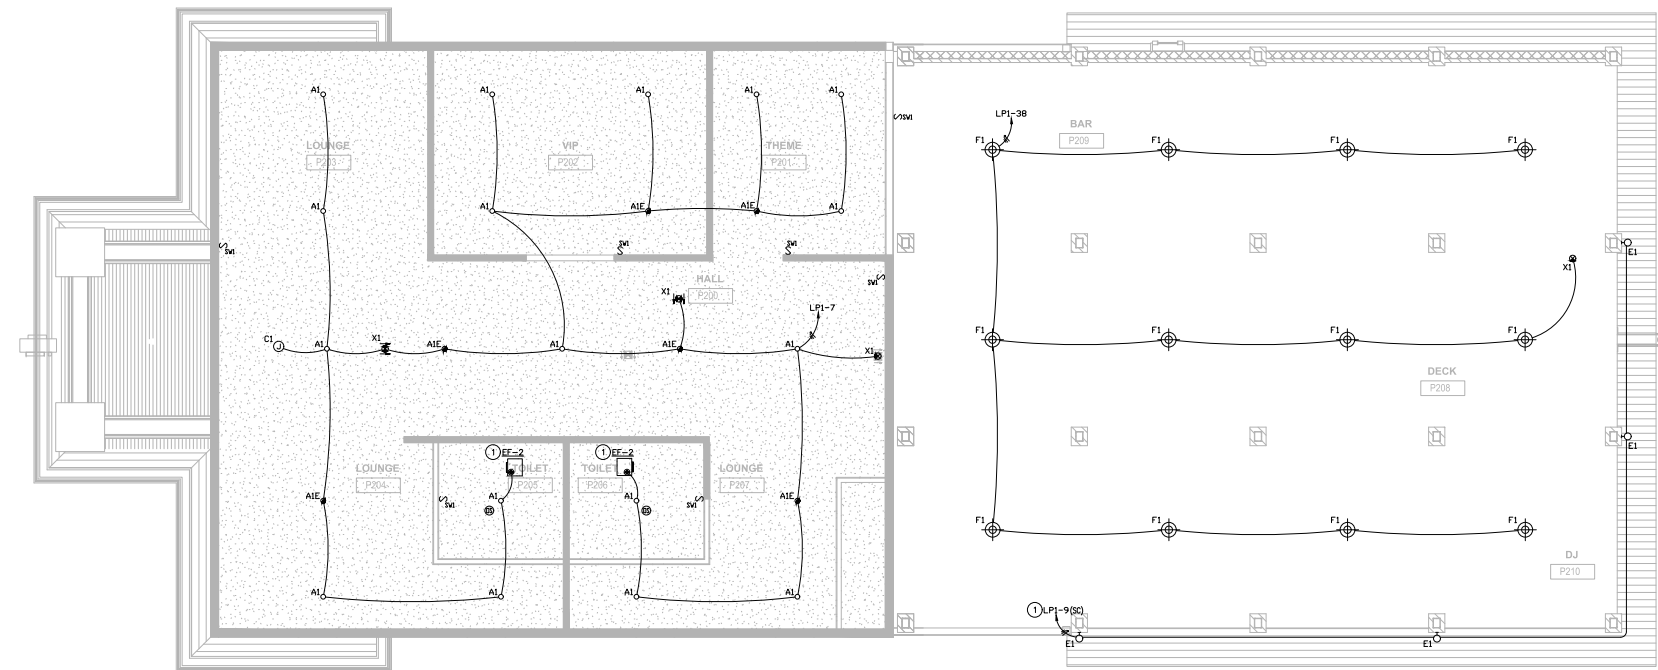

1 SECOND FLOOR LIGHTING PLAN
1/4" = 1'-0"

Low Voltage Lighting Control Device Schedule			
Mark	Manuf.	Model	Description
SW1	nLight	nPOOM	SINGLE CHANNEL ON/OFF ONLY WALL SWITCH. VERIFY FINISH WITH ARCHITECT.
SW2	nLight	nPOOM 2P	TWO CHANNEL ON/OFF ONLY WALL SWITCH. VERIFY FINISH WITH ARCHITECT.
OS	nLight	nCM 9	SMALL MOTION PIR OCCUPANCY SENSOR

PROVIDE ALL LOW VOLTAGE WIRING, ACCESSORIES, AND HARDWARE FOR A COMPLETE AND OPERABLE SYSTEM.
BASIS OF DESIGN: nLIGHT CONTROLS
ACCEPTABLE EQUALS: SENSOR SWITCH, WATTSTOPPER, HUBBLE, EATON

- KEYED NOTES:
- ROUTE CIRCUIT THROUGH LIGHTING CONTROL PANEL FOR PHOTOCELL ON/TIMELOCK OFF OPERATION.
 - PROVIDE FACTORY MOUNTED AND INSTALLED DISCONNECT.

HMB
ENGINEERING
CONSULTANTS


2902 NORTH FLORES
SAN ANTONIO, TEXAS 78212
210.393.1640 PHONE
SAN ANTONIO - RG
TYPE 19M REGISTRATION NO. 13361

CHECKED BY: Checker

DRAWN BY: Author

CHECKED BY: Checker

DRAWN BY: Author

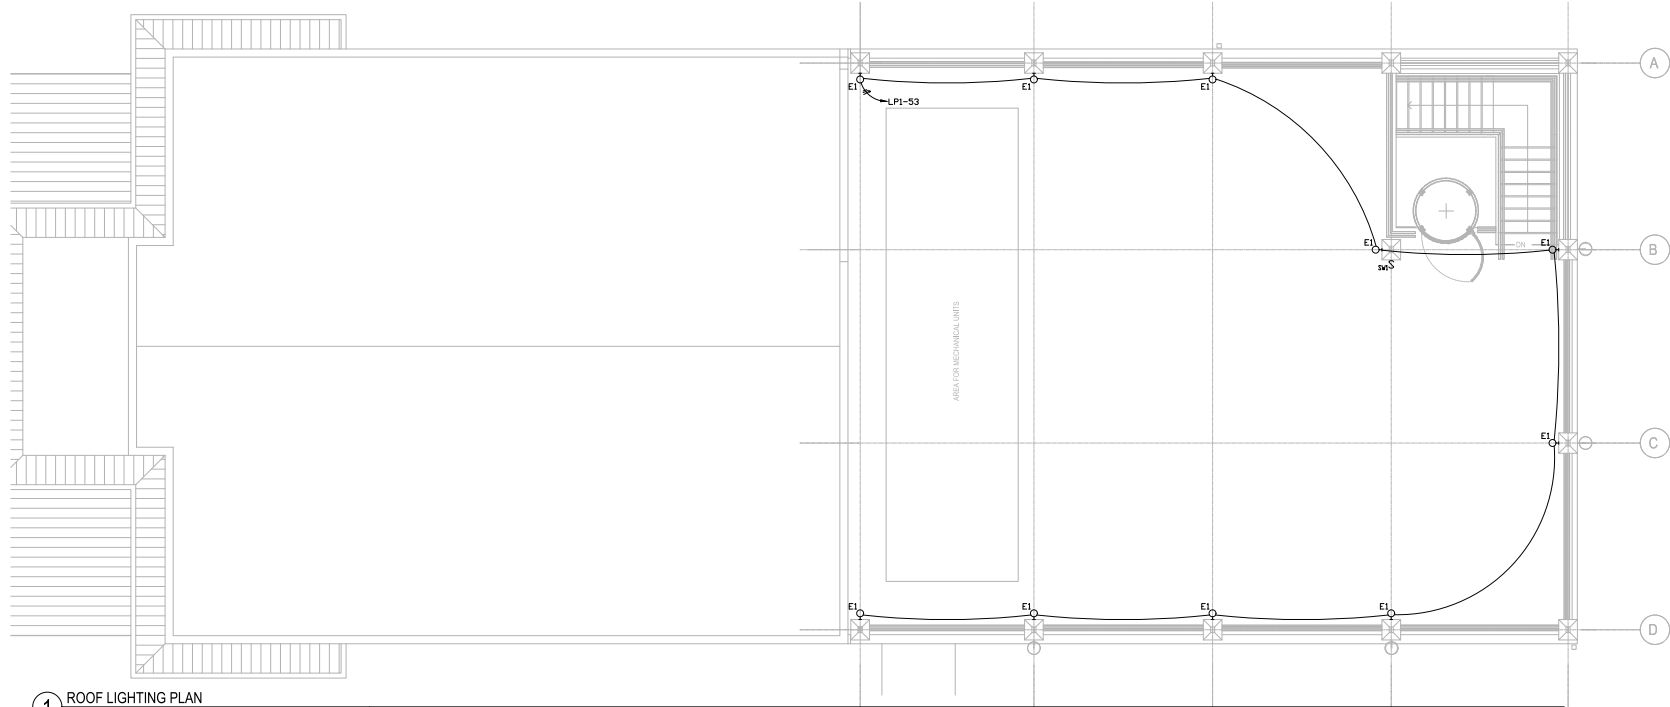

1 ROOF LIGHTING PLAN
1/4" = 1'-0"

Low Voltage Lighting Control Device Schedule			
Mark	Manuf.	Model	Description
SW1	nLight	nPOOM	SINGLE CHANNEL ON/OFF ONLY WALL SWITCH. VERIFY FINISH WITH ARCHITECT.
SW2	nLight	nPOOM 2P	TWO CHANNEL ON/OFF ONLY WALL SWITCH. VERIFY FINISH WITH ARCHITECT.
OS	nLight	nCM 9	SMALL MOTION PIR OCCUPANCY SENSOR

PROVIDE ALL LOW VOLTAGE WIRING, ACCESSORIES, AND HARDWARE FOR A COMPLETE AND OPERABLE SYSTEM.
BASIS OF DESIGN: nLIGHT CONTROLS
ACCEPTABLE EQUALS: SENSOR SWITCH, WATTSTOPPER, HUBBLE, EATON

HMB
ENGINEERING
CONSULTANTS

2902 NORTH FLORES
SAN ANTONIO, TEXAS 78212
210.393.1640 PHONE
SAN ANTONIO - RGW
10PE T&E REGISTRATION NO. 13361



ARCHITECT	Above Ground Design, PLLC 200 Grooms Road Cibola, Texas 78108
MEPT	HMB Engineering 2902 N Flores Street San Antonio, Texas 78212
STRUCTURAL	Hoffler Structural Solutions 3405 Proctor Road San Antonio, Texas 78258
COPYRIGHT 2023	

BAR HOUSE, LLC
NEW BAR HOUSE

SAN ANTONIO, TEXAS 78212
DESIGN DEVELOPMENT



KEY PLAN

PLAN NORTH
TRUE NORTH




CLIENT BAR HOUSE, LLC		
PROJECT NUMBER 22016		
DATE MARCH 10, 2023		
REVISIONS		
No.	Description	Date
2	HDR: COMMENTS	08/03/23
DESIGN DEVELOPMENT		

ROOF LIGHTING PLAN

E102

CHECKED BY: Checker

DRAWN BY: Author

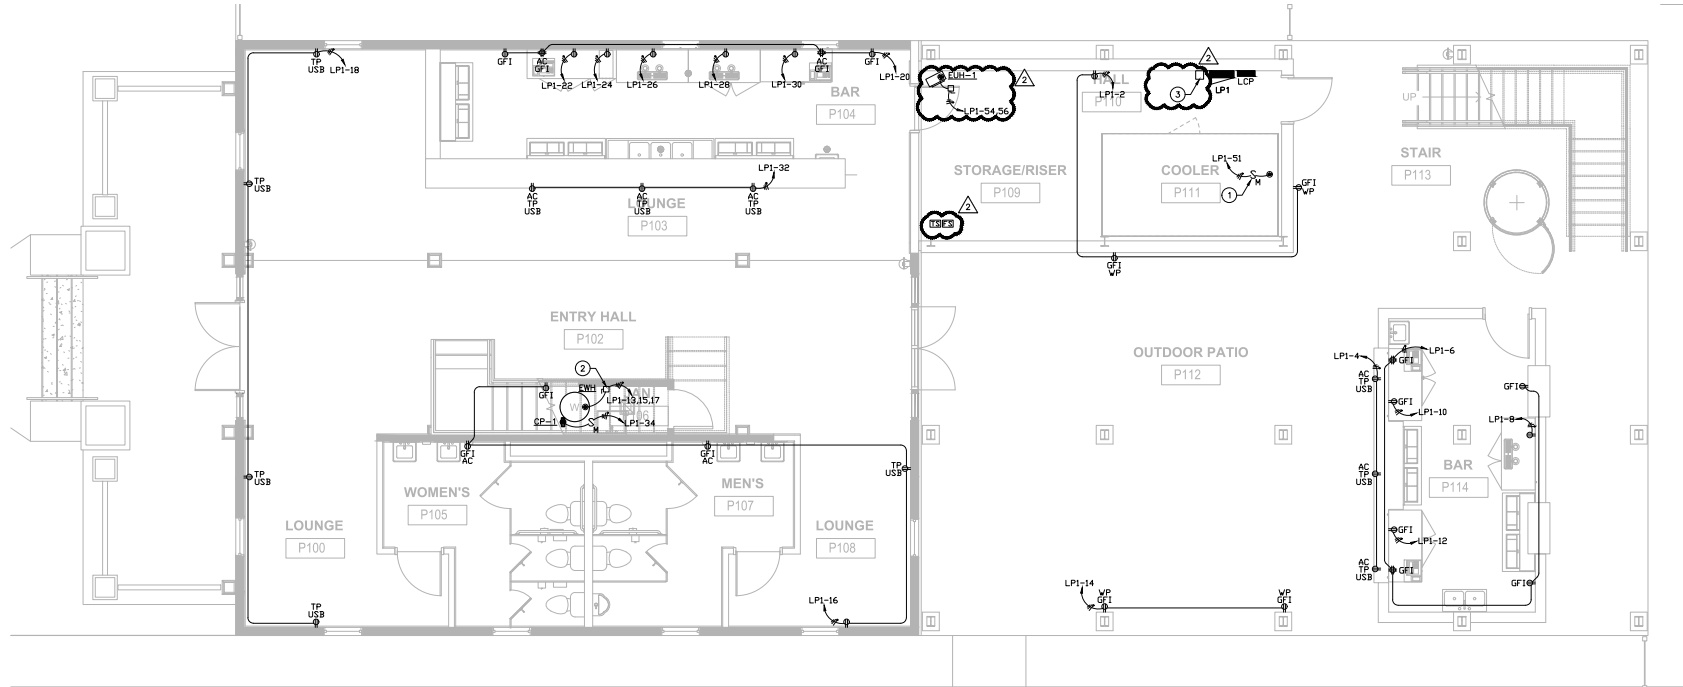

1 FIRST FLOOR POWER PLAN
1/4" = 1'-0"

KEYED NOTES:

1. PROVIDE CONNECTION AND DISCONNECTING MEANS TO WALK-IN COOLER EVAPORATOR COIL. INSTALL IN ACCESSIBLE LOCATION. VERIFY EXACT REQUIREMENTS OF OFCO WALK-IN COOLER PRIOR TO ROUGH-IN.
2. PROVIDE 60A/3P/4W/430 DISCONNECT.
3. PROVIDE WALL MOUNTED BUCK & BOOST STEP-UP TRANSFORMER. SINGLE PHASE 208V PRIMARY AND 220V SECONDARY AT 50 AMPS.

HMB
ENGINEERING
CONSULTANTS

2902 NORTH FLORES
SAN ANTONIO, TEXAS 78212
210.393.1840 PHONE
SAN ANTONIO - RGW
18PF T&E REGISTRATION NO. 13361



ARCHITECT Above Ground Design, PLLC
200 Grooms Road
Cibola, Texas 78108
MEPT HMB Engineering
2902 N Flores Street
San Antonio, Texas 78212
STRUCTURAL Hoffer Structural Solutions
3405 Proctor Road
San Antonio, Texas 78258
COPYRIGHT 2023

BAR HOUSE, LLC
NEW BAR HOUSE

SAN ANTONIO, TEXAS 78212
DESIGN DEVELOPMENT



KEY PLAN

PLAN
NORTH
TRUE
NORTH



CLIENT BAR HOUSE, LLC		
PROJECT NUMBER 23016		
DATE MARCH 10, 2023		
REVISIONS		
No.	Description	Date
2	EDIC: COMMENTS	08/01/23


DESIGN DEVELOPMENT

FIRST FLOOR
POWER PLAN

E200

CHECKED BY: Checker

DRAWN BY: Author

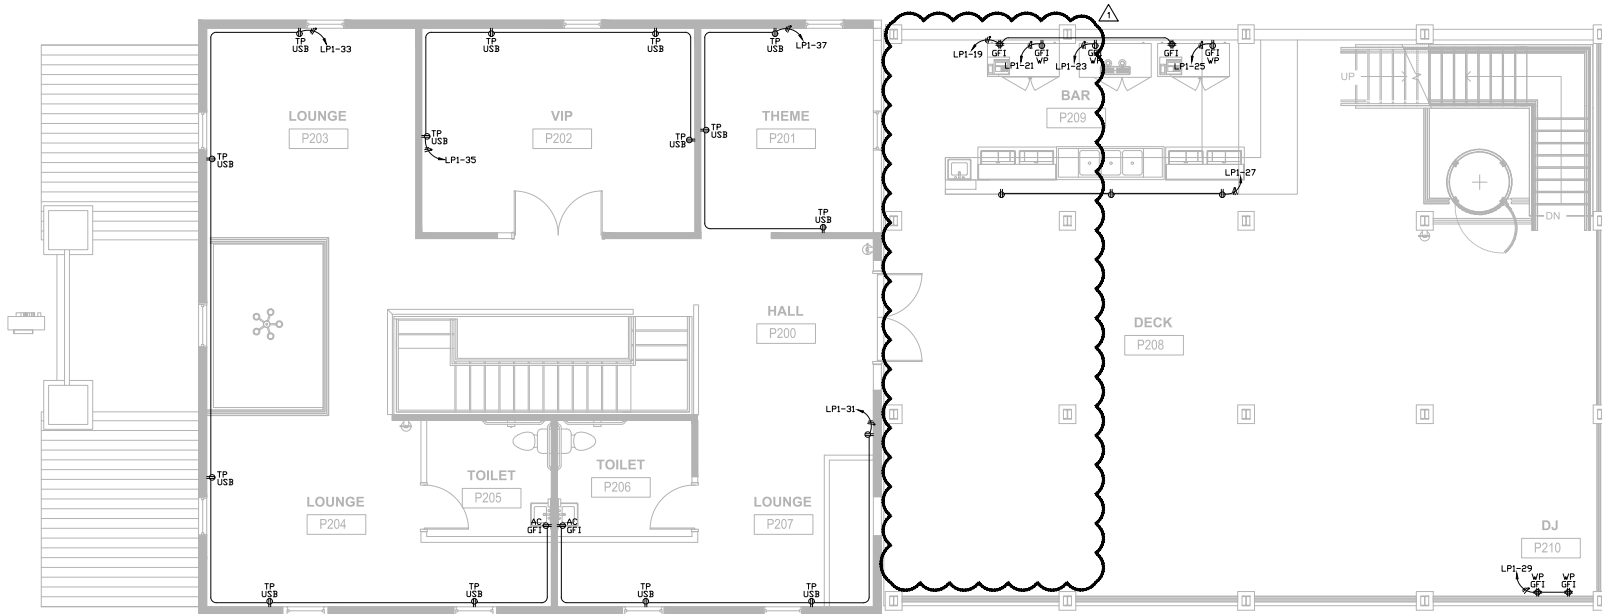

1 SECOND FLOOR POWER PLAN
1/4" = 1'-0"

HMB
ENGINEERING
CONSULTANTS

2902 NORTH FLORES
SAN ANTONIO, TEXAS 78212
210.393.1840 PHONE
SAN ANTONIO - RGW
18PF T&E REGISTRATION NO. 13361



ARCHITECT Above Ground Design, PLLC
200 Grooms Road
Cibola, Texas 78108
MEPT HMB Engineering
2902 N Flores Street
San Antonio, Texas 78212
STRUCTURAL Hoffer Structural Solutions
3405 Proctor Road
San Antonio, Texas 78238
COPYRIGHT 2023

BAR HOUSE, LLC
NEW BAR HOUSE

DESIGN DEVELOPMENT



KEY PLAN

PLAN
NORTH
TRUE
NORTH




CLIENT BAR HOUSE, LLC		
PROJECT NUMBER 22016		
DATE MARCH 10, 2023		
REVISIONS		
No.	Description	Date
1	EDIC COMMENTS	08/01/23
DESIGN DEVELOPMENT		

SECOND FLOOR
POWER PLAN

E201

CHECKED BY: Checker

DRAWN BY: Author

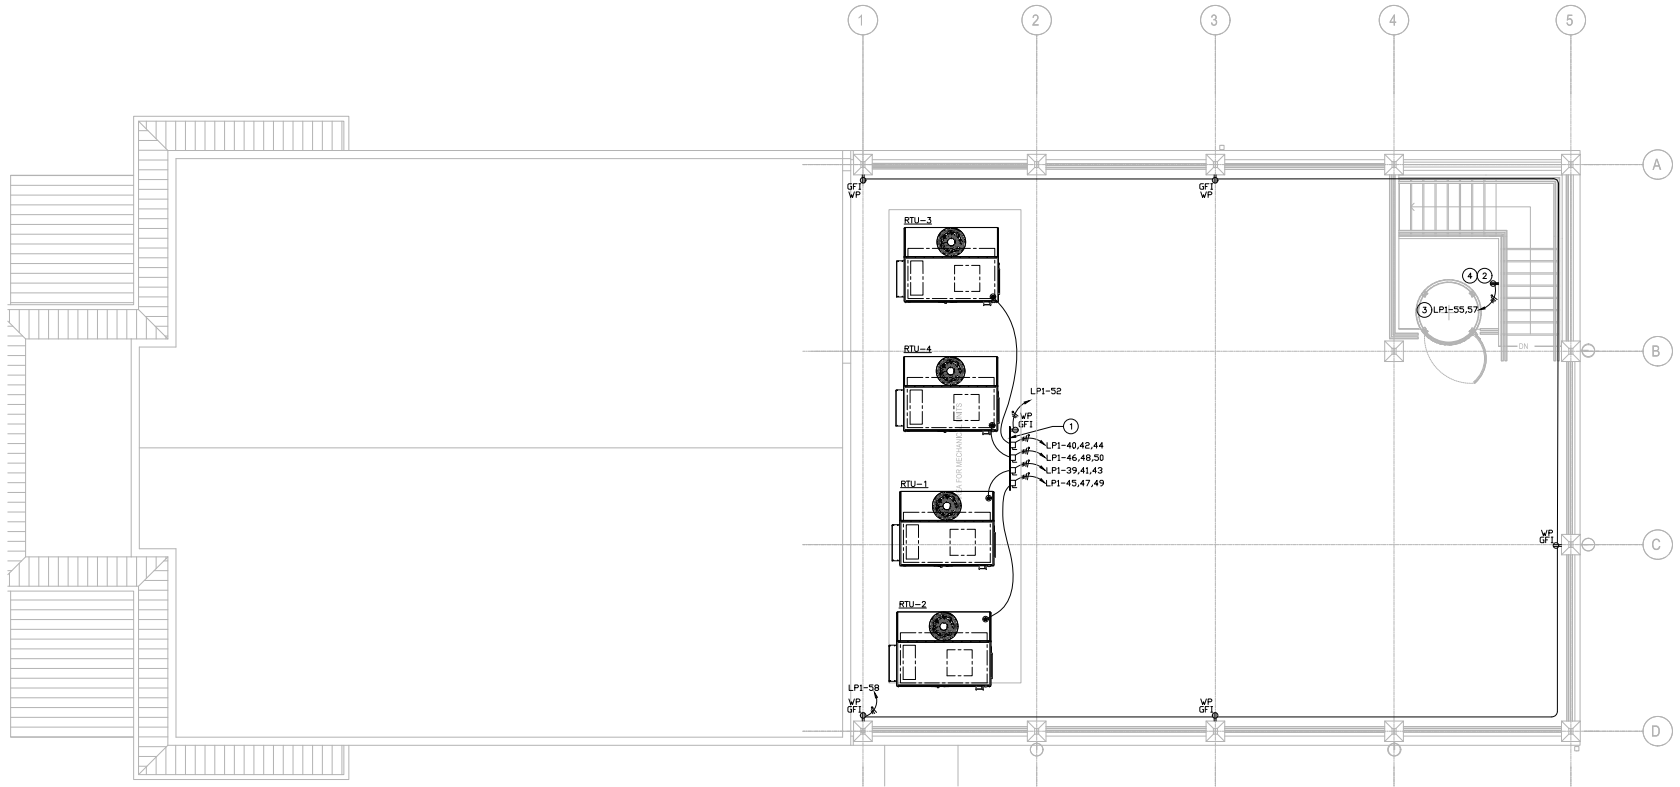

1 ROOF POWER PLAN
1/4" = 1'-0"

KEYED NOTES:

1. REFER TO DETAIL 4/E202.
2. PROVIDE NEMA 6-30 RECEPTACLE FOR PNEUMATIC ELEVATOR. COORDINATE WITH ELEVATOR EQUIPMENT SUPPLIER FOR FINAL LOCATION PRIOR TO INSTALLATION.
3. ROUTE CIRCUIT THROUGH STEP-UP TRANSFORMER. REFER TO E200.
4. PROVIDE DEDICATED PHONE LINE ADJACENT TO POWER SUPPLY.

HMB
ENGINEERING
CONSULTANTS

2902 NORTH FLORES
SAN ANTONIO, TEXAS 78212
210.393.1640 PHONE
SAN ANTONIO - RGW
10PE T&E REGISTRATION NO. 13361



ARCHITECT Above Ground Design, PLLC
200 Grooms Road
Cibola, Texas 78108
MEPT HMB Engineering
2902 N Flores Street
San Antonio, Texas 78212
STRUCTURAL Hoffer Structural Solutions
340 Proctor Road
San Antonio, Texas 78258
COPYRIGHT 2023

BAR HOUSE, LLC
NEW BAR HOUSE
400 NORTH ALAMO STREET
SAN ANTONIO, TEXAS 78205
DESIGN DEVELOPMENT



KEY PLAN

PLAN NORTH
TRUE NORTH



CLIENT
BAR HOUSE, LLC
PROJECT NUMBER
22016
DATE MARCH 10, 2023
REVISIONS
No. Description Date
2 H20C COMMENTS 08/01/23


DESIGN DEVELOPMENT

ROOF
POWER PLAN

E202

CHECKED BY: Chandler

DRAWN BY: Author

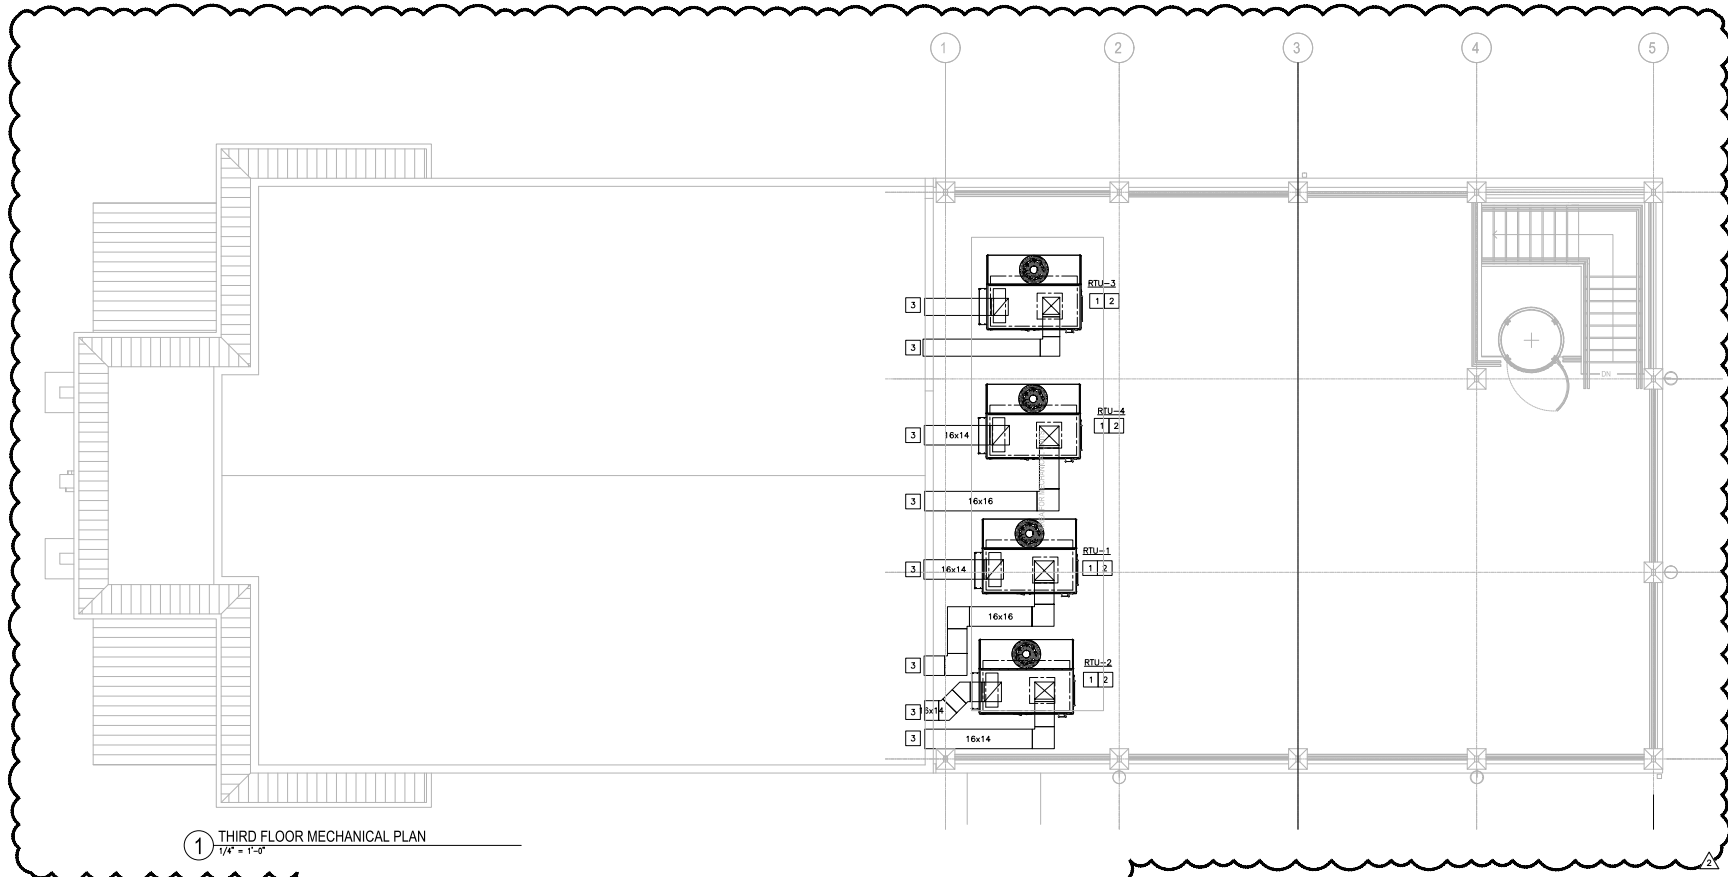

1 THIRD FLOOR MECHANICAL PLAN
1/4" = 1'-0"

MECHANICAL GENERAL NOTES:

- CONTRACTOR SHALL BALANCE EACH DEVICE WITH THE CFM SHOWN ON PLAN.
- NEW PIPING AND DUCTWORK SHOWN ON PLAN ARE SCHEMATIC ONLY. CONTRACTOR SHALL COORDINATE WITH OTHER TRADES FOR PIPING AND DUCTWORK ROUTING, OFFSET AND RUN PIPING, DUCTWORK INSIDE THE STRUCTURE, IF REQUIRED, PROVIDE ANY EXTRA PIPING, DUCTWORK, FITTINGS, INSULATIONS AND OTHER ACCESSORIES IN ORDER TO COMPLETE THE INSTALLATION.
- COORDINATE LOCATIONS AND SIZES OF ROOF OPENINGS WITH OWNER AND STRUCTURE ENGINEERS.
- EQUIPMENT SIZES, DIMENSIONS AND REQUIRED CONNECTIONS SHALL BE VERIFIED WITH THE ACTUAL EQUIPMENT SELECTED VENDOR DRAWINGS BEFORE FABRICATION OF DUCTWORK, PIPING, ETC.
- DUCT SIZES SHOWN ON PLANS ARE CLEAR INSIDE AIR STREAM DIMENSIONS.
- CONTRACTOR SHALL COORDINATE ALL ELECTRICAL REQUIREMENTS FOR ALL HVAC BASED ON ACTUAL EQUIPMENT SELECTED PRIOR TO INSTALLATION.
- CONTRACTOR SHALL COORDINATE EQUIPMENT WEIGHTS AND SUPPORTS BASED ON ACTUAL EQUIPMENT SELECTED.
- ALL EXPOSED DUCTWORK SHALL BE AS SHOWN, DOUBLE-WALL, INSULATED METAL, PRIMED FOR PAINTING, UNLESS OTHERWISE NOTED ON PLAN. ALL CONCEALED DUCTWORK SHALL BE INSULATED DUCT BOARD RECTANGULAR UNLESS ALLOWED IN WRITING BY THE ENGINEER OF RECORD. COORDINATE FINAL FINISH WITH ARCHITECT.
- COORDINATE WITH ALL TRADES FOR MATERIALS IN RATED AND PLENUM SPACES.
- ALL EXHAUST FANS SCHEDULED TO BE AUTOMATICALLY CONTROLLED BY MECHANICAL AIR HANDLERS SHALL BE CONNECTED BY MEANS OF AN AUXILIARY RELAY. PROVIDE AUXILIARY RELAY AS NEEDED.
- ANY SOURCE OF MECHANICAL INTAKE SHALL MAINTAIN 10 LINEAR FEET SEPARATION BETWEEN ANY SOURCE OF EXHAUST. CONTRACTOR IS RESPONSIBLE TO ADJUST DUCT LENGTH AS NEEDED.

KEYED NOTES:

- CONTRACTOR TO RUN CONDENSATE DRAIN TO MOP SINK IN JANITOR CLOSET.
- COORDINATE FINAL LOCATION OF EQUIPMENT WITH STRUCTURAL DRAWINGS. UNIT MUST BE AT LEAST 3' AWAY FROM EDGE OF ROOF.
- REFER TO M200 FOR CONTINUATION.

HMB
ENGINEERING
CONSULTANTS

2902 NORTH FLORES
SAN ANTONIO, TEXAS 78212
210.393.1840 PHONE
SAN ANTONIO - RGJ
TYPE FIRM REGISTRATION NO. 13241



ARCHITECT Above Ground Design, PLLC
200 Grooms Road
Cocke, Texas 78108
MEPT HMB Engineering
2802 N Flores Street
San Antonio, Texas 78212
STRUCTURAL Hoffer Structural Solutions
948 Preton Road
San Antonio, Texas 78256
COPYRIGHT 2023

BAR HOUSE, LLC
NEW BAR HOUSE

100 NORTH ALAMO STREET
SAN ANTONIO, TEXAS 78203
DESIGN DEVELOPMENT



KEY PLAN

PLAN NORTH
TRUE NORTH



CLIENT: BAR HOUSE, LLC
PROJECT NUMBER: 23016
DATE: MARCH 10, 2023
REVISIONS
No. 1 Description Date
2 HDB Comments 8/3/2023

DESIGN DEVELOPMENT

THIRD FLOOR
MECHANICAL PLAN

M300

CHECKED BY: Choder

DRAWN BY: Author

MECHANICAL EQUIPMENT (ELECTRIC HEAT) SCHEDULE																
TAG	FLOW RATE		STATIC PRESSURE		ELECTRICAL DATA			DX COOLING			ELECTRIC HEATING			BASIS OF DESIGN		
	SUPPLY	OA	EXTERNAL	MCA	MOCP	VOLTAGE	SENSIBLE	TOTAL	ENT. AIR TEMP	LEA. AIR TEMP	COIL	STAGES	KW	VOLTAGE	MANUFACTURER	MODEL OR SERIES
RTU - 1	1440	440	0.5	43.6	45	200/30	35.4	50.0	99/74	52/52	1	11	200/30	CAPTIVEARE	CASRTU-E-152-15-01	1.5
RTU - 2	1300	230	0.5	43.6	45	200/30	34.8	39.7	99/74	50/50	1	10	200/30	CAPTIVEARE	CASRTU-E-152-15-01	1.5
RTU - 3	1050	430	0.5	41.9	45	200/30	27.7	43.8	99/74	50/50	1	9	200/30	CAPTIVEARE	CASRTU-E-152-15-01	1
RTU - 4	1350	325	0.5	43.6	45	200/30	34.5	45.1	99/74	51/51	1	10	200/30	CAPTIVEARE	CASRTU-E-152-15-01	1.5
NOTES:																
1. UNIT TO BE PROVIDED WITH ELECTRIC HEAT, FAN, DX COOLING COIL AND FILTER SECTION.																
2. PROVIDE 14" ROOF CURB AND HAIL GUARD.																
3. PROVIDE AUXILIARY RELAY FOR CONNECTION OF EXHAUST FAN.																
4. PROVIDE SMOKE DUCT DETECTOR AT RETURN.																
5. ECONOMIZER NOT REQUIRED, HIGH EFFICIENCY UNIT.																

ELECTRIC UNIT HEATER SCHEDULE		
MARK	ELH-1	
SERVES	RISER	
KW	3.3/2.5	
VOLTS/PHASE/HERTZ	240-208/1/60	
AMPS	13.7/12.0	
MANUFACTURER	MARKEL	
MODEL NO.	HF2B5103	
WEIGHT	25	
NOTES	1	
NOTE:		
1. SHALL INCLUDE WALL MOUNTED THERMOSTAT, FUSED CONTROL CIRCUIT, MANUAL RESET HIGH LIMIT, "FAN ONLY" SWITCH AND WALL BRACKET.		

MECHANICAL AIR TERMINAL DEVICES SCHEDULE						
TAG	SIZE	DESCRIPTION	CONSTRUCTION	FINISH	BASIS OF DESIGN	
					MANUFACTURER	MODEL OR SERIES
A	24X24	LOUVERED FACE SUPPLY AIR DIFFUSER	ALUMINUM	WHITE	TITUS	TMS-AA
B	24X24	PERFORATED FACE RETURN AIR GRILLE	ALUMINUM	WHITE	TITUS	PAR-AA
C	12X12	LOUVERED FACE SUPPLY AIR DIFFUSER	ALUMINUM	WHITE	TITUS	TMS-AA
D	12X12	PERFORATED FACE RETURN AIR GRILLE	ALUMINUM	WHITE	TITUS	PAR-AA
NOTES:						
1. PROVIDE STANDARD WHITE FINISH FOR ALL AIR DEVICES UNLESS NOTED OTHERWISE ON PLAN.						
2. PAINT ALL SURFACES VISIBLE THROUGH FACE OF RETURN AIR GRILLES FLAT BLACK. THIS SHALL INCLUDE PIPING, CONDUIT, DUCTWORK, AND STRUCTURAL MEMBERS.						
3. PROVIDE FRAME FOR MOUNTING AIR DEVICE IN LAY-IN GRID CEILING UNLESS REFLECTED CEILING PLAN INDICATES HARD CEILING. IN AREAS WITH HARD CEILINGS, PROVIDE FRAMES FOR SURFACE MOUNTING.						
4. UNLESS OTHERWISE NOTED, BRANCH DUCTS SERVING AIR DEVICES SHALL BE SAME SIZE AS NECK OF AIR DEVICE.						
5. PROVIDE GRILLE WITH INSULATED BACKPAN OPTION.						
FOR ROUND NECK DIFFUSERS:						
6" DIA: 0-120 CFM						
8" DIA: 125-220 CFM						
10" DIA: 225-380 CFM						
12" DIA: 385-500 CFM						

MECHANICAL FAN SCHEDULE											
TAG	FLOW RATE	STATIC PRESSURE		MOTOR DATA		ELECTRICAL DATA		MAXIMUM		BASIS OF DESIGN	NOTES
		EXTER.	MCA	LOAD (SPEED)	HP	VOLTAGE	LOADS				
	CFM	IN WG	HP	RPM	AMPS	AMPS		3.5	MANUFACTURER	MODEL OR SERIES	
EF-1	475	0.15	-	1400	0.4	15	120	3.5	L. COOK	GN-622	2.3, 4
EF-2	75	0.15	-	750	0.4	15	120	0.9	L. COOK	GC-128	1.3
NOTES:											
1. INTERCONNECT WITH LIGHTS IN ROOM. REFER TO ELECTRICAL LIGHTING PLAN.											
2. PROVIDE FACTORY MOUNTED AND INSTALLED DISCONNECT.											
3. PROVIDE ACCESS DOOR TO SERVICE UNIT IF IN HARD CEILING.											
4. INTERCONNECT WITH INTEGRATED AUXILIARY RELAY OF RTU-2. PROVIDE SUPPLEMENTAL AUXILIARY RELAY AS REQUIRED.											

HMB
ENGINEERING
CONSULTANTS

2902 NORTH FLORES
SAN ANTONIO, TEXAS 78212
210.393.1840 PHONE
SAN ANTONIO - REG
TYPE IIRM REGISTRATION NO. 13341



ARCHITECT Above Ground Design, PLLC
200 Grooms Road
Cocke, Texas 79108

MEPT HMB Engineering
2802 N Flores Street
San Antonio, Texas 78212

STRUCTURAL Hoffer Structural Solutions
948 Preston Road
San Antonio, Texas 78258

COPYRIGHT 2023

BAR HOUSE, LLC
NEW BAR HOUSE



KEY PLAN



CLIENT: BAR HOUSE, LLC		
PROJECT NUMBER: 23016		
DATE: MARCH 10, 2023		
REVISIONS		
No.	Description	Date
2	HDRC Comments	3/13/2023

DESIGN DEVELOPMENT

MECHANICAL
SCHEDULES



PLUMBING SYMBOLS AND ABBREVIATIONS

(NOT ALL OF THE SYMBOLS SHOWN MAY BE USED ON THE PROJECT.)

SYMBOL	DESCRIPTION	ABBREVIATION	SYMBOL	DESCRIPTION	ABBREVIATION	SYMBOL	DESCRIPTION	ABBREVIATION	ABBREVIATIONS	ABBREVIATIONS
	STORM DRAIN, RAINWATER DRAIN	SD, RT		OUTSIDE YOLK & STEM GATE VALVE	OSY		UPRIGHT FIRE SPRINKLER HEAD	-	A	ABOVE FINISHED FLOOR
	SUBSOLAR DRAIN, FOOTING DRAIN	SSD		GATE VALVE	GV		FIRE HOSE RACK	FHR	AF	ABOVE CEILING
	GREASE WASTE	GREASE, WASTE		GLOBE VALVE	GLV		AUTOMATIC SPRINKLER PIPE	-	ACU	AIR-CONDITIONING UNIT(S)
	ABOVE GRADE SOIL, WASTE, OR SANITARY SEWER	S, W, SAN, SS		ANGLE VALVE	AV		AIR HANDLING UNIT	-	AHP	AIR HORSEPOWER
	BELOW GRADE SOIL, WASTE, OR SANITARY SEWER	S, W, SAN, SS		BALL VALVE	BV		ALTERNATING CURRENT	-	AC	MINIMUM
	VENT	V		BUTTERFLY VALVE	BFV		ALTITUDE	-	ALT	AMBIENT
	ACID WASTE	AW		GAS COOK, GAS STOP	-		AMERICAN NATIONAL STANDARDS INSTITUTE	-	ANSI	AMERICAN WIRE GAUGE
	ACID VENT	AV		BALANCING VALVE (SPECIFY TYPE)	BLV		ANGLE	-	AMP	AMPERE (AMP, AMPS)
	INDIRECT DRAIN	D		CHECK VALVE	CV		ANGLE OF INCIDENCE	-	ANG	APPARATUS DOWN POINT
	PUMP DISCHARGE LINE	PD		PLUG VALVE	PV		APPROXIMATE	-	APPROX	AREA
	COLD WATER	CW		ACCESS PANEL LOCATION	AP		ATMOSPHERE	-	ATM	ATMOSPHERE
	HOT WATER SUPPLY (120°)	HW		PLUMBING FIXTURE DESIGNATION	-		BELOW FINISH FLOOR	-	B	BELOW FINISH FLOOR
	HOT WATER SUPPLY (140°)	140°		SOLENOID VALVE	-		BELOW GRADE	-	BG	BELOW GRADE
	HOT WATER RETURN (120°)	HWR		MOTOR-OPERATED VALVE (SPECIFY TYPE)	-		BRAKE HORSEPOWER	-	BHP	BRAKE HORSEPOWER
	HOT WATER RETURN (140°)	140R		PRESSURE-REDUCING VALVE	PRV		BTU	-	BTU	BRITISH THERMAL UNIT
	TEMPERED HOT WATER (TEMP.F)	TEMP, HW, TW		PRESSURE-RELIEF VALVE	RV		C TO C	-	C	CELSIUS
	TEMPERED HOT WATER RECIRCULATING (TEMP.F)	TEMP, HWR, TWR		TEMPERATURE-PRESSURE-RELIEF VALVE	TPV		C TO C CENTER TO CENTER	-	C	CENTER TO CENTER
	(CHILLED) DRINKING WATER SUPPLY	DWS		REDUCED ZONE BACKFLOW PREVENTER	RZBP		CIRCUIT	-	CAT	CLOCKWISE
	(CHILLED) DRINKING WATER RECIRCULATING	DWR		DOUBLE-CHECK BACKFLOW PREVENTER	DCBP		CUBIC FOOT	-	CCW	COUNTERCLOCKWISE
	SOFT WATER	SW		HOSE BIBB	HB		CUBIC INCH	-	CCW	COUNTERCLOCKWISE
	CONDENSATE DRAIN	CD		RECESSED-BOX HOSE BIBB OR WALL HYDRANT	WH		CUBIC FT PER MINUTE	-	CFM	CUBIC FOOT PER MINUTE
	DISTILLED WATER	DI		VALVE IN YARD BOX (VALVE TYPE SYMBOL AS REQUIRED FOR VALVE USE)	YB		CUBIC FT PER SEC. STANDARD	-	CFM	CUBIC FOOT PER MINUTE
	AQUASTAT	-								
	TAMPER SWITCH	TS								
	FLOW SWITCH	FS								
	PRESSURE SWITCH	PS								
	WATER HAMMER ARRESTER (PDI DESIGNATION "A")	WA								
	PRESSURE GAUGE WITH GAUGE COCK	PG								
	THERMOMETER (SPECIFY TYPE)	-								
	AUTOMATIC AIR VENT	AAV								
	CIRCUIT SETTER	CS								
	VALVE IN RISER (TYPE AS SPECIFIED OR NOTED)	-								
	RISER DOWN (ELBOW)	-								
	RISER (ELBOW)	-								
	AIR CHAMBER	-								
	RISE OR DROP	-								
	BRANCH-BOTTOM CONNECTION	-								
	BRANCH-SIDE CONNECTION	-								
	CAP ON END PIPE	-								
	FLOW INDICATOR FOR STATIONARY METER (ORIFICE)	-								
	FLOW INDICATOR FOR PORTABLE METER (SPECIFY FLOW RATE)	-								

GENERAL PLUMBING NOTES:

- ALL WORK SHALL CONFORM TO ALL STATE AND LOCAL CODES, RULES AND REGULATIONS, AND ORDINANCES.
- PLUMBING PLANS ARE DIAGRAMMATIC ONLY. THEY ARE INTENDED TO INDICATE CAPACITY, SIZE, LOCATION, DIRECTION AND GENERAL ARRANGEMENT. WHERE NOT SPECIFICALLY SHOWN ON PLANS, CONTRACTOR SHALL APPLY PROFESSIONAL STANDARDS SUCH AS THAT OF THE AMERICAN SOCIETY OF PLUMBING ENGINEERS.
- WORK SHALL INCLUDE ALL LABOR, MATERIALS, PERMITS AND OTHER COSTS AS ARE NECESSARY FOR THE INSTALLATION OF A COMPLETE AND SATISFACTORY OPERATIONAL PLUMBING AND SANITARY SYSTEM. EQUIPMENT SHALL BE INSTALLED IN SUCH A MANNER AS TO MAINTAIN ITS LISTING AND THE MANUFACTURER'S WARRANTIES.
- THIS CONTRACTOR SHALL COORDINATE WITH THE OTHER TRADES TO INSURE THAT EACH TRADE SHALL HAVE SUFFICIENT SPACE TO INSTALL THEIR EQUIPMENT (DUCTWORK, PIPING, ELECTRICAL, ETC.), ALONG WITH THE PLUMBING WORK.
- WHERE THE TERM "PROVIDE" IS USED, IT SHALL MEAN "FURNISH AND INSTALL". THE CONTRACTOR SHALL COORDINATE HIS WORK WITH ALL THE OTHER TRADES PRIOR TO THE FABRICATION, PURCHASE AND/OR INSTALLATION OF THE WORK.
- UNLESS NOTED, ALL MATERIALS SHALL BE NEW, COMPLETE, INCLUDE MANUFACTURER'S WARRANTY, AND BE U.L. APPROVED IF APPLICABLE. ALL WORK SHALL PRESENT A NEAT MECHANICAL APPEARANCE WHEN COMPLETED.
- FIELD VERIFY ALL DIMENSIONS. CONTRACTOR SHALL VERIFY ELEVATION OF UTILITY CONNECTIONS ON SITE PRIOR TO COMMENCING WORK. FINAL CONNECTION TO SITE UTILITIES SHALL BE BY THE PLUMBING CONTRACTOR.
- PIPING ROUTED THROUGH FOUNDATIONS SHALL BE SLEEVED AND INSTALLED IN ACCORDANCE WITH THE AMERICAN SOCIETY OF PLUMBING ENGINEERS STANDARDS.
- PLUMBING SYSTEM INSTALLER SHALL PROVIDE ALL STRUCTURAL MEMBERS, SUPPORT BRACKETS, FLASHING, HARDWARE, ETC., REQUIRED TO INSTALL A COMPLETE SYSTEM.
- DRAIN WASTE AND VENT PIPING SHALL BE PVC SCH. 40 WHEN INSTALLED BELOW GRADE OR UNDER CONCRETE SLABS. DRAIN WASTE AND VENT PIPING INSTALLED ABOVE GRADE SHALL BE PVC SCH. 40.
- DOMESTIC WATER PIPING SHALL BE TYPE "L" COPPER.
- PLUMBING CONTRACTOR SHALL CERTIFY ALL WATER PIPING AND SPECIALTIES FREE FROM MICROBIAL CONTAMINATION BY SANITIZING THE PLUMBING SYSTEM BEFORE OCCUPATION OF BUILDING.
- EXPOSED FIXTURE TRIM SHALL BE CHROME PLATED BRASS. PROVIDE INDIVIDUAL STOPS FOR EACH HOT AND COLD WATER CONNECTION TO FIXTURES.
- ALL SANITARY PIPING CHANGES OF DIRECTION 45 DEGREES OR MORE SHALL BE ACCOMPLISHED BY USING 45 DEGREE 1/8 BEND ELBOWS UNLESS OTHERWISE NOTED.

PLUMBING SYSTEMS INSULATION REQUIREMENTS

- DESIGN ASSUMES A CODE COMPLIANT BUILDING ENVELOPE.
- ALL HOT WATER AND RECIRCULATING PIPING SHALL BE INSULATED.
- CONTRACTOR SHALL INSULATE ALL PIPING INSTALLED WITHIN EXTERIOR WALLS.
- CONTRACTOR SHALL INSULATE ALL PIPING LOCATED IN UNCONDITIONED SPACES SUBJECT TO FREEZING.
- CONTRACTOR SHALL INSULATE ALL EXPOSED PIPING INSTALLED WITHIN A NORMALLY OCCUPIED SPACE FOR SOUND ATTENUATION AND AESTHETIC. THIS INCLUDES EXPOSED SANITARY AND STORM PIPING.
- INSTALLING CONTRACTOR SHALL BE RESPONSIBLE FOR COORDINATING WITH GC FOR DETERMINATION OF THE INSTALLED BUILDING INSULATION AND/OR VALVE ENGINEERING OF THE REQUIRED INSULATION NOTED WITH THE BUILDING ARCHITECT AND ENGINEER PRIOR TO PROVIDING ANY FRIGING.



2902 NORTH FLORES
SAN ANTONIO, TEXAS 78212
210.393.1840 PHONE
SAN ANTONIO - RGV
TYPE BHM REGISTRATION NO. 13241



ARCHITECT Above Ground Design, PLLC
200 Grooms Road
Cibola, Texas 79108
MEPT HMD Engineering
2802 N Flores Street
San Antonio, Texas 78212
STRUCTURAL Hoffer Structural Solutions
948 Preston Road
San Antonio, Texas 78258
COPYRIGHT 2023

BAR HOUSE, LLC
NEW BAR HOUSE



KEY PLAN
PLAN NORTH
TRUE NORTH



CLIENT		
BAR HOUSE, LLC		
PROJECT NUMBER		
23016		
DATE	MARCH 10, 2023	
REVISIONS		
No.	Description	Date
DESIGN DEVELOPMENT		


DESIGN DEVELOPMENT

PLUMBING SYMBOLS & ABBREVIATIONS


P000

CHECKED BY: Chandler


DRAWN BY: Author

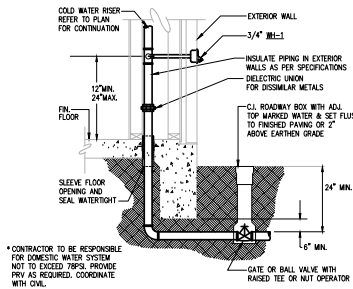


1 WATER PIPE ENTRY DETAIL
NTS

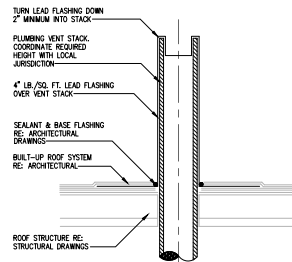


2 VENT THRU ROOF
NTS

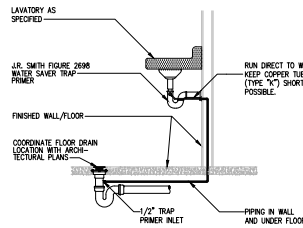


3 TRAP PRIMER DETAIL
NTS

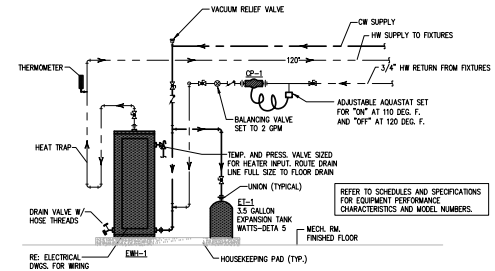


4 WATER HEATER DETAIL
NTS

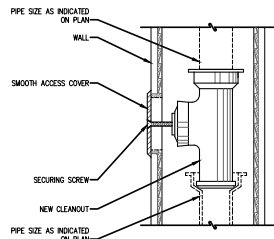


5 WALL CLEANOUT
NTS

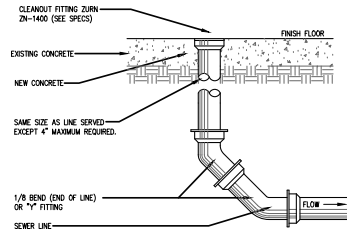


6 FLOOR CLEANOUT DETAIL
NTS

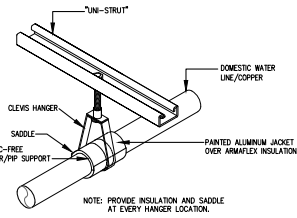

7 WATER PIPING SUPPORT DETAIL
NTS

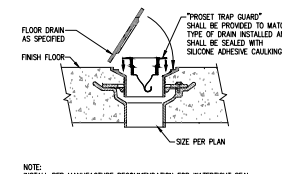


8 TRAPGUARD DETAIL
NTS

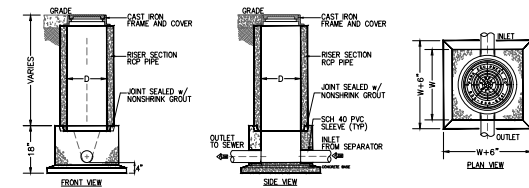

9 SAMPLE WELL DETAIL
NTS

- NOTES
1. SAMPLING WELL MUST BE INSTALLED UNDER A SEPARATE PLUMBING PERMIT.
 2. USE 15" TAG R.C.P. FOR INSTALLATION GREATER THAN 6'-0" DEEP AND LESS.
 3. USE 24" TAG R.C.P. FOR INSTALLATION GREATER THAN 6'-0" DEEP. (STD RING AND M.H. COVER REQUIRED)
 4. SAMPLING WELL MUST BE SET IN A CIRCULAR OR SQUARE CONCRETE PAD (1'-0" GREATER THAN OUTSIDE DIAMETER OF PIPE.)
 5. INSIDE INSTALLATION NOT PERMITTED, WHERE OUTSIDE INSTALLATION IS POSSIBLE.
 6. INSTALLATION INSIDE BLDG MUST BE POURED IN PLACE (15' MIN) NO CONCRETE PIPE IS PERMITTED. (AIR-TIGHT COVER REQUIRED.)
 7. LAWN INSTALLATION MUST BE 4" ABOVE FINISHED GRADE.
 8. DRIVE & SIDEWALK INSTALLATION MUST BE BROUGHT TO FINISHED GRADE
 9. TO BE INSTALLED ON PRIVATE PROPERTY, IN AN ACCESSIBLE LOCATION TO CITY PERSONNEL.

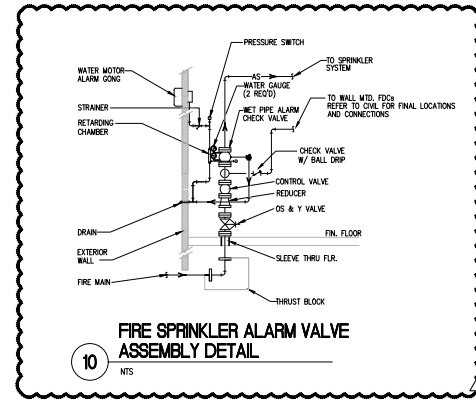

10 FIRE SPRINKLER ALARM VALVE ASSEMBLY DETAIL
NTS

HMB3
ENGINEERING
CONSULTANTS

2902 NORTH FLORES
SAN ANTONIO, TEXAS 78212
210.393.1840 PHONE
SAN ANTONIO - RGV
TPE FRM REGISTRATION NO. 13241



ARCHITECT	Above Ground Design, PLLC 200 Grooms Road Cibola, Texas 78108
MEPT	HMB Engineering 2902 N Flores Street San Antonio, Texas 78212
STRUCTURAL	Hoffer Structural Solutions 948 Preston Road San Antonio, Texas 78256
COPYRIGHT 2023	

BAR HOUSE, LLC
NEW BAR HOUSE

100 NORTH ALAMO STREET
SAN ANTONIO, TEXAS 78205
DESIGN DEVELOPMENT



KEY PLAN
PLAN NORTH
TRUE NORTH



CLIENT BAR HOUSE, LLC		
PROJECT NUMBER 23016		
DATE	MARCH 10, 2023	
REVISIONS		
No.	Description	Date
1	CITY COMMENTS	5/23/2023
2	HDRC COMMENTS	8/3/2023
DESIGN DEVELOPMENT		

DESIGN DEVELOPMENT


PLUMBING
DETAILS

P001

CHECKED BY: Chodler

Author

DRAWN BY:

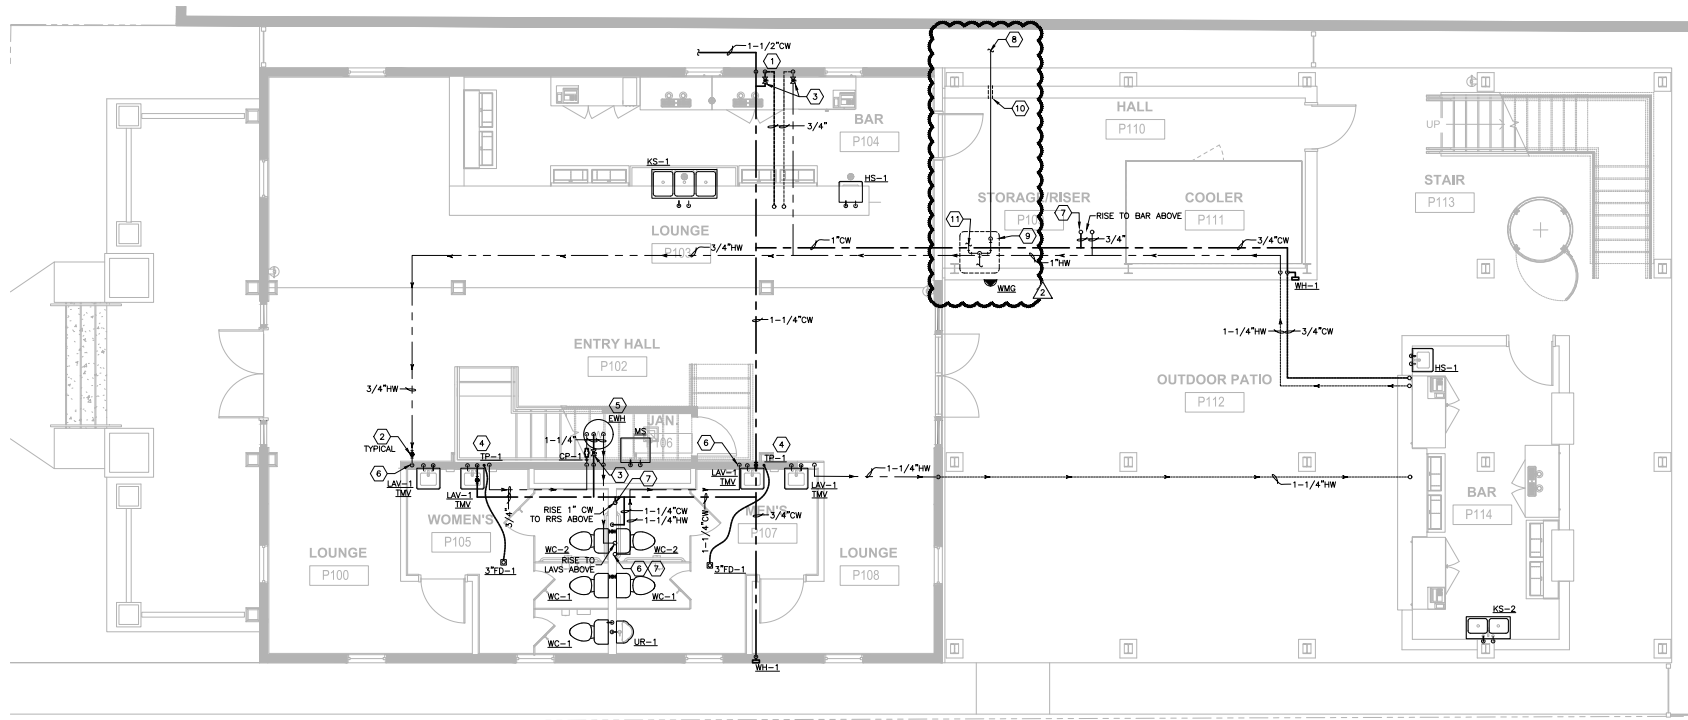

1 FIRST FLOOR DOMESTIC WATER PLAN

1/4" = 1'-0"

GENERAL FIRE PROTECTION NOTES:

- THE ENTIRE BUILDING SHALL BE PROTECTED WITH A HYDRAULICALLY DESIGNED, SIZED AND INSTALLED WET PIPE SPRINKLER SYSTEM. THE DESIGN AND INSTALLATION SHALL BE IN ACCORDANCE WITH NFPA 13, AND NFPA 24 AND ALL LOCAL CODES. SUBMIT SHOP DRAWINGS AND CALCULATIONS AS SPECIFIED.
- AREAS SUBJECT TO FREEZING SHALL BE PROTECTED WITH A HYDRAULICALLY DESIGNED, SIZED, AND INSTALLED DRY-PIPE SYSTEM IN ACCORDANCE WITH NFPA 13 AND ALL LOCAL CODES.
- FIELD VERIFY EXISTING FIRE SPRINKLER SYSTEM. MODIFY THE EXISTING SPRINKLER SYSTEM THROUGHOUT THE AREAS OF RENOVATIONS.
- PROVIDE LIGHT HAZARDS PROTECTION FOR ENTIRE BUILDING EXCEPT FOR MECHANICAL ROOMS, ELECTRICAL ROOMS AND ELEVATOR EQUIPMENT ROOM SHALL RESIST CRACKING HAZARDS, GROUP 2 PROTECTION.

Fixture Type	Quantity	Fixture Units				Totals			
		Drain	Cold Water	Hot Water	Total CW	Drain	Cold Water	Hot Water	Total CW
Bathroom Group (T)	2	4	2.7	1.5	3.6	8	5.4	3	7.2
Water-Closet (T)	5	4	5	0	5	20	25	0	25
Urinal (T)	1	2	5	0	5	2	5	0	5
Lavatory	4	2	1.5	1.5	2	8	6	6	8
Kitchen Sink (Hand Sink)	3	2	1	1	1.4	6	3	3	4.2
Kitchen Sink (Washing)	3	3	3	3	4	9	9	9	12

Total FU			
53	53.4	21	61.4

GPM	30.5	20	33
SIZE	1-1/4"	1-1/4"	1-1/2"
VELOCITY	8.7/5	11/5	8.7/5

KEYED NOTES:

- DOMESTIC WATER SERVICE ENTRY. RE: 1/P001.
- WATER HAMMER ARRESTOR. PROVIDE ACCESS PANEL WHERE LOCATED IN AN INACCESSIBLE WALL/CEILING. PANEL SHALL BE 12"x12" PAINTED TO MATCH WALL/CEILING.
- BALL VALVE. PROVIDE ACCESS PANEL WHERE LOCATED IN AN INACCESSIBLE WALL/CEILING. PANEL SHALL BE 12"x12" PAINTED TO MATCH WALL/CEILING. PROVIDE MARKING OF VALVE LOCATION ALONG THE WALL/CEILING TILE.
- PROVIDE TRAP PRIMER, 2"-1 1/2" SFT TYPE "K" COPPER TRAP PRIMER PIPE INSIDE A POLY SLEEVE. RE: 3/P001.
- INSTALL FLOOR MOUNTED WATER HEATER IN JANITOR'S CLOSET. RE: 4/P001.
- HOT WATER DROP IN WALL TO FUTURE AND RISE. RE: 2/P200.
- REFER TO P101 FOR CONTINUATION.
- REFER TO CIVIL SITE UTILITY PLAN FOR CONTINUATION. CONTRACTOR TO BE RESPONSIBLE FOR COORDINATION, VERIFICATION, AND CONNECTION OF ALL UTILITIES TO SITE UTILITY SUB-OUTS.
- FIRE SPRINKLER SYSTEM BY FIRE PROTECTION CONTRACTOR. PROVIDE FIRE SPRINKLER CONTROL/ALARM VALVE ASSEMBLY RISERS AND REMOTE FIRE DEPARTMENT CONNECTION. REFER TO CIVIL SITE PLAN FOR LOCATION OF ROADSIDE VALVE AND FOC.
- FIRE SPRINKLER SERVICE ENTRANCE. RE: 10/P001.
- TO REMOTE FDCS. REFER TO CIVIL FOR FINAL LOCATIONS AND CONNECTIONS.

HMB
ENGINEERING
CONSULTANTS

2902 NORTH ALAMOS
SAN ANTONIO, TEXAS 78212
210.393.1840 PHONE
SAN ANTONIO - REG.
TPE FIRM REGISTRATION NO. 13241



ARCHITECT Above Ground Design, PLLC
200 Grooms Road
Cocke, Texas 78108
MEPT HMB Engineering
2802 N Flores Street
San Antonio, Texas 78212
STRUCTURAL Hoffer Structural Solutions
948 Preston Road
San Antonio, Texas 78258
COPYRIGHT 2023

BAR HOUSE, LLC
NEW BAR HOUSE

100 NORTH ALAMO STREET
SAN ANTONIO, TEXAS 78203
DESIGN DEVELOPMENT



KEY PLAN

PLAN
NORTH
TRUE
NORTH




CLIENT:
BAR HOUSE, LLC
PROJECT NUMBER:
23016
DATE: MARCH 10, 2023
REVISIONS
No. Description Date
2 HDB COMMENTS 8/3/2023
DESIGN DEVELOPMENT

FIRST FLOOR
DOMESTIC
WATER PLAN

P100

CHECKED BY: Choder

DRAWN BY: Author

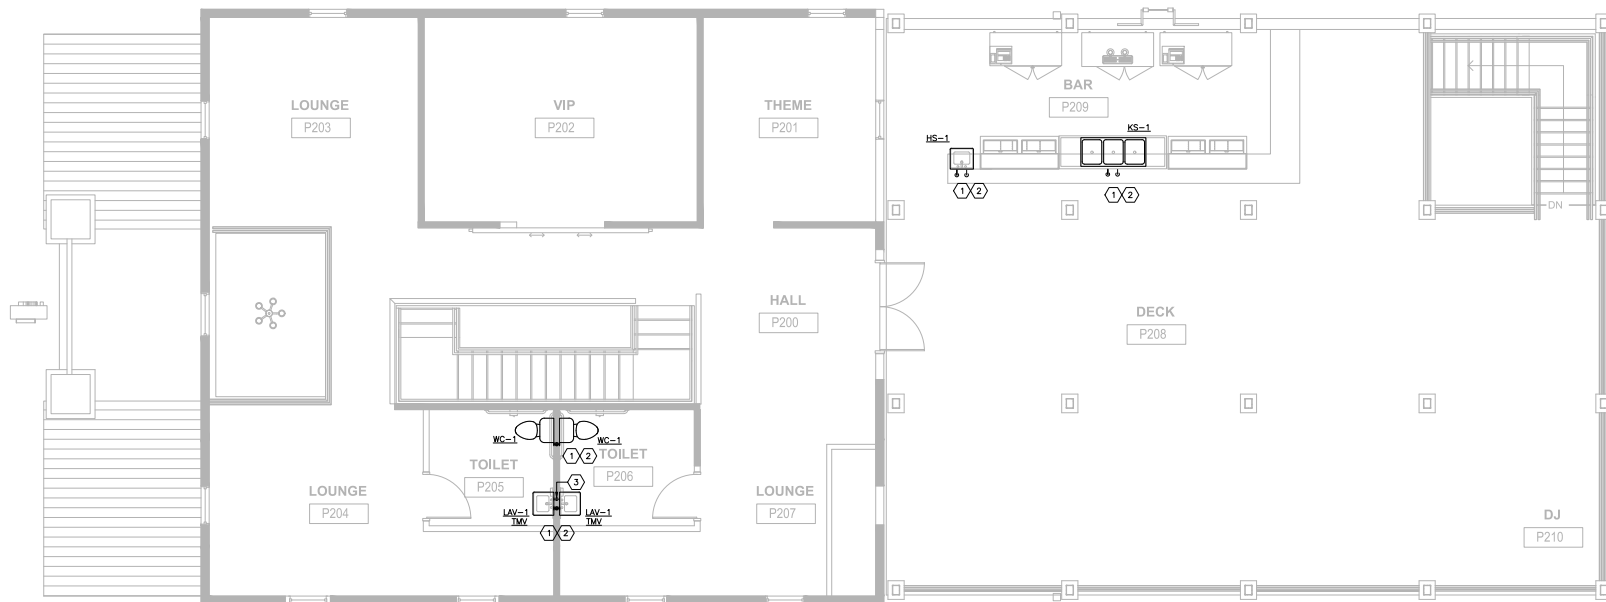

1 SECOND FLOOR DOMESTIC WATER PLAN
1/4" = 1'-0"

2 KEYED NOTES:

1. REFER TO P100 FOR CONTINUATION.
2. REFER TO 2/P200 FOR ROUTING AND SIZING OF HOT AND COLD WATER LINES TO FUTURE.
3. HOT WATER RISE IN WALL TO FIXTURE AND DROP, RE: 2/P200.

HMB
ENGINEERING
CONSULTANTS

2902 NORTH ALAMOS
SAN ANTONIO, TEXAS 78212
210.393.1840 PHONE
SAN ANTONIO - REG
TYPE FIRM REGISTRATION NO. 13341



ARCHITECT	Above Ground Design, PLLC 200 Grooms Road Cocke, Texas 78108
MEPT	HMB Engineering 2802 N. Flores Street San Antonio, Texas 78212
STRUCTURAL	Hoffer Structural Solutions 948 Preston Road San Antonio, Texas 78256
COPYRIGHT 2023	

BAR HOUSE, LLC
NEW BAR HOUSE

100 NORTH ALAMO STREET
SAN ANTONIO, TEXAS 78215
DESIGN DEVELOPMENT



KEY PLAN

PLAN
NORTH

TRUE
NORTH



CLIENT:		BAR HOUSE, LLC
PROJECT NUMBER:		23016
DATE:		MARCH 10, 2023
REVISIONS		
No.	Description	Date


DESIGN DEVELOPMENT

SECOND FLOOR
DOMESTIC
WATER PLAN

P101

CHECKED BY: Chandler

DRAWN BY: Author

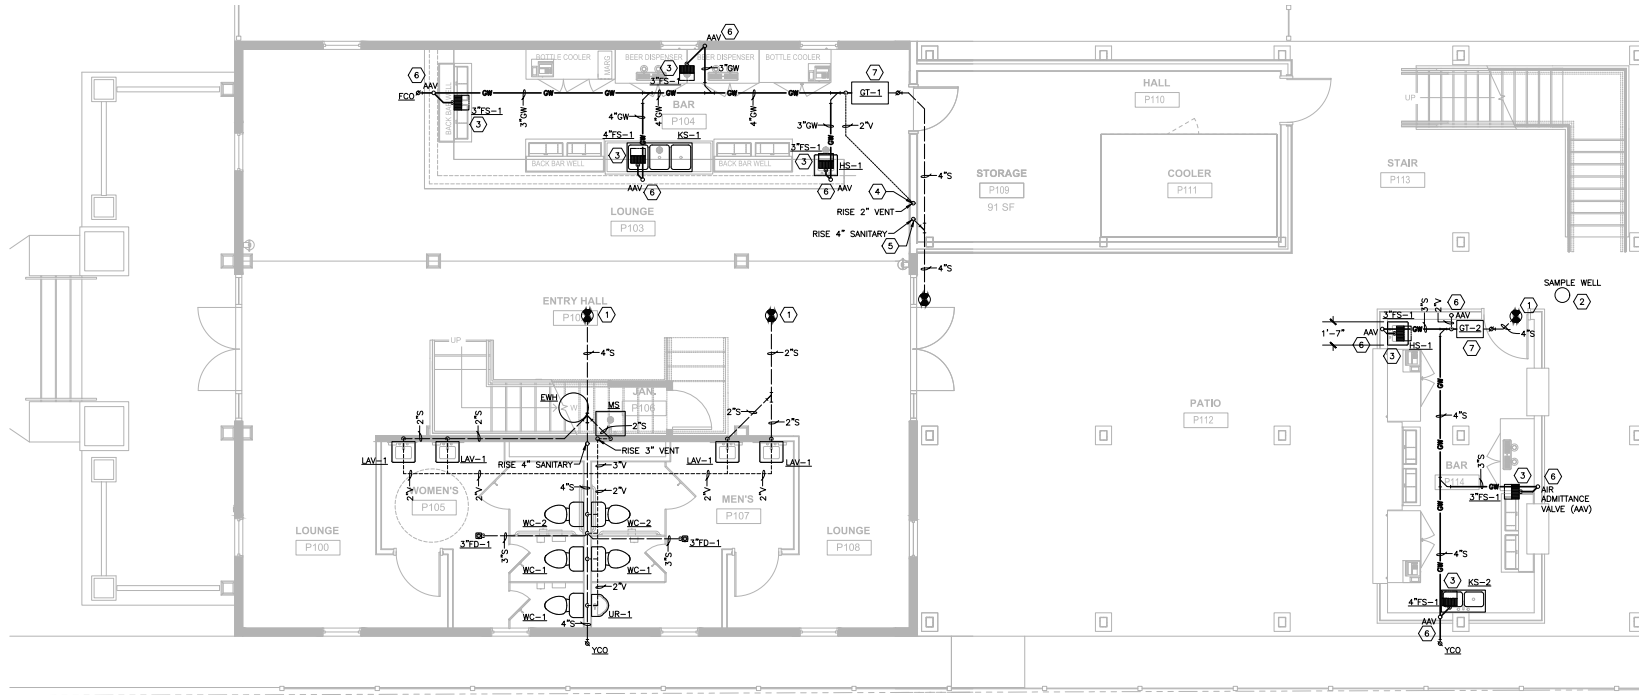

1 FIRST FLOOR WASTE AND VENT PLAN
1/4" = 1'-0"

4 KEYED NOTES:

1. CONNECT SANITARY WITH EXISTING. FIELD VERIFY LOCATION, DIRECTION OF FLOW, AND INVERT PRIOR TO ROUGH-IN.
2. SAMPLING WELL TO BE INSTALLED AFTER THE CONFLUENCE OF ALL WASTE STREAMS IN THE FACILITY AND PRIOR TO DISCHARGING INTO SANITARY SEWER COLLECTION SYSTEM. COORDINATE FINAL LOCATION WITH GC PRIOR TO INSTALLATION. REF: 5/P201.
3. FLOOR DRAIN SERVING INDIRECT DISCHARGE FROM EQUIPMENT. TERMINATE DRAIN PIPING WITH AIR CAP AS REQUIRED.
4. RISE VENT TO SECOND FLOOR. REFER TO P201 FOR CONTINUATION. REFER TO PLAN FOR SIZING.
5. RISE SANITARY TO SECOND FLOOR. REFER TO P201 FOR CONTINUATION. REFER TO PLAN FOR SIZING.
6. PROVIDE AIR ADMITTANCE VALVE EQUAL TO STUDOR MIN-VENT #20341. PROVIDE ACCESS PANEL FOR MAINTENANCE WHEN LOCATED IN AN INACCESSIBLE WALL.
7. RECESSED GREASE INTERCEPTOR INSTALLED IN FLOOR. FOLLOW ALL MANUFACTURER'S RECOMMENDATIONS AND INSTALLATION INSTRUCTIONS. COORDINATE FINAL LOCATION WITH ARCHITECT PRIOR TO INSTALLATION.

Grease Interceptor Load Summary - (GT-1)				
Interceptor Sizing (m) = Volume (cu in) x 1 gal / 231 cu in				
Type of Fixture	Qty	Volume (cu in)	Gallons	Total
3-Compartment Sink	1	6720	29	29
Flow Rate (gpm)				29
+DNV Flow Rate (gpm)				0
Grease Interceptor Capacity (gpm)				29

Grease Interceptor Load Summary - (GT-2)				
Interceptor Sizing (m) = Volume (cu in) x 1 gal / 231 cu in				
Type of Fixture	Qty	Volume (cu in)	Gallons	Total
3-Compartment Sink	1	2025	9	9
Flow Rate (gpm)				9
+DNV Flow Rate (gpm)				0
Grease Interceptor Capacity (gpm)				9

HMB3
ENGINEERING
CONSULTANTS

2902 NORTH FLORES
SAN ANTONIO, TEXAS 78212
210.393.1840 PHONE
SAN ANTONIO - RG
TPE FRM REGISTRATION NO. 13341



ARCHITECT Above Ground Design, PLLC
200 Grooms Road
Cocke, Texas 78108
MEPT HMB3 Engineering
2802 N Flores Street
San Antonio, Texas 78212
STRUCTURAL Hoffer Structural Solutions
948 Pecos Road
San Antonio, Texas 78256
COPYRIGHT 2023

BAR HOUSE, LLC
NEW BAR HOUSE



KEY PLAN
PLAN NORTH
TRUE NORTH




CLIENT
BAR HOUSE, LLC
PROJECT NUMBER
23016
DATE MARCH 10, 2023
REVISIONS
No. Description Date
DESIGN DEVELOPMENT

FIRST FLOOR
WASTE AND
VENT PLAN

P200

CHECKED BY: Choder

DRAWN BY: Author

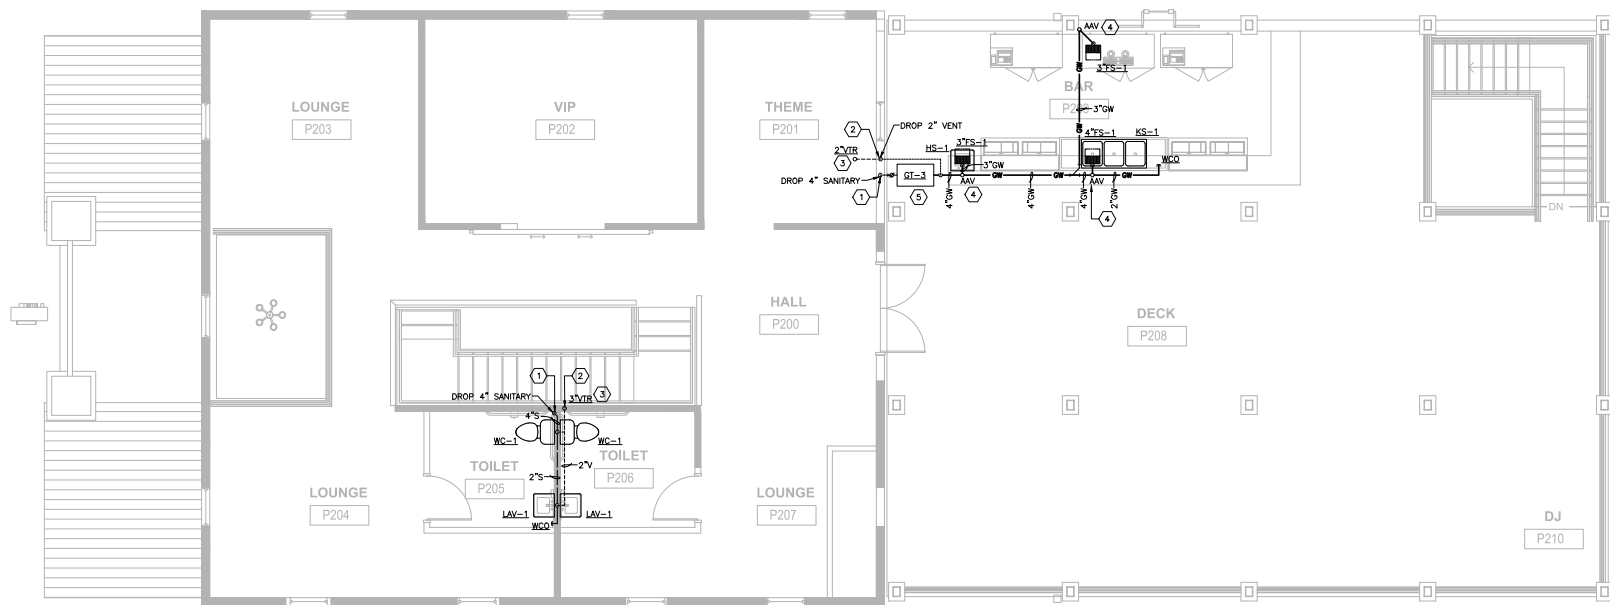

1 SECOND FLOOR WASTE AND VENT PLAN
1/4" = 1'-0"

KEYED NOTES:

- DROP SANITARY TO FIRST FLOOR. REFER TO P200 FOR CONTINUATION. REFER TO PLAN FOR SIZING.
- RISE VENT FROM FIRST FLOOR. REFER TO P200 FOR CONTINUATION. REFER TO PLAN FOR SIZING.
- VENT THROUGH ROOF, RE: 2/P001
- PROVIDE AIR ADMITTANCE VALVE EQUAL TO STUDOR MIN-VENT (#2034). PROVIDE ACCESS PANEL FOR MAINTENANCE WHEN LOCATED IN AN INACCESSIBLE WALL.
- RECESSED GREASE TRAP INSTALLED IN FLOOR. FOLLOW ALL MANUFACTURER'S RECOMMENDATIONS AND INSTALLATION INSTRUCTIONS. COORDINATE FINAL LOCATION WITH ARCHITECT PRIOR TO INSTALLATION.

Grease Interceptor Load Summary - (GT-3)				
Interceptor Standpipe = Volume (cu in) x 1 gal / 231 cu in				
Type of Fixture	Qty.	Volume (cu in)	Gallons	Total
3-Compartment Sink	1	6720	29	29
Flow Rate (gpm)			29	
+DW Flow Rate (gpm)			0	
Grease Interceptor Capacity (gpm)			29	



ARCHITECT	Above Ground Design, PLLC
200 Grooms Road	
Circle 4, Texas 78108	
MEPT	HMB Engineering
2002 N Flores Street	
San Antonio, Texas 78212	
STRUCTURAL	Hoffer Structural Solutions
948 Preston Road	
San Antonio, Texas 78256	
COPYRIGHT 2023	

BAR HOUSE, LLC
NEW BAR HOUSE

100 NORTH ALAMO STREET
SAN ANTONIO, TEXAS 78215
DESIGN DEVELOPMENT



KEY PLAN

PLAN
NORTH
TRUE
NORTH



CLIENT:
BAR HOUSE, LLC
PROJECT NUMBER:
23016
DATE: MARCH 10, 2023

REVISIONS		
No.	Description	Date


DESIGN DEVELOPMENT

SECOND FLOOR
WASTE AND
VENT PLAN

P201

CHECKED BY: Choder

DRAWN BY: Author

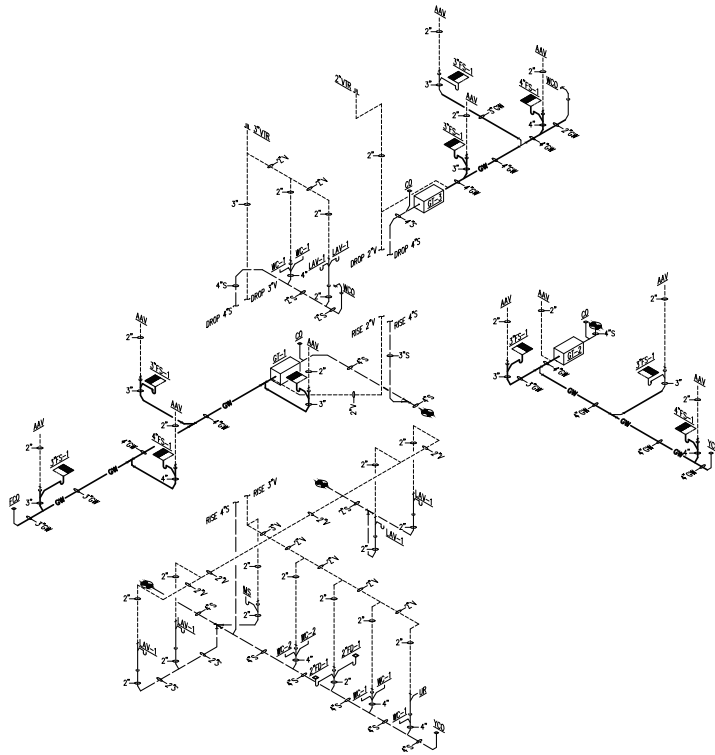

1 RISER - WASTE AND VENT


GENERAL NOTES: PLUMBING RISER

- WHEN NOT SHOWN ON PLANS, INDIVIDUAL FIXTURE CONNECTIONS SHALL BE SIZE AS SHOWN ON PLUMBING FIXTURE SCHEDULE.
- ISOMETRIC DIAGRAMS ARE FOR SIZING PURPOSES ONLY AND SHALL NOT BE USED FOR MATERIAL TAKE-OFFS, OR BE CONSTRUED TO INDICATE ACTUAL SITE INSTALLATION. CONTRACTOR SHALL COORDINATE EXACT LOCATIONS OF PIPING, FITTINGS AND EQUIPMENT WITH BUILDING ELEMENTS AND THE WORK OF OTHER TRADES.
- PROVIDE WATER HAMMER ARRESTORS FOR EACH GROUP OF FIXTURES WHETHER INDICATED OR NOT ON PLAN. PROVIDE ACCESS PANEL WHERE LOCATED IN INACCESSIBLE CEILING OR WALL.

SHOCK ARRESTOR SCHEDULE

P.D.L. SYMBOL	FIXTURE UNITS	SIZE
(A)	1-11	1/2" NPT
(B)	12-32	3/4" NPT
(C)	33-60	1" NPT
(D)	61-113	1 1/4" NPT
(E)	114-154	1 1/2" NPT
(F)	155-330	2" NPT

PIPING RISER DIAGRAMS ILLUSTRATE WATER HAMMER ARRESTORS AND AIR CHAMBERS FOR FUTURE WATER PIPE DRINKING. AIR CHAMBERS SHALL NOT BE USED TO REPLACE WATER HAMMER ARRESTORS. PROVIDE WATER HAMMER ARRESTORS FOR EACH GROUP OF FIXTURES WHETHER SHOWN OR NOT ON PLANS.

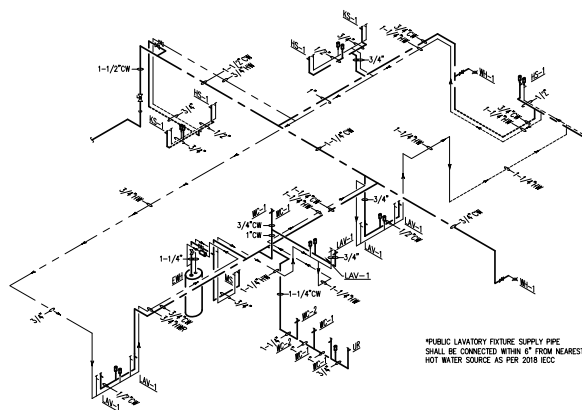

2 RISER - DOMESTIC WATER

PLUMBING FIXTURE & PIPE CONNECTION SCHEDULE

TAG	DESCRIPTION	BASIS OF DESIGN		CONNECTION SIZE					
				CM		TW		WASTE	
		MANUFACTURER	CATALOG NUMBER	INCHES	INCHES	INCHES	INCHES	INCHES	INCHES
WC-1	FLOOR MOUNTED WHITE V.C. ELONGATED BOWL TOILET, INCLUDED BOWL & TANK, PROVIDE ELONGATED OPEN FRONT LESS COVER SEAT. 2.28GPM COORDINATE WITH ARCHT. DWG FOR LEFT/RIGHT HAND TRIP LEVEL.	AMERICAN STANDARD	CADET 215CA-104	1/2"	-	-	-	4"	-
WC-2	FLOOR MOUNTED WHITE V.C. ELONGATED BOWL RIGHT HEIGHT TOILET, INCLUDED BOWL & TANK, PROVIDE ELONGATED OPEN FRONT LESS COVER SEAT. 2.28GPM ADA COORDINATE WITH ARCHT. DWG FOR LEFT/RIGHT HAND TRIP LEVEL.	AMERICAN STANDARD	CADET 215AA-105	1/2"	-	-	-	4"	-
LAV-1	WALL MOUNT V.C. 20-1/2" X 18-1/4" LAVATORY SINK 4" CENTERSET HOSE, PROVIDE SUPPORT SYSTEM WITH CONCEALED ARM 8" TURN 1/251 OR SIMILAR. TWO HANDLE CHROME PLATED FAUCET 6.5GPM	AMERICAN STANDARD	"LUCKY" 5555.012 MODEN "N-BRUSH" BRASS	1/2"	1/2"	1/2"	2"	-	2"
KS-1	FREESTANDING 16 GA. 304 S.S. 3 COMPARTMENT SINK WITH TWO DRAINBOARDS. PROVIDE TWO HANDLE CHROME PLATED SINKING ARM FAUCET.	ADVANCE TAPCO	FC-1-2315-20MLX 8-2315-08	1/2"	1/2"	-	-	2"	-
KS-2	FREESTANDING 16 GA. 304 S.S. 2 COMPARTMENT SINK, PROVIDE TWO HANDLE CHROME PLATED SINKING ARM FAUCET.	ADVANCE TAPCO	FC-2-2820 8-2315-08	1/2"	1/2"	-	-	2"	-
HS-1	WALL MOUNTED 20 GA. 304 S.S. HAND SINK WITH WHITE/BLACK GOODRICH FAUCET. 2.28GPM	REGENCY	800HS17W9K	1/2"	1/2"	-	-	3-1/2"	-
TP-1	FRAMING WATER SAVER TRAP PRIMER, SUP	J.B. SMITH	2896	1/2"	-	-	-	-	-
FD-1	CAST IRON WITH 6" DIAMETER TYPE "B" STRAINER.	ZURN	40-435	-	-	-	-	SEE PLAN	2"
GT-1	30"x38"x13" EPOXY COATED STEEL, POX CERTIFIED, RECESSED GRASE INTERCEPTOR AT 35 GPM FLOW RATE.	WATTS	WD-35	-	-	-	-	4"	-
GT-2	21 5/8"x14"x12" EPOXY COATED STEEL, POX CERTIFIED, RECESSED GRASE INTERCEPTOR AT 10 GPM FLOW RATE.	WATTS	WD-10	-	-	-	-	4"	-
GT-3	30"x38"x13" EPOXY COATED STEEL, POX CERTIFIED, RECESSED GRASE INTERCEPTOR AT 35 GPM FLOW RATE.	WATTS	WD-35	-	-	-	-	4"	-
TMV	ADJUSTABLE THERMOSTATIC POWER-OF-USE MIXING VALVE WITH PRES. CHECK STOPS CONFORMANT TO ASSE 2075. MAX HOT WATER TEMP. UNIT OF 120° SET TO 105°.	LEGIONARD	1750-UP	1/2"	1/2"	1/2"	-	-	-
WH-1	FREEDLESS WALL MOUNTED W/ AUTOMATIC DRAINING, HOSE CONNECTION BACKFLOW PROTECTION AND INTEGRAL LOCKING HEAD COVER.	WOODFORD MFG.	M40 68	3/8"	-	-	-	-	-
MS	FLOOR SINK 24X24X12 16 WALL MOUNT FAUCET WITH INTEGRAL STOPS, WALL BRACE AND VACUUM BREAKER. PROVIDE 1-1/2" HOSE AND WALL BRACKET AND 1-1/2" STAINLESS STEEL HOSE HAMMER	FIAT	TSR 500 CHICAGO FAUCET No. 807-ACE	3/4"	3/4"	-	-	2"	2"
FS EQUIPMENT	PROVIDE ROUGH-IN AS REQUIRED FOR ALL FIXTURES AND EQUIPMENT PROVIDED BY EQUIPMENT SUPPLIERS AND/OR OWNER. PROVIDE ALL MATERIALS AND LABOR TO INSTALL AND MAKE FINAL CONNECTIONS TO ALL EQUIPMENT. ALL CONNECTIONS FOR EQUIPMENT TO BE IN ACCORDING WITH APPLICABLE SECTIONS OF HEALTH DEPARTMENT AND PLUMBING CODES.								

NOTES:
1. COORDINATE ALL PLUMBING FIXTURE COLORS & FINISHES WITH ARCHITECT.

RECYCLING PUMP SCHEDULE

MARK	SERVICE	GPM	TOTAL HEAD FT.	MOTOR HP	ELECTRICAL	REMARKS
CP-1	WATER RECYCLATION	2	12	0.115	115 1 60	GRINDER/UP 15-18 BUCK W/AQUASTAT + TIMER

ELECTRIC WATER HEATER SCHEDULE

MARK	RECOVERY		STORAGE GALLONS	LEAVING HW TEMP	INPUT		MODEL
	GPH	RISE F			KW	VOLT/PH	
FWH	70	80"	80	140°	13.5	208/3Ø	A.O. SMITH MODEL No. DRE-80-13.5

- NOTES:
1. PROVIDE EXPANSION TANK WATTS PCT-5 OR SIMILAR.
2. VACUUM RELIEF VALVE SHALL CONFORM WITH ANSI Z21.22.
3. T&P RELIEF VALVE SHALL CONFORM WITH ANSI Z21.22.

*PUBLIC LAVATORY FIXTURE SUPPLY PIPE SHALL BE CONNECTED WITHIN 6" FROM NEAREST HOT WATER SOURCE AS PER 2018 ICC

HMB
ENGINEERING
CONSULTANTS

2902 NORTH FLORES
SAN ANTONIO, TEXAS 78212
210.393.1840 PHONE
SAN ANTONIO - REG.
TYPE "B" REGISTRATION NO. 13241



ARCHITECT Above Ground Design, PLLC
200 Grooms Road
Cocke, Texas 79108
MEPT HMB Engineering
2802 N. Flores Street
San Antonio, Texas 78212
STRUCTURAL Hoffer Structural Solutions
948 Prolon Road
San Antonio, Texas 78256
COPYRIGHT 2023

BAR HOUSE, LLC
NEW BAR HOUSE

100 NORTH ALAMO STREET
SAN ANTONIO, TEXAS 78203
DESIGN DEVELOPMENT



KEY PLAN
PLAN NORTH
TRUE NORTH



CLIENT
BAR HOUSE, LLC
PROJECT NUMBER
23016
DATE MARCH 10, 2023
REVISIONS
No. Description Date
DESIGN DEVELOPMENT

PLUMBING RISERS
& SCHEDULES

P300